

FEE \$10.00

PERMIT # 14672

FENCE PERMIT
GRAND JUNCTION COMMUNITY DEVELOPMENT DEPARTMENT

Property Address: 245 Jacob Way
Property Tax No: 2945-293-25-006
Subdivision: Crista Lee
Property Owner: Cathy Hren
Owner's Telephone:
Owner's Address: 245 Jacob way GJ. CO. 81503
Contractor's Name: Medina's Landscaping
Contractor's Telephone: (970) 245-2410
Contractor's Address: 235-1/2 28-1/2 Road G.J. CO. 81503
Fence Material & Height: Vinyl Fence 6' High

Plot plan must show property lines and property dimensions, all easements, all rights-of-way, all structures, all setbacks from property lines, and fence height(s). NOTE: Property line is likely one foot or more behind the sidewalk.

THIS SECTION TO BE COMPLETED BY COMMUNITY DEVELOPMENT DEPARTMENT STAFF
ZONE RSF-4
SPECIAL CONDITIONS
SETBACKS: Front from property line (PL) or from center of ROW, whichever is greater.
Side from PL Rear from PL

Fences exceeding six feet in height require a separate permit from the City/County Building Department. A fence constructed on a corner lot that extends past the rear of the house along the side yard or abuts an alley requires approval from the City Engineer (Section 4.1.J of the Grand Junction Zoning and Development Code).

The owner/applicant must correctly identify all property lines, easements, and rights-of-way and ensure the fence is located within the property's boundaries. Covenants, conditions, restrictions, easements and/or rights-of-way may restrict or prohibit the placement of fence(s). The owner/applicant is responsible for compliance with covenants, conditions, and restrictions which may apply. Fences built in easements may be subject to removal at the property owner's sole and absolute expense. Any modification of design and/or material as approved in this fence permit must be approved, in writing, by the Community Development Department Director.



I hereby acknowledge that I have read this application and the information and plot plan are correct; I agree to comply with any and all codes, ordinances, laws, regulations, or restrictions which apply. I understand that failure to comply shall result in legal action, which may include but not necessarily be limited to removal of the fence(s) at the owner's cost.

Applicant's Signature [Signature] Date 8-11-05
Community Development's Approval [Signature] Date 8-11-05
City Engineer's Approval (if required) Date

VALID FOR SIX MONTHS FROM DATE OF ISSUANCE (Section 2.2.E.1.d Grand Junction Zoning & Development Code)
(White: Planning) (Yellow: Customer) (Pink: Code Enforcement)

245 Jacob Way
 Grand Jct., CO 81503

IMPROVEMENT LOCATION CERTIFICATE

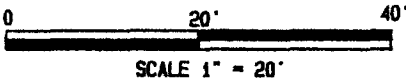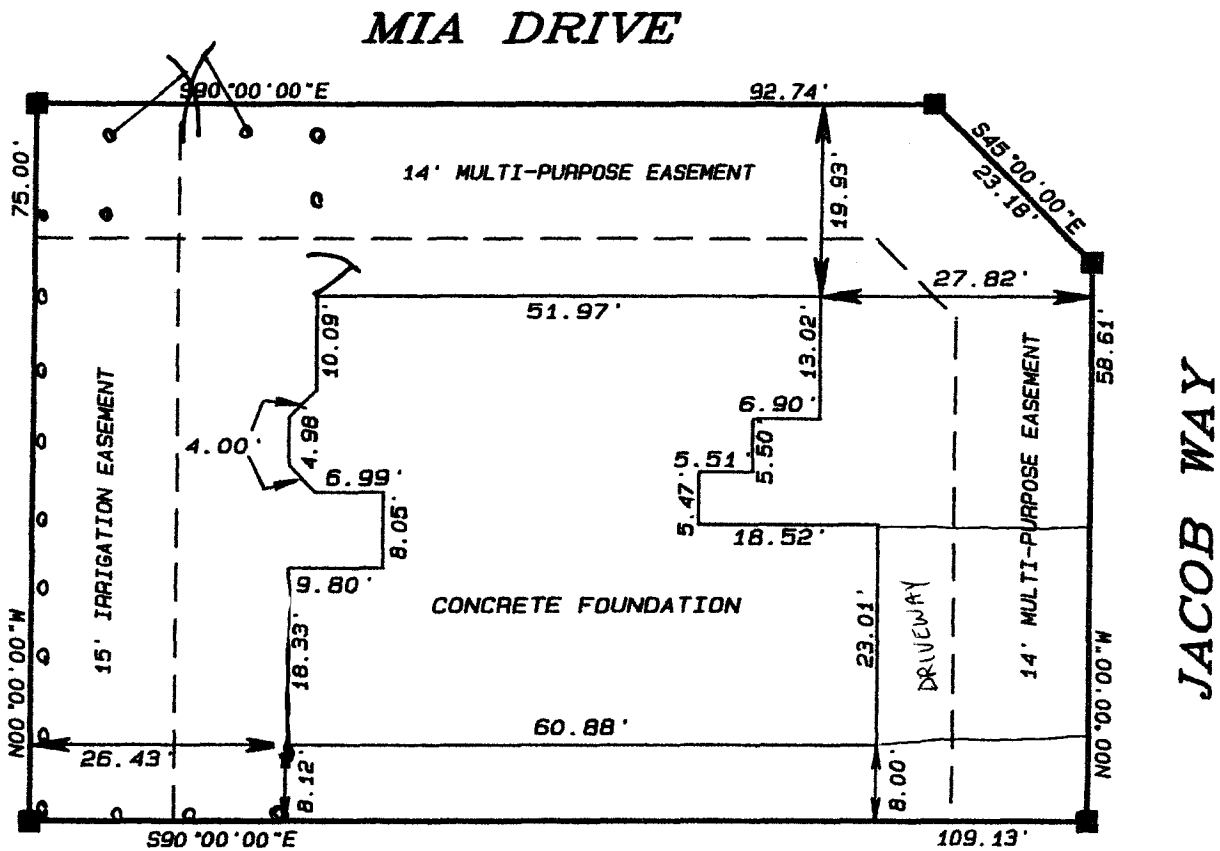

PROPERTY DESCRIPTION: Lot 6, Block FOUR,
 Crista Lee Subdivision
 City of Grand Junction, Mesa County Colorado.
 245 Jacob Way

■ = Found Pin and Cap
 "LS 19597"

NOTE: THE STRUCTURE LOCATION MEETS
 CITY OF GRAND JUNCTION SET-BACK REQUIREMENTS
 AND CITY APPROVED SITE PLAN.

I hereby certify that this improvement location certificate was