

FEE \$10.00

PERMIT # 13747

FENCE PERMIT
GRAND JUNCTION COMMUNITY DEVELOPMENT DEPARTMENT

Property Address: 567 25 1/2 Rd
Property Tax No: 2945-102-16-972
Subdivision: Minerva Park
Property Owner: Grand Jct Lodge No. 270 Royal Order of Moose
Owner's Telephone:
Owner's Address: 567 25 1/2 Rd
Contractor's Name: Taylor Fence
Contractor's Telephone: 1241-1473
Contractor's Address: 832 21-1/2 Rd
Fence Material & Height: 3 1/2' high 3 rail white vinyl fence

Plot plan must show property lines and property dimensions, all easements, all rights-of-way, all structures, all setbacks from property lines, and fence height(s). NOTE: Property line is likely one foot or more behind the sidewalk.

THIS SECTION TO BE COMPLETED BY COMMUNITY DEVELOPMENT DEPARTMENT STAFF
ZONE C-2
SPECIAL CONDITIONS
SETBACKS: Front from property line (PL) or from center of ROW, whichever is greater. Side from PL Rear from PL


Fences exceeding six feet in height require a separate permit from the City/County Building Department. A fence constructed on a corner lot that extends past the rear of the house along the side yard or abuts an alley requires approval from the City Engineer (Section 4.1.J of the Grand Junction Zoning and Development Code).

The owner/applicant must correctly identify all property lines, easements, and rights-of-way and ensure the fence is located within the property's boundaries. Covenants, conditions, restrictions, easements and/or rights-of-way may restrict or prohibit the placement of fence(s). The owner/applicant is responsible for compliance with covenants, conditions, and restrictions which may apply. Fences built in easements may be subject to removal at the property owner's sole and absolute expense. Any modification of design and/or material as approved in this fence permit must be approved, in writing, by the Community Development Department Director.

I hereby acknowledge that I have read this application and the information and plot plan are correct; I agree to comply with any and all codes, ordinances, laws, regulations, or restrictions which apply. I understand that failure to comply shall result in legal action, which may include but not necessarily be limited to removal of the fence(s) at the owner's cost.

Applicant's Signature Mike Curtis Date 5/19/2005
Community Development's Approval Gayleen Henderson Date 5-19-05
City Engineer's Approval (if required) Date

VALID FOR SIX MONTHS FROM DATE OF ISSUANCE (Section 2.2.E.1.d Grand Junction Zoning & Development Code)
(White: Planning) (Yellow: Customer) (Pink: Code Enforcement)

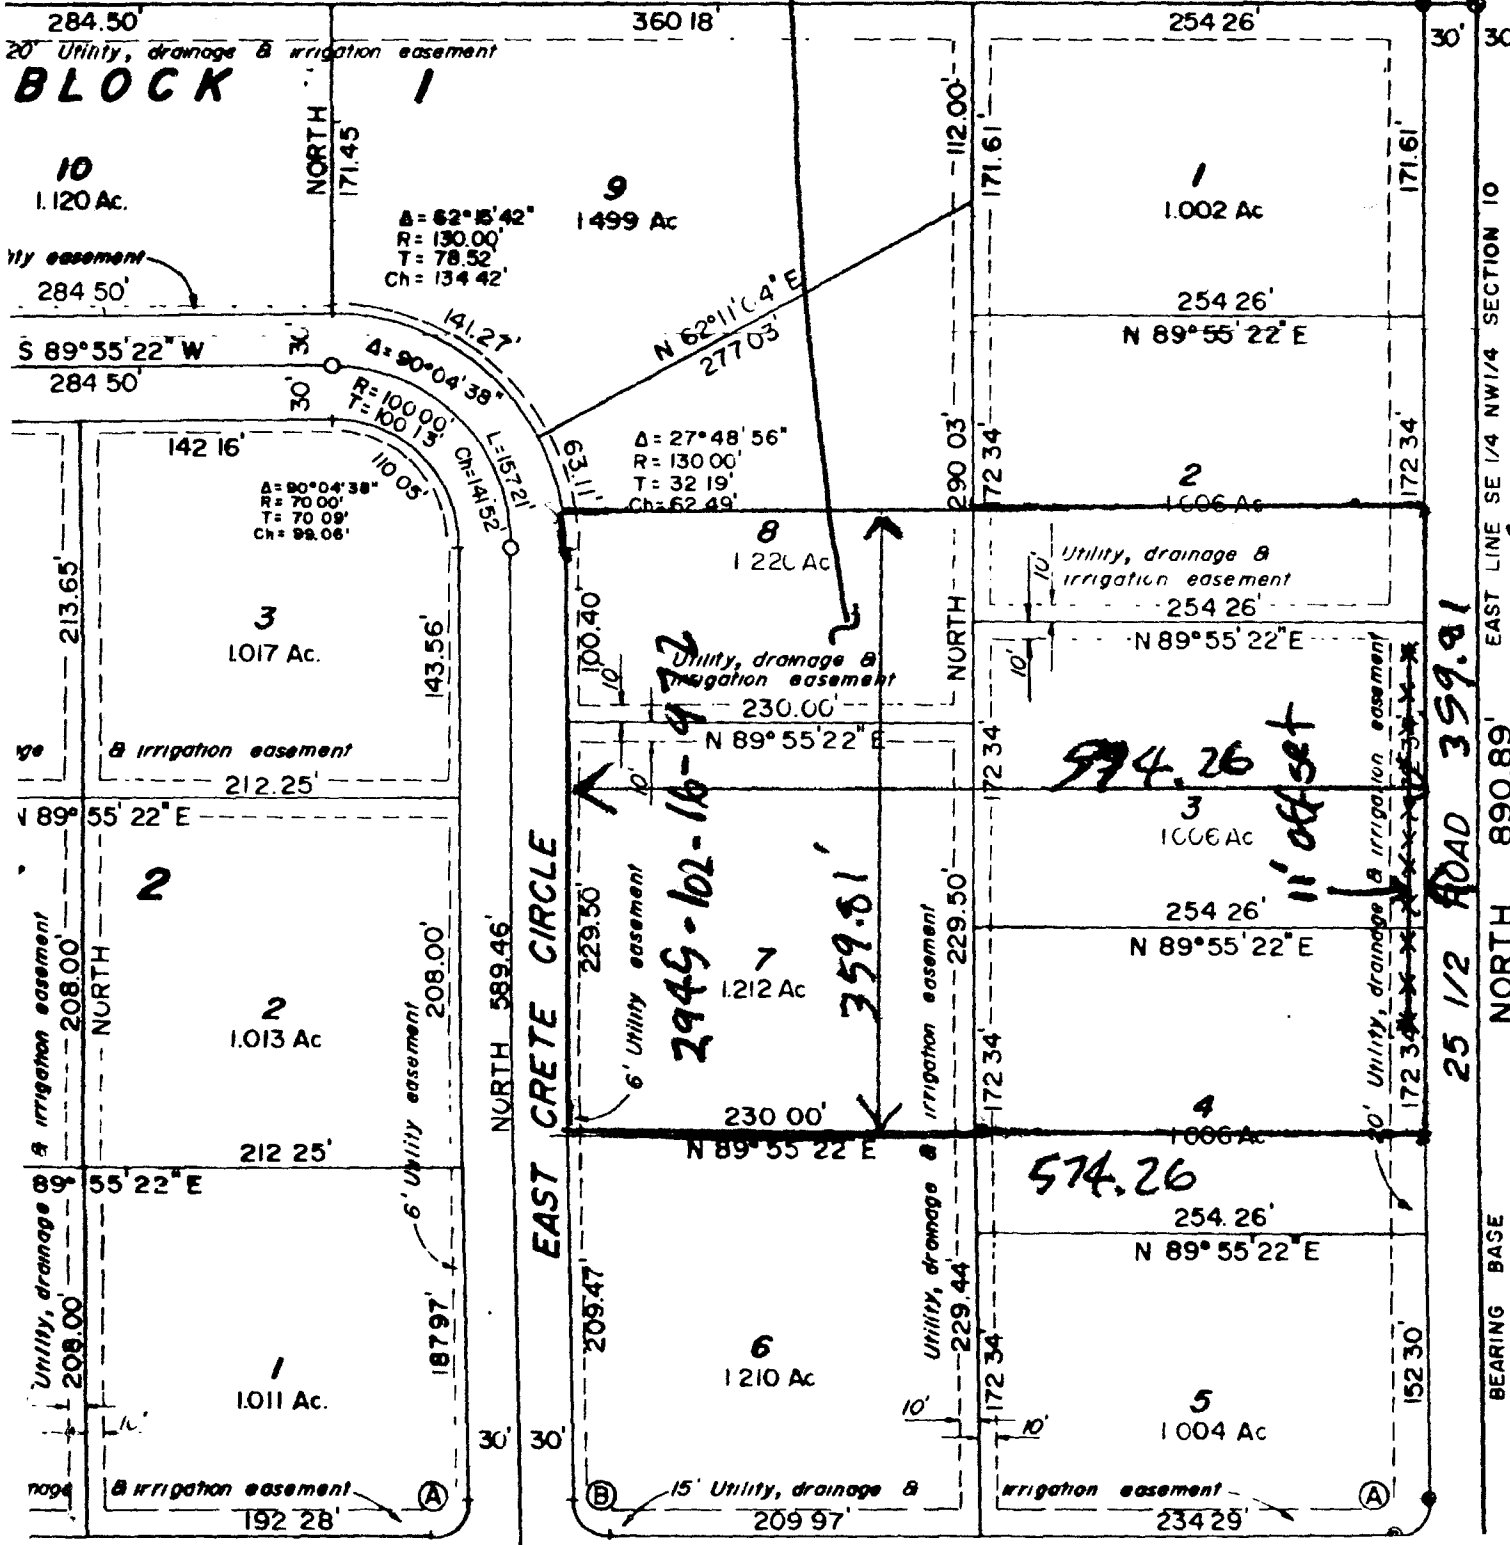

Beginning at a p
NW 1/4 said Sect
891.25 feet; then
Containing 26.94
County Records.

That the said own
County, Colorado.

That said owners
and public utilitie
on the accompanyi
irrigation facilities,
interfering trees
Said easement a

That all expense

In witness whereof
and Christine F.

Judree
Andr

STATE OF COLORA

COUNTY OF MESA
The foregoing instr.
Emanuel G Pavlat
My commision exp

COUNTY PL.