

FEE \$10.00

ⓐ

PERMIT # 13672

FENCE PERMIT
GRAND JUNCTION COMMUNITY DEVELOPMENT DEPARTMENT

Property Address: 651 Spring Brook Dr.

Property Tax No: 2943-051-75-001

Subdivision: Brookside

Property Owner: Manager Martin Krakowski

Owner's Telephone: 245-3939

Owner's Address:

Contractor's Name: Brian Phelps Specialized Service + Repair

Contractor's Telephone: 972 261 8934

Contractor's Address: 427

Fence Material & Height: cedar 5'6" lattice top on S side, 6' on rear property line

Plot plan must show property lines and property dimensions, all easements, all rights-of-way, all structures, all setbacks from property lines, and fence height(s). NOTE: Property line is likely one foot or more behind the sidewalk.

THIS SECTION TO BE COMPLETED BY COMMUNITY DEVELOPMENT DEPARTMENT STAFF

ZONE PD SETBACKS: Front from property line (PL) or

SPECIAL CONDITIONS Fence restrictions from center of ROW, whichever is greater.

require 4'6" solid w/ 1' lattice Side from PL Rear from PL

Fences exceeding six feet in height require a separate permit from the City/County Building Department. A fence constructed on a corner lot that extends past the rear of the house along the side yard or abuts an alley requires approval from the City Engineer (Section 4.1.J of the Grand Junction Zoning and Development Code).

The owner/applicant must correctly identify all property lines, easements, and rights-of-way and ensure the fence is located within the property's boundaries. Covenants, conditions, restrictions, easements and/or rights-of-way may restrict or prohibit the placement of fence(s). The owner/applicant is responsible for compliance with covenants, conditions, and restrictions which may apply. Fences built in easements may be subject to removal at the property owner's sole and absolute expense. Any modification of design and/or material as approved in this fence permit must be approved, in writing, by the Community Development Department Director.

I hereby acknowledge that I have read this application and the information and plot plan are correct; I agree to comply with any and all codes, ordinances, laws, regulations, or restrictions which apply. I understand that failure to comply shall result in legal action, which may include but not necessarily be limited to removal of the fence(s) at the owner's cost.

Applicant's Signature B. E. Phelps

Date 4-20-05

Community Development's Approval City Engineer

Date 4/26/05

City Engineer's Approval (if required)

Date


VALID FOR SIX MONTHS FROM DATE OF ISSUANCE (Section 2.2.E.1.d Grand Junction Zoning & Development Code)

(White: Planning) (Yellow: Customer) (Pink: Code Enforcement)

N



u/12/02  
OK as noted  
5' MINIMUM FROM PROP LINE

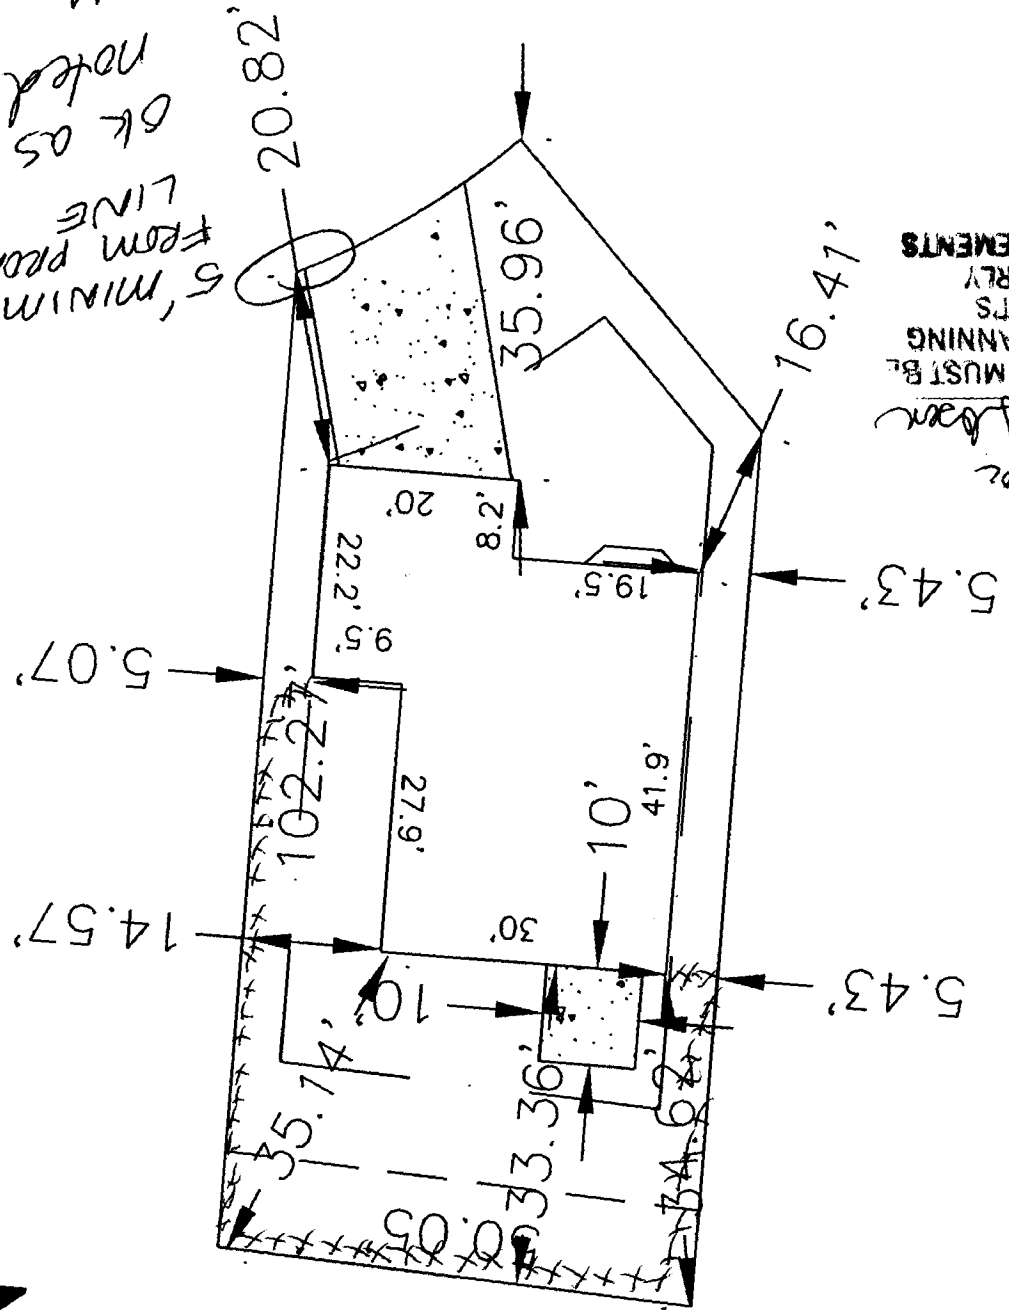

ACCEPTED  
11/13/02  
P. Hwy. A. Green  
ANY CHANGE OF SETBACKS MUST BE APPROVED BY THE CITY PLANNING DEPARTMENT AS THE APPLICANTS RESPONSIBILITY TO PROPERLY LOCATE AND IDENTIFY EASEMENTS AND PROPERTY LINES

651 Springbrook Dr.  
lot 1 blk 5  
scale: 1=20