

FEE \$10.00

PERMIT # 14796

FENCE PERMIT
GRAND JUNCTION COMMUNITY DEVELOPMENT DEPARTMENT

Property Address: 679 TAHOE CIRCLE
Property Tax No: 2945-031-69-008
Subdivision: VALLEY MEADOWS NORTH
Property Owner: DON ROBERTS
Owner's Telephone: 970 263-4616
Owner's Address: 679 TAHOE CIRCLE
Contractor's Name: OWNER
Contractor's Telephone: 970 263-4616
Contractor's Address:
Fence Material & Height: 1" x 6" x 6' CEDAR 6'

Plot plan must show property lines and property dimensions, all easements, all rights-of-way, all structures, all setbacks from property lines, and fence height(s). NOTE: Property line is likely one foot or more behind the sidewalk.

THIS SECTION TO BE COMPLETED BY COMMUNITY DEVELOPMENT DEPARTMENT STAFF

ZONE RSF-4
SPECIAL CONDITIONS
SETBACKS: Front from property line (PL) or from center of ROW, whichever is greater.
Side from PL Rear from PL

Fences exceeding six feet in height require a separate permit from the City/County Building Department. A fence constructed on a corner lot that extends past the rear of the house along the side yard or abuts an alley requires approval from the City Engineer (Section 4.1.J of the Grand Junction Zoning and Development Code).

The owner/applicant must correctly identify all property lines, easements, and rights-of-way and ensure the fence is located within the property's boundaries. Covenants, conditions, restrictions, easements and/or rights-of-way may restrict or prohibit the placement of fence(s). The owner/applicant is responsible for compliance with covenants, conditions, and restrictions which may apply. Fences built in easements may be subject to removal at the property owner's sole and absolute expense. Any modification of design and/or material as approved in this fence permit must be approved, in writing, by the Community Development Department Director.

I hereby acknowledge that I have read this application and the information and plot plan are correct; I agree to comply with any and all codes, ordinances, laws, regulations, or restrictions which apply. I understand that failure to comply shall result in legal action, which may include but not necessarily be limited to removal of the fence(s) at the owner's cost.

Applicant's Signature

Date 11/16/05

Community Development's Approval Gayleen Henderson

Date 11-16-05

City Engineer's Approval (if required)

Date

VALID FOR SIX MONTHS FROM DATE OF ISSUANCE (Section 2.2.E.1.d Grand Junction Zoning & Development Code)

(White: Planning)

(Yellow: Customer)

(Pink: Code Enforcement)


OTHER SIDE NOTES
 D EASEMENTS
 SEE SEPARATE DRAWINGS BY OTHERS

~~XXXX~~ = EXISTING FENCE

XXXX = NEW FENCE


1" x 6" x 6' DOG EARED RED CEDAR PLANKS
 4" x 4" x 8' CEDAR POSTS

← 27' →

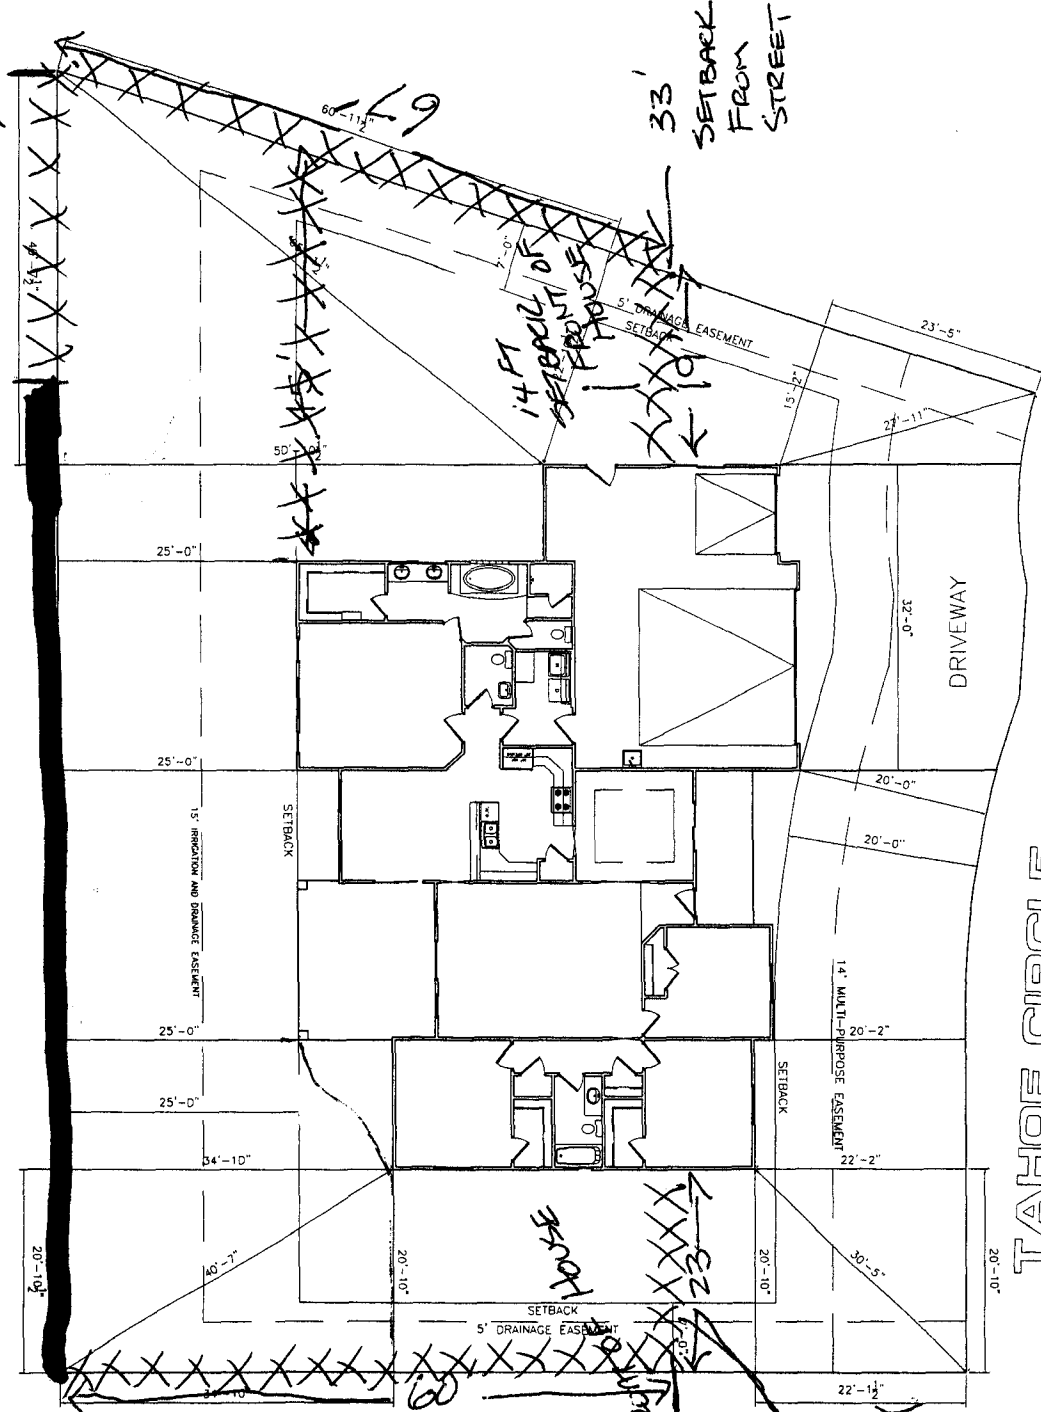

SCALE: 1" = 20'-0"

679 TAHOE CIR.
 FENCE DESIGN
 FOR
 ACC APPROVAL

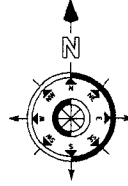

NOTE:
 GRADE MUST SLOPE AWAY FROM HOUSE 6" OF FALL IN THE FIRST 10' OF DISTANCE PER LOCAL BUILDING CODE.

NOTE:
 DIMENSION LINES ARE PULLED FROM EDGE OF BRICK LEDGE, IF NO BRICK LEDGE EXISTS, DIMENSIONS WILL BE FROM EDGE OF FOUNDATION.

NOTE:
 BUILDER TO VERIFY ALL SETBACK AND EASEMENT ENCROACHMENTS PRIOR TO CONSTRUCTION

SITE PLAN INFORMATION	
SUBDIVISION NAME	VALLEY MEADOWS NORTH
FILING NUMBER	1
BLOCK NUMBER	2
LOT NUMBER	8
STREET ADDRESS	679 TAHOE CIRCLE
COUNTY	MESA
GARAGE SQ. FT.	767 SF
LIVING SQ. FT.	2141 SF
LOT SIZE	11,629 SF
SETBACKS USED	FRONT 20' SIDES 7' REAR 25'

TAHOE CIRCLE

800-69-130-5468