

FEE \$10.00

PERMIT # 1597



FENCE PERMIT
GRAND JUNCTION COMMUNITY DEVELOPMENT DEPARTMENT

THIS SECTION TO BE COMPLETED BY APPLICANT

PROPERTY ADDRESS: 2180 Standing Rock
PROPERTY TAX NO: 2947-351-24-010
SUBDIVISION: Canyon View - Phase 7
PROPERTY OWNER: Mike Jacob
OWNER'S PHONE: 257-9274
OWNER'S ADDRESS: 2180 Standing Rock Dr
CONTRACTOR NAME: Maranatha Fencing
CONTRACTOR'S PHONE: 241-9303
CONTRACTOR'S ADDRESS: P.O. 9220
FENCE MATERIAL & HEIGHT: Cedar 4' 1/2 spacing
Plot plan must show property lines and property dimensions, all easements, all rights-of-way, all structures, all setbacks from property lines, & fence height(s). NOTE: PROPERTY LINE IS LIKELY ONE FOOT OR MORE BEHIND THE SIDEWALK.

THIS SECTION TO BE COMPLETED BY COMMUNITY DEVELOPMENT DEPARTMENT STAFF

ZONE PD
SETBACKS: Front from property line (PL) or
SPECIAL CONDITIONS
Side from PL Rear from PL

Fences exceeding six feet in height require a separate permit from the City/County Building Department. A fence constructed on a corner lot that extends past the rear of the house along the side yard or abuts an alley requires approval from the City Engineer (Section 4.1.J of the Grand Junction Zoning and Development Code).

The owner/applicant must correctly identify all property lines, easements, and rights-of-way and ensure the fence is located within the property's boundaries. Covenants, conditions, restrictions, easements and/or rights-of-way may restrict or prohibit the placement of fence(s). The owner/applicant is responsible for compliance with covenants, conditions, and restrictions which may apply. Fences built in easements may be subject to removal at the property owner's sole and absolute expense. Any modification of design and/or material as approved in this fence permit must be approved, in writing, by the Community Development Department Director.


I hereby acknowledge that I have read this application and the information and plot plan are correct; I agree to comply with any and all codes, ordinances, laws, regulations or restrictions which apply. I understand that failure to comply shall result in legal action, which may include but not necessarily be limited to removal of the fence(s) at the owner's cost.

Applicant's Signature [Signature] Date 10-5-05
Community Development's Approval [Signature] Date 10-5-05
City Engineer's Approval (if required) Date

VALID FOR SIX MONTHS FROM DATE OF ISSUANCE (Section 2.2.E.1.d Grand Junction Zoning & Development Code)
(White: Planning) (Yellow: Customer) (Pink: Code Enforcement)

RESPONSIBILITY OF THE BUILDER OR OWNER TO VERIFY DETAILS
 EVIDENCE PRIOR TO CONSTRUCTION.

CANYON VIEW PHASE VII
 BLOCK 1 - LOT 10

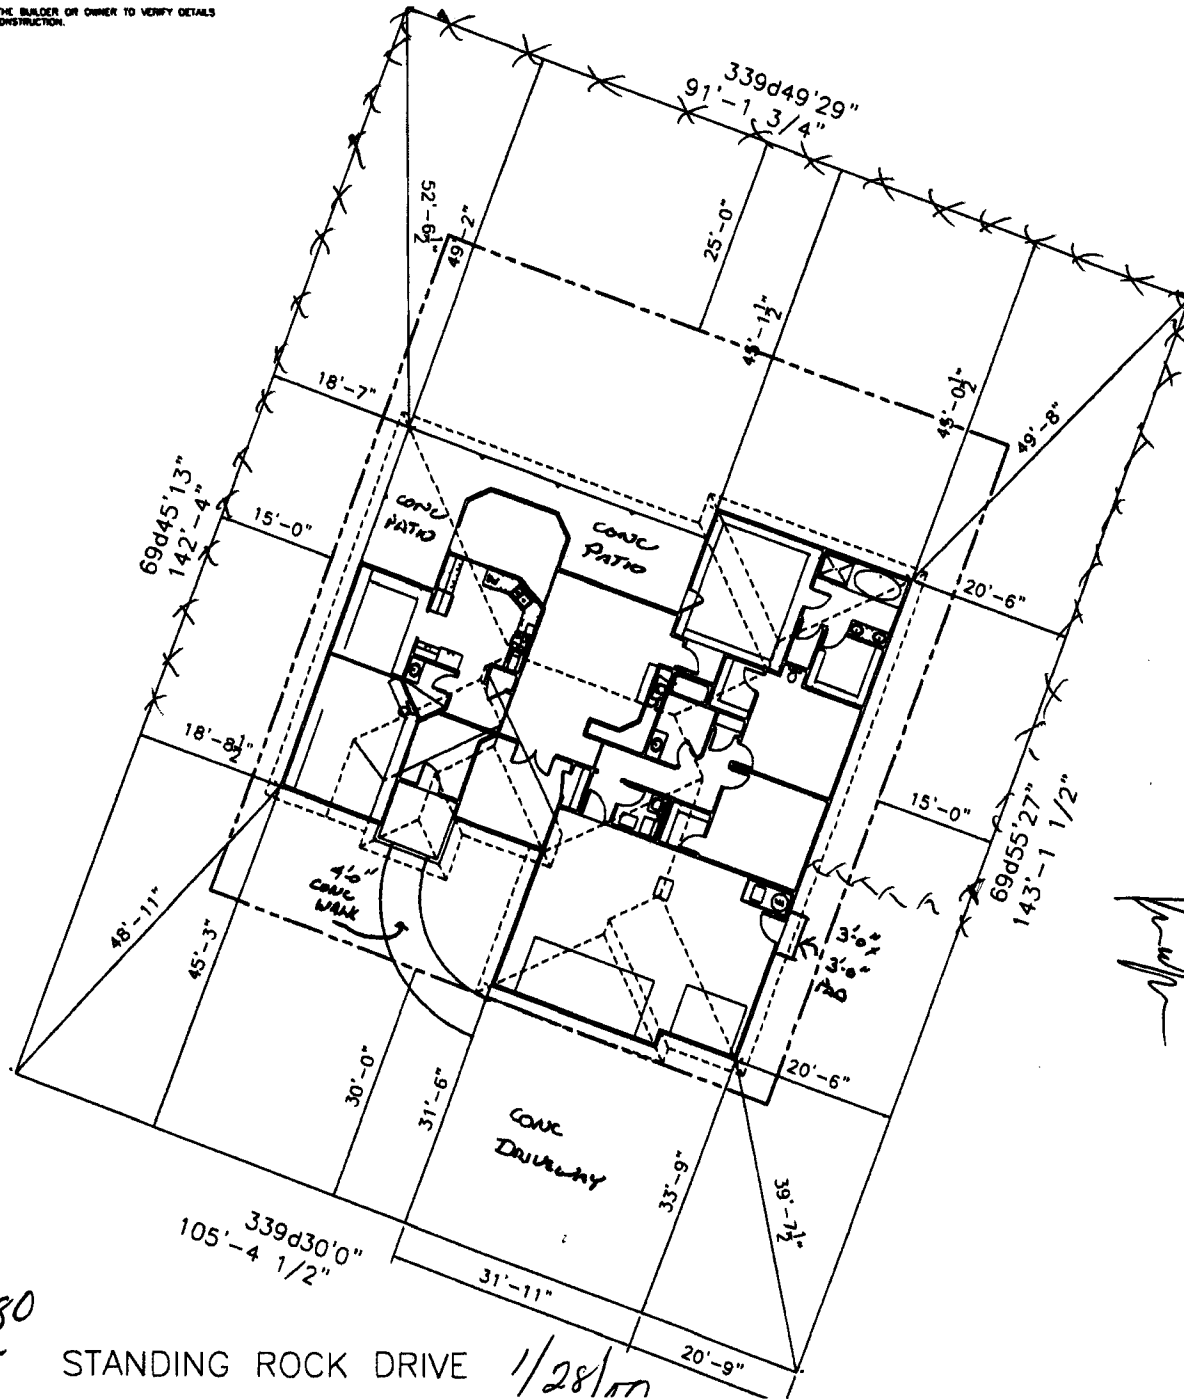

ACCEPTED
 ANY CHANGE OF SETBACKS MUST BE
 APPROVED BY THE CITY PLANNING
 DEPT. IT IS THE APPLICANT'S
 RESPONSIBILITY TO PROPERLY
 LOCATE AND IDENTIFY EASEMENTS
 AND PROPERTY LINES.

SIC 1/25/00

[Signature]

1/24/00
 DRAWN O.K.

2180
~~2178~~ STANDING ROCK DRIVE 1/28/00