

FEE \$10.00

2

PERMIT # 13541

FENCE PERMIT
GRAND JUNCTION COMMUNITY DEVELOPMENT DEPARTMENT

Property Address: 3008 Big Bird Ave GJ CO 81504
Property Tax No: 2943-102-08-005
Subdivision: Grand Meadows
Property Owner: Michael W Sisson
Owner's Telephone: 434-9522
Owner's Address: 3008 Big Bird Ave 81504
Contractor's Name:
Contractor's Telephone:
Contractor's Address:
Fence Material & Height: 6' Cedar Fence

THIS SECTION TO BE COMPLETED BY COMMUNITY DEVELOPMENT DEPARTMENT STAFF
ZONE RMF-5
SPECIAL CONDITIONS
SETBACKS: Front 20' from property line (PL) or from center of ROW, whichever is greater.
Side 0' from PL Rear 0' from PL

Fences exceeding six feet in height require a separate permit from the City/County Building Department. A fence constructed on a corner lot that extends past the rear of the house along the side yard or abuts an alley requires approval from the City Engineer (Section 4.1.J of the Grand Junction Zoning and Development Code).


The owner/applicant must correctly identify all property lines, easements, and rights-of-way and ensure the fence is located within the property's boundaries. Covenants, conditions, restrictions, easements and/or rights-of-way may restrict or prohibit the placement of fence(s). The owner/applicant is responsible for compliance with covenants, conditions, and restrictions which may apply. Fences built in easements may be subject to removal at the property owner's sole and absolute expense. Any modification of design and/or material as approved in this fence permit must be approved, in writing, by the Community Development Department Director.

I hereby acknowledge that I have read this application and the information and plot plan are correct; I agree to comply with any and all codes, ordinances, laws, regulations, or restrictions which apply. I understand that failure to comply shall result in legal action, which may include but not necessarily be limited to removal of the fence(s) at the owner's cost.

Applicant's Signature [Signature] Date Feb 4, 2005
Community Development's Approval [Signature] Date 3/4/05
City Engineer's Approval (if required) Date

VALID FOR SIX MONTHS FROM DATE OF ISSUANCE (Section 2.2.E.1.d Grand Junction Zoning & Development Code)
(White: Planning) (Yellow: Customer) (Pink: Code Enforcement)

9/27/04
w
one
drive

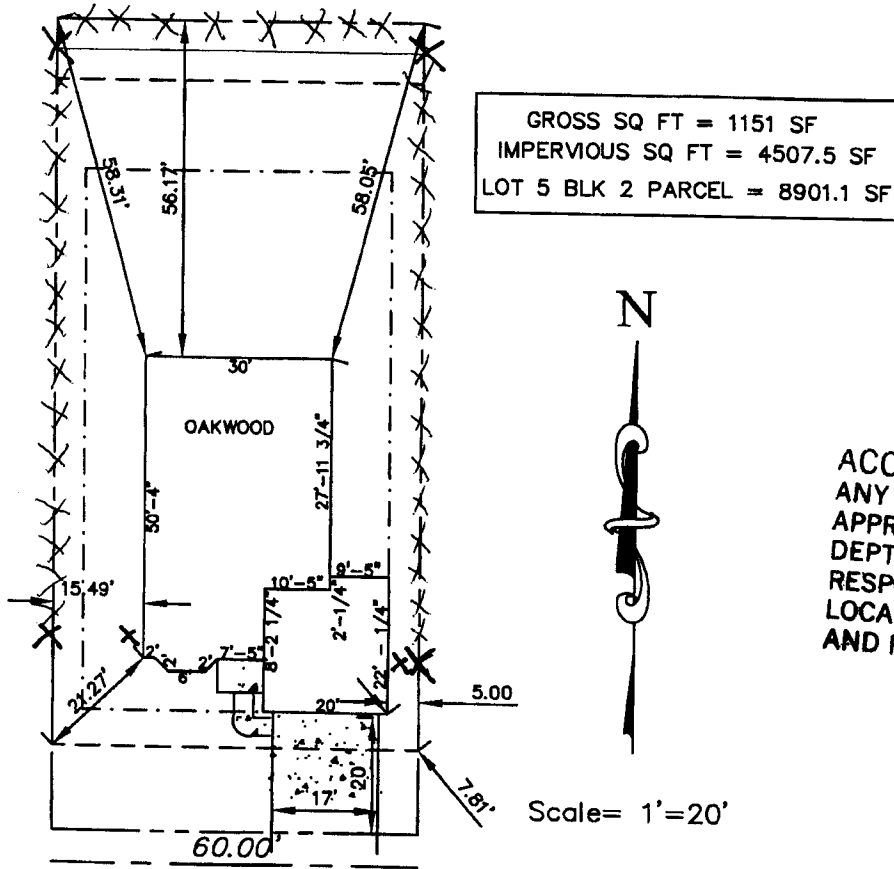

GROSS SQ FT = 1151 SF
IMPERVIOUS SQ FT = 4507.5 SF
LOT 5 BLK 2 PARCEL = 8901.1 SF



Scale = 1' = 20'

ACCEPTED *10/29/04 Jay Hall*
ANY CHANGE OF SETBACKS MUST BE APPROVED BY THE CITY PLANNING DEPT. IT IS THE APPLICANT'S RESPONSIBILITY TO PROPERLY LOCATE AND IDENTIFY EASEMENTS AND PROPERTY LINES.

BIG BIRD AVENUE
GRAND MEADOWS-SO SUBDIVISION
3008 BIG BIRD AVE
Lot 5 Block 2
27-AUG-04
20-SEPT-04