

FEE \$10.00

PERMIT #

14325

FENCE PERMIT

GRAND JUNCTION COMMUNITY DEVELOPMENT DEPARTMENT

Property Address: 587 1/2 281 1/2 Rd, LJS 81501
 Property Tax No: 2943-072-18-077
 Subdivision: The Falls
 Property Owner: Barry Weitzel
 Owner's Telephone: 260-3004
 Owner's Address: 587 1/2 281 1/2 Rd, LJS 81501
 Contractor's Name: Barry Weitzel
 Contractor's Telephone: 260-3004
 Contractor's Address: Same as above
 Fence Material & Height: 6' - Cedar

Plot plan must show property lines and property dimensions, all easements, all rights-of-way, all structures, all setbacks from property lines, and fence height(s). NOTE: Property line is likely one foot or more behind the sidewalk.

THIS SECTION TO BE COMPLETED BY COMMUNITY DEVELOPMENT DEPARTMENT STAFF

ZONE PD SETBACKS: Front 20' from property line (PL) or
 SPECIAL CONDITIONS _____ from center of ROW, whichever is greater.
 Side 0' from PL Rear 0' from PL

Fences exceeding six feet in height require a separate permit from the City/County Building Department. A fence constructed on a corner lot that extends past the rear of the house along the side yard or abuts an alley requires approval from the City Engineer (Section 4.1.J of the Grand Junction Zoning and Development Code).

The owner/applicant must correctly identify all property lines, easements, and rights-of-way and ensure the fence is located within the property's boundaries. Covenants, conditions, restrictions, easements and/or rights-of-way may restrict or prohibit the placement of fence(s). The owner/applicant is responsible for compliance with covenants, conditions, and restrictions which may apply. Fences built in easements may be subject to removal at the property owner's sole and absolute expense. Any modification of design and/or material as approved in this fence permit must be approved, in writing, by the Community Development Department Director.

I hereby acknowledge that I have read this application and the information and plot plan are correct; I agree to comply with any and all codes, ordinances, laws, regulations, or restrictions which apply. I understand that failure to comply shall result in legal action, which may include but not necessarily be limited to removal of the fence(s) at the owner's cost.


Applicant's Signature BK Weitzel Date 3/6/06
 Community Development's Approval V. H. Nagar / per Komie Date 3/6/06
 City Engineer's Approval (if required) _____ Date _____

VALID FOR SIX MONTHS FROM DATE OF ISSUANCE (Section 2.2.E.1.d Grand Junction Zoning & Development Code)

(White: Planning)

(Yellow: Customer)

(Pink: Code Enforcement)

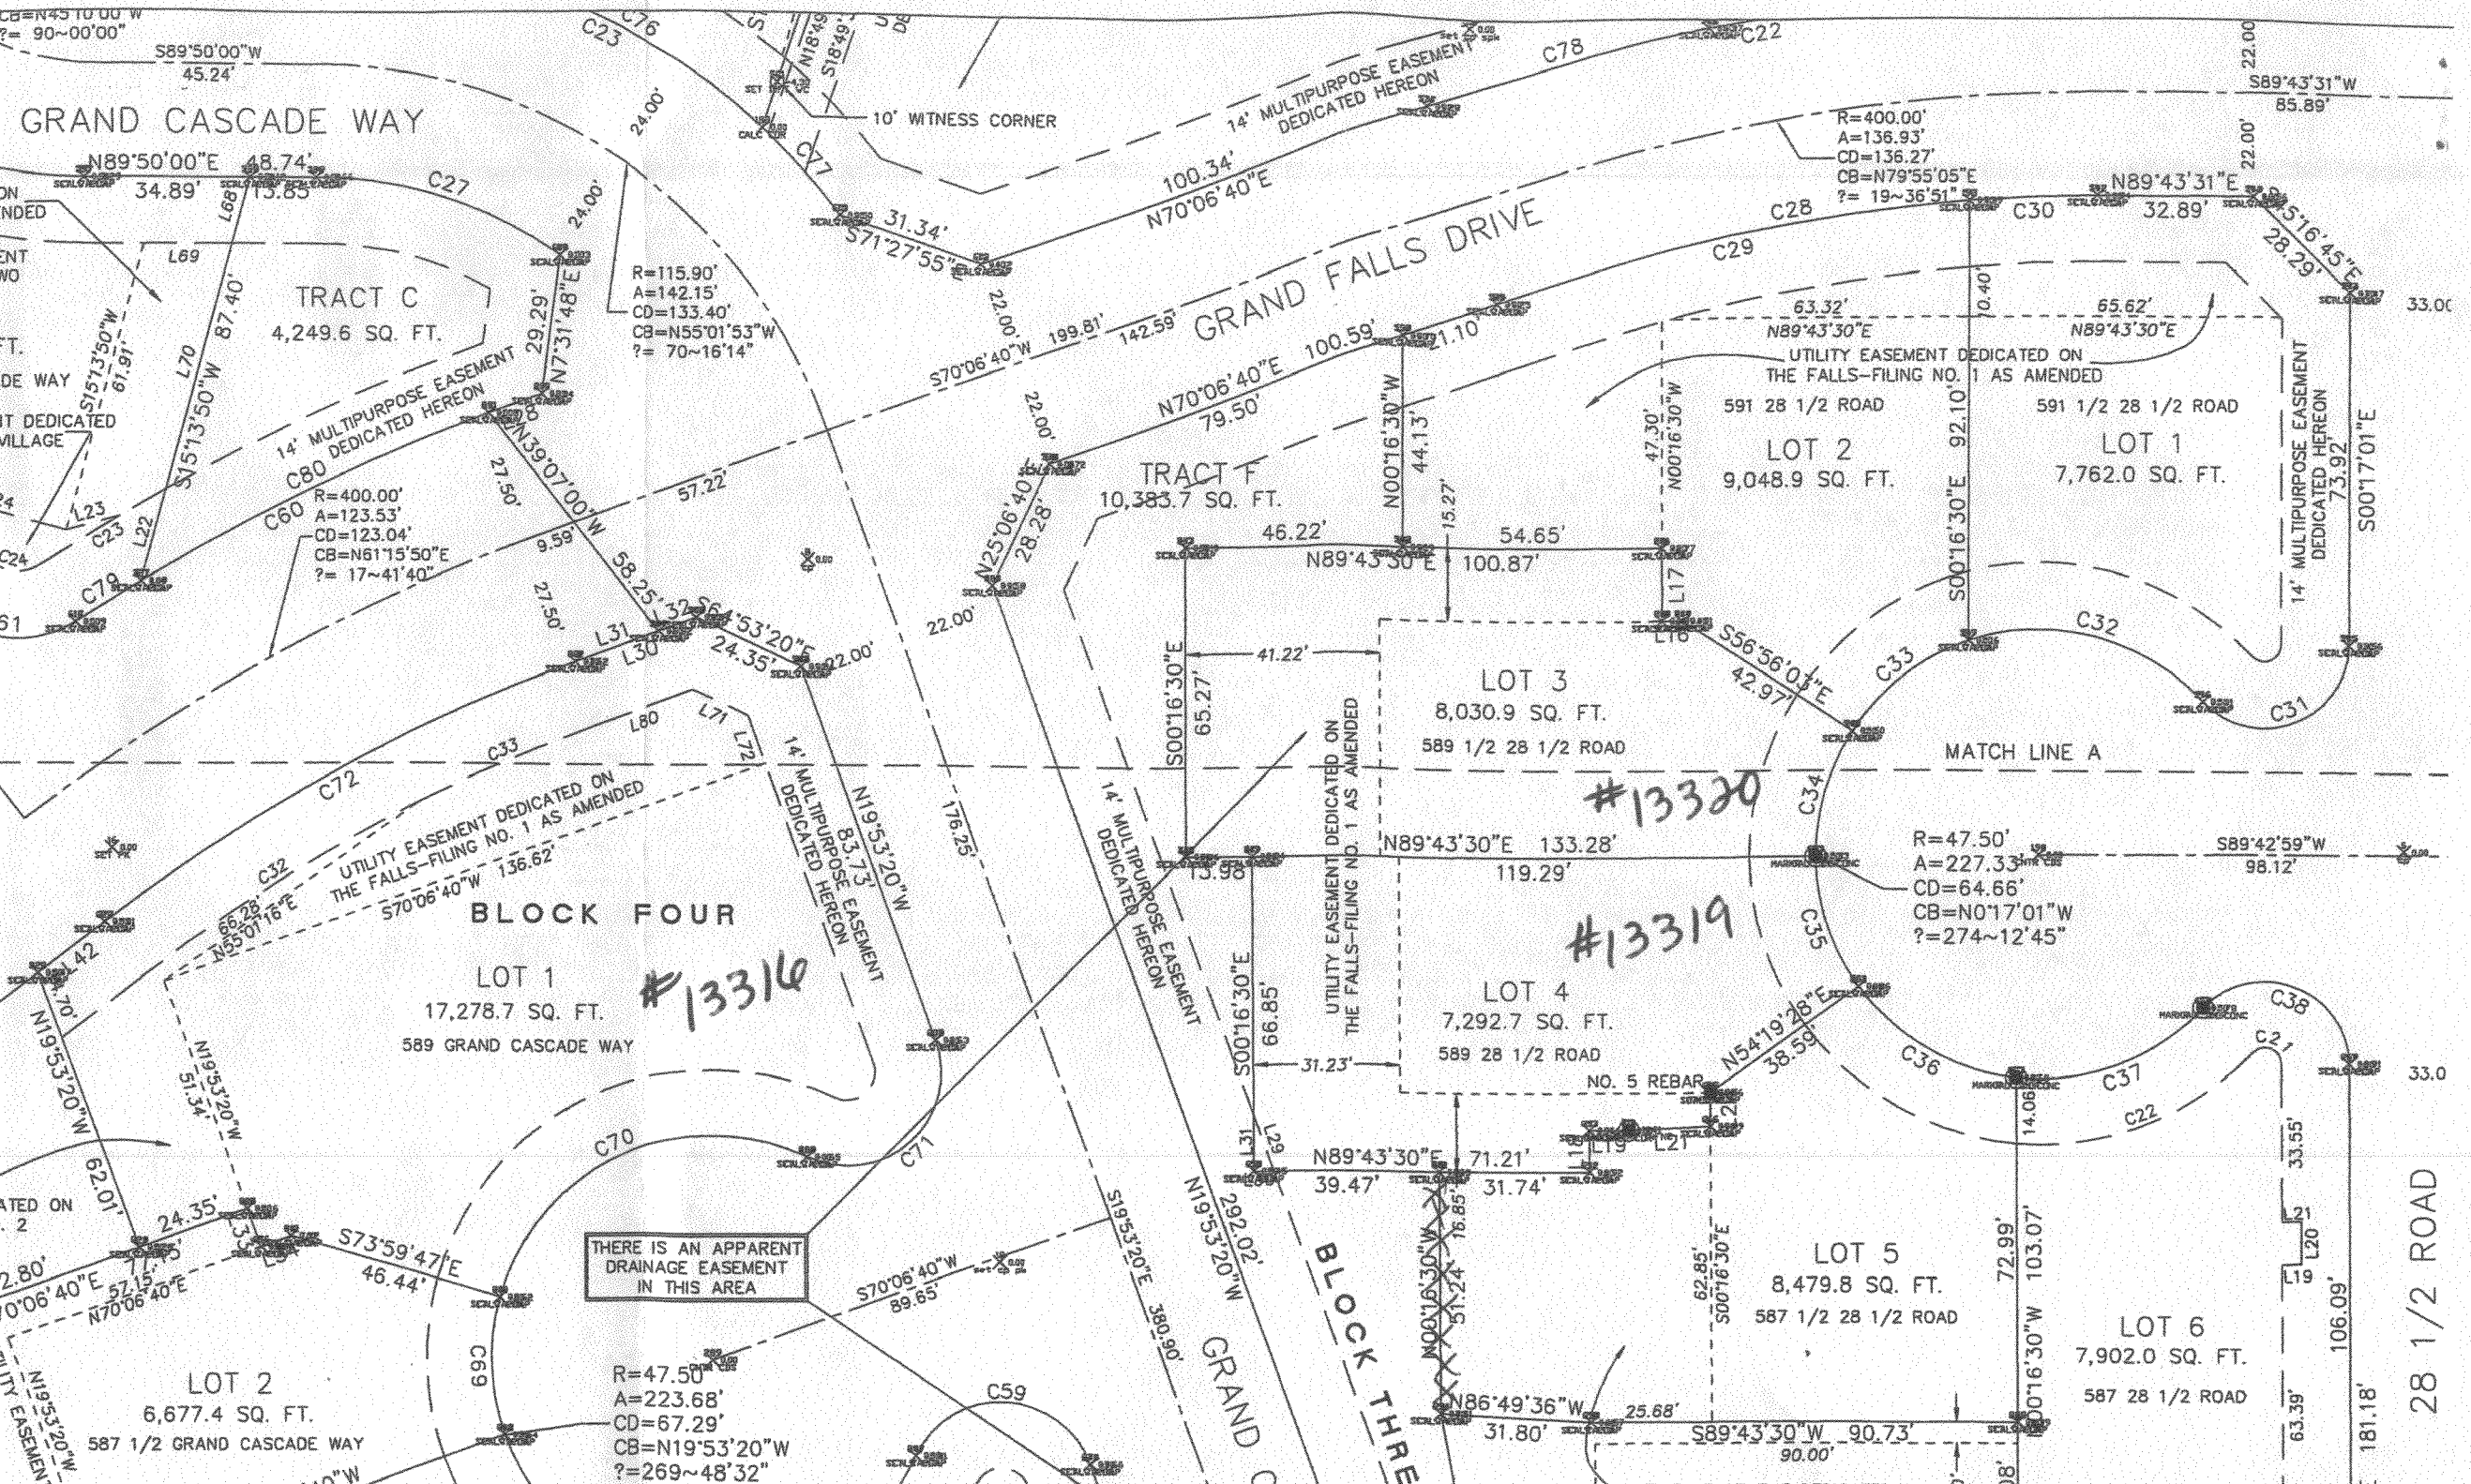

GRAND CASCADE WAY

GRAND FALLS DRIVE

28 1/2 ROAD

TRACT C
4,249.6 SQ. FT.

TRACT F
10,383.7 SQ. FT.

BLOCK FOUR

LOT 1
17,278.7 SQ. FT.
589 GRAND CASCADE WAY

#13316

LOT 3
8,030.9 SQ. FT.
589 1/2 28 1/2 ROAD

#13320

LOT 4
7,292.7 SQ. FT.
589 28 1/2 ROAD

#13319

LOT 5
8,479.8 SQ. FT.
587 1/2 28 1/2 ROAD

LOT 6
7,902.0 SQ. FT.
587 28 1/2 ROAD

THERE IS AN APPARENT
DRAINAGE EASEMENT
IN THIS AREA

R=47.50'
A=227.33'
CD=64.66'
CB=N0°17'01"W
?=274~12'45"

R=115.90'
A=142.15'
CD=133.40'
CB=N55°01'53"W
?=70~16'14"

R=400.00'
A=123.53'
CD=123.04'
CB=N81°15'50"E
?=17~41'40"

R=400.00'
A=136.93'
CD=136.27'
CB=N79°55'05"E
?=19~36'51"

R=47.50'
A=223.68'
CD=67.29'
CB=N19°53'20"W
?=269~48'32"

