

FEE \$10.00

PERMIT # 13915

FENCE PERMIT
GRAND JUNCTION COMMUNITY DEVELOPMENT DEPARTMENT

Property Address: 614 26 road
Property Tax No: 2945 - 023 - 00 - 035
Subdivision:
Property Owner: Robert Puckett & Brenna Sullivan
Owner's Telephone: 970 - 245 - 6870
Owner's Address: 614 26 road
Contractor's Name: Owner
Contractor's Telephone: 245 - 6870
Contractor's Address: same
Fence Material & Height: 49" chainlink

Plot plan must show property lines and property dimensions, all easements, all rights-of-way, all structures, all setbacks from property lines, and fence height(s). NOTE: Property line is likely one foot or more behind the sidewalk.

THIS SECTION TO BE COMPLETED BY COMMUNITY DEVELOPMENT DEPARTMENT STAFF

ZONE RSF4
SPECIAL CONDITIONS
SETBACKS: Front from property line (PL) or from center of ROW, whichever is greater.
Side from PL Rear from PL

Fences exceeding six feet in height require a separate permit from the City/County Building Department. A fence constructed on a corner lot that extends past the rear of the house along the side yard or abuts an alley requires approval from the City Engineer (Section 4.1.J of the Grand Junction Zoning and Development Code).

The owner/applicant must correctly identify all property lines, easements, and rights-of-way and ensure the fence is located within the property's boundaries. Covenants, conditions, restrictions, easements and/or rights-of-way may restrict or prohibit the placement of fence(s). The owner/applicant is responsible for compliance with covenants, conditions, and restrictions which may apply. Fences built in easements may be subject to removal at the property owner's sole and absolute expense. Any modification of design and/or material as approved in this fence permit must be approved, in writing, by the Community Development Department Director.

I hereby acknowledge that I have read this application and the information and plot plan are correct; I agree to comply with any and all codes, ordinances, laws, regulations, or restrictions which apply. I understand that failure to comply shall result in legal action, which may include but not necessarily be limited to removal of the fence(s) at the owner's cost.


Applicant's Signature [Signature] Date 3-30-06
Community Development's Approval [Signature] Date 3-30-06
City Engineer's Approval (if required) Date

VALID FOR SIX MONTHS FROM DATE OF ISSUANCE (Section 2.2.E.1.d Grand Junction Zoning & Development Code)

(White: Planning) (Yellow: Customer) (Pink: Code Enforcement)

... of section 2, Township 1 South, Range 1 West of the Ute Meridian;  
 thence East 21 rods;  
 thence North 7 3/4 rods;  
 thence West 21 rods;  
 thence South 7 3/4 rods to the point of beginning;  
 EXCEPT that portion as conveyed to Mesa County for road purposes as recorded February 17,  
 1971, in Book 955 at Page 543.

26 ROAD

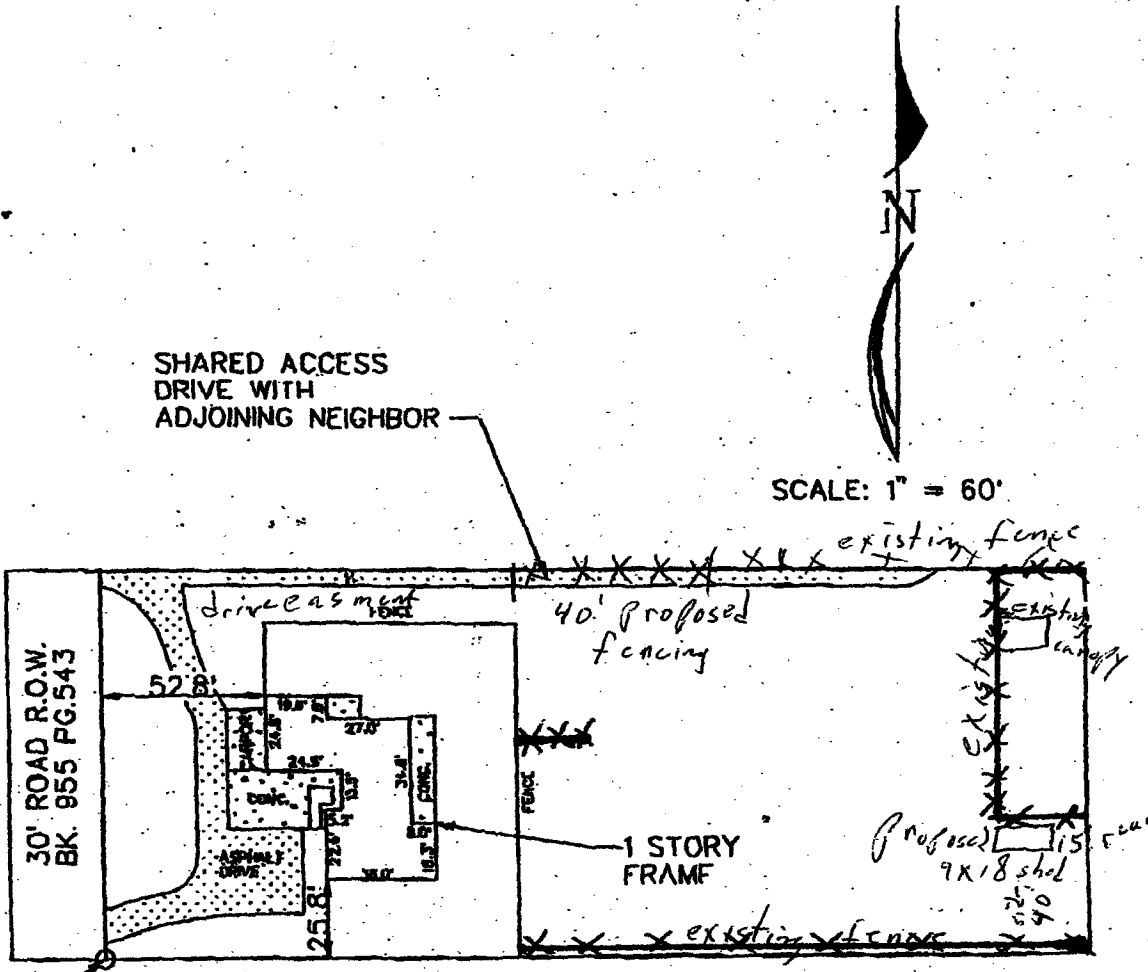

#5 REBAR WITH CAP L.S. #16413

I HEREBY CERTIFY THAT THIS IMPROVEMENT LOCATION CERTIFICATE WAS PREPARED FOR DIRECT MORTGAGE GROUP, THAT IT IS NOT A LAND SURVEY PLAT OR IMPROVEMENT SURVEY PLAT, AND THAT IT IS NOT TO BE RELIED UPON FOR THE ESTABLISHMENT OF FENCE, BUILDING OR OTHER FUTURE IMPROVEMENT LINES. I FURTHER CERTIFY THE IMPROVEMENTS ON THE ABOVE DESCRIBED PARCEL ON THIS DATE 3/13/02 EXCEPT UTILITY CONNECTIONS, ARE ENTIRELY WITHIN THE BOUNDARIES OF THE PARCEL, EXCEPT AS SHOWN, THAT THERE ARE NO ENCROACHMENTS UPON THE DESCRIBED PREMISES BY IMPROVEMENTS ON ANY ADJOINING PREMISES, EXCEPT AS INDICATED, AND THAT THERE IS NO EVIDENCE OR SIGN OF ANY EASEMENT CROSSING OR BURDENING ANY PART OF SAID PARCEL, EXCEPT AS NOTED.

● = FOUND PIN

*Kenneth L. Glenn*  
 KENNETH L. GLENN R.L.S. 12770



PHONE: 970-245-3777 FAX: 241-4847

**SURVEYIT**  
 by GLENN

MAILING:  
 2754 COMPASS DRIVE  
 SUITE 195  
 GRAND JUNCTION, CO. 81506

SURVEYED BY: