



Fence Permit

PERMIT # 14853

Community Development Department
250 North 5th Street
Grand Junction, CO 81501
Phone: (970) 244-1430 FAX (970) 236-4031

FEE \$10.00

Property Address: 682 patent

Property Tax No: 2945-032-10-609

Subdivision: Colonial Heights

Property Owner: Blue Star

Owner's Telephone: 255-8853

Owner's Address: 65 2350 6rd

Contractor's Name: Don Koppes

Contractor's Telephone: 877-1824

Contractor's Address: 1570 A-50 rd

Fence Material & Height: 6 cedar board

Plot plan must show property lines and property dimensions, all easements, all rights-of-way, all structures, all setbacks from property lines, and fence height(s). NOTE: Property line is likely one foot or more behind the sidewalk.

THIS SECTION TO BE COMPLETED BY COMMUNITY DEVELOPMENT DEPARTMENT STAFF

ZONE Rmf-S SETBACKS: Front _____ from property line (PL) or

SPECIAL CONDITIONS _____ from center of ROW, whichever is greater.

_____ Side _____ from PL Rear _____ from PL

Fences exceeding six feet in height require a separate permit from the City/County Building Department. A fence constructed on a corner lot that extends past the rear of the house along the side yard or abuts an alley requires approval from the City Engineer (Section 4.1.J of the Grand Junction Zoning and Development Code).

The owner/applicant must correctly identify all property lines, easements, and rights-of-way and ensure the fence is located within the property's boundaries. Covenants, conditions, restrictions, easements and/or rights-of-way may restrict or prohibit the placement of fence(s). The owner/applicant is responsible for compliance with covenants, conditions, and restrictions which may apply. Fences built in easements may be subject to removal at the property owner's sole and absolute expense. Any modification of design and/or material as approved in this fence permit must be approved, in writing, by the Community Development Department Director.

I hereby acknowledge that I have read this application and the information and plot plan are correct; I agree to comply with any and all codes, ordinances, laws, regulations, or restrictions which apply. I understand that failure to comply shall result in legal action, which may include but not necessarily be limited to removal of the fence(s) at the owner's cost.

Applicant's Signature [Signature] Date 1/23/06

Community Development's Approval [Signature] Date 1-23-06

City Engineer's Approval (if required) _____ Date _____

VALID FOR SIX MONTHS FROM DATE OF ISSUANCE (Section 2.2.E.1.d Grand Junction Zoning & Development Code)

(White: Community Development) (Yellow: Applicant) (Pink: Code Enforcement)



PATRIOT COURT

SITE PLAN INFORMATION	
SUBDIVISION NAME	COLONIAL HEIGHTS- FILING 3
LOT NUMBER	9
BLOCK NUMBER	2
STREET ADDRESS	PATRIOT CT. 692
COUNTY	MESA
HOUSE SQ. FT.	?
LOT SIZE	6739 SF
SETBACKS USED	FRONT 20'
	SIDES 5'
	REAR 25'

NOTE:
GRADE MUST SLOPE AWAY FROM HOUSE 6" OF FALL IN THE FIRST 10' OF DISTANCE PER LOCAL BUILDING CODE.

NOTE:
DIMENSION LINES ARE PULLED FROM EDGE OF BRICK LEDGE. IF NO BRICK LEDGE EXISTS, DIMENSIONS WILL BE FROM EDGE OF FOUNDATION.

NOTE:
BUILDER TO VERIFY ALL SETBACK AND EASEMENT ENCROACHMENTS PRIOR TO CONSTRUCTION

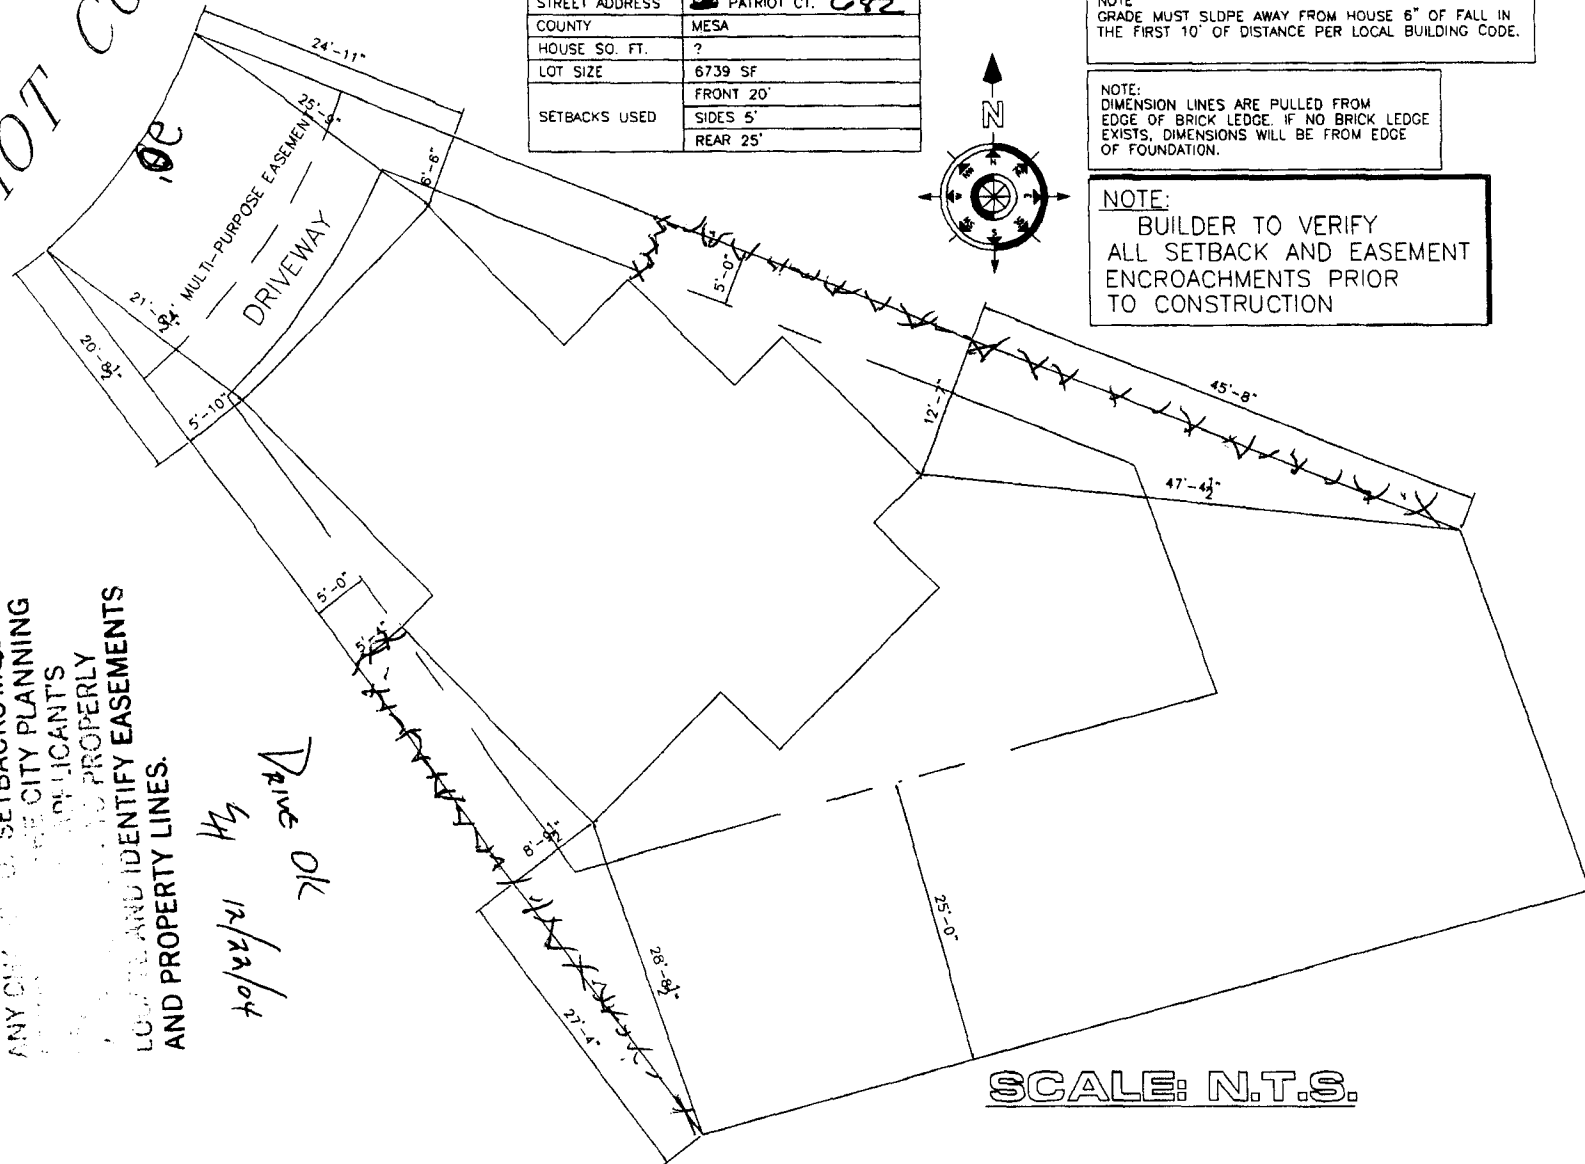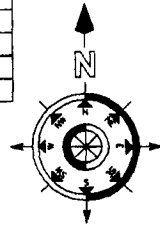

12/27/04

Alisa Morgan

ACCEPTED [Signature] OF SETBACKS MUST BE ANY CITY PLANNING DEPARTMENT APPLICANT'S TO PROPERLY LOCATE AND IDENTIFY EASEMENTS AND PROPERTY LINES.

Drive OK
12/22/04

SCALE: N.T.S.