

FEE \$10.00

PERMIT # 14190

FENCE PERMIT
GRAND JUNCTION COMMUNITY DEVELOPMENT DEPARTMENT

Property Address: 711 Cloverdale Dr
Property Tax No: 2701-353-70-003
Subdivision: 2620 G Rd
Property Owner: Justin Reed
Owner's Telephone: 970-639-5498
Owner's Address: 711 Cloverdale Dr
Contractor's Name:
Contractor's Telephone:
Contractor's Address:
Fence Material & Height: 6' Cedar privacy

Plot plan must show property lines and property dimensions, all easements, all rights-of-way, all structures, all setbacks from property lines, and fence height(s). NOTE: Property line is likely one foot or more behind the sidewalk.

THIS SECTION TO BE COMPLETED BY COMMUNITY DEVELOPMENT DEPARTMENT STAFF
ZONE RMF-5
SPECIAL CONDITIONS
SETBACKS: Front 20' from property line (PL) or from center of ROW, whichever is greater.
Side 0' from PL Rear 0' from PL

Fences exceeding six feet in height require a separate permit from the City/County Building Department. A fence constructed on a corner lot that extends past the rear of the house along the side yard or abuts an alley requires approval from the City Engineer (Section 4.1.J of the Grand Junction Zoning and Development Code).


The owner/applicant must correctly identify all property lines, easements, and rights-of-way and ensure the fence is located within the property's boundaries. Covenants, conditions, restrictions, easements and/or rights-of-way may restrict or prohibit the placement of fence(s). The owner/applicant is responsible for compliance with covenants, conditions, and restrictions which may apply. Fences built in easements may be subject to removal at the property owner's sole and absolute expense. Any modification of design and/or material as approved in this fence permit must be approved, in writing, by the Community Development Department Director.

I hereby acknowledge that I have read this application and the information and plot plan are correct; I agree to comply with any and all codes, ordinances, laws, regulations, or restrictions which apply. I understand that failure to comply shall result in legal action, which may include but not necessarily be limited to removal of the fence(s) at the owner's cost.

Applicant's Signature [Signature] Date 9/6/06
Community Development's Approval [Signature] Date 9/12/06
City Engineer's Approval (if required) Date

VALID FOR SIX MONTHS FROM DATE OF ISSUANCE (Section 2.2.E.1.d Grand Junction Zoning & Development Code)

(White: Planning) (Yellow: Customer) (Pink: Code Enforcement)

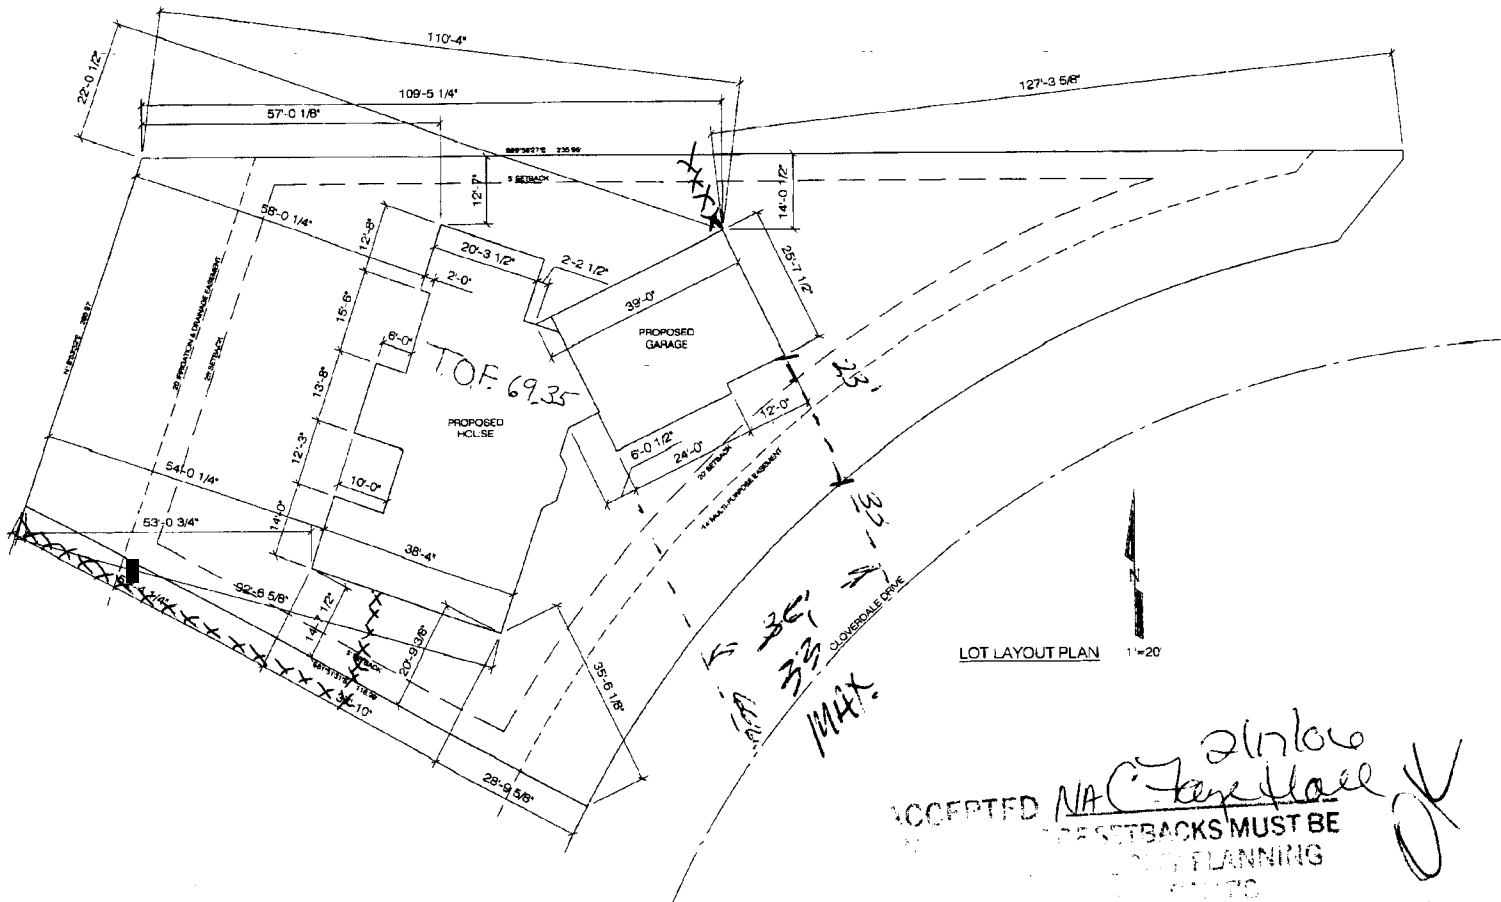

LOT LAYOUT PLAN 1"=20'

ACCEPTED NAC Top Hall
 SETBACKS MUST BE
 PLANNING
 EASEMENTS
 AND PROPERTY LINES

Review OK
 RPTD
 2-17-06

BEHRENS' BUILDING, INC.
 Lot 3, Block 4
 2620 G ROAD
 Grand Junction, Colorado

BEHRENS' BUILDING, INC.
 LAND DEVELOPMENT
 2620 G ROAD
 GRAND JUNCTION, CO 81505
 PHONE: 970-243-2277
 FAX: 970-243-2277
 BEHRENS' BUILDING, INC.
 2620 G ROAD
 GRAND JUNCTION, CO 81505
 PHONE: 970-243-2277
 FAX: 970-243-2277

FREEDOM DRAFTING
 LaDona Amstrong
 2620 G ROAD
 GRAND JUNCTION, CO 81505
 PHONE: 970-243-2277
 FAX: 970-243-2277

Lot Layout Plan
 1-9-2006
 1