

FEE \$10.00

PERMIT # 13622

FENCE PERMIT
GRAND JUNCTION COMMUNITY DEVELOPMENT DEPARTMENT

Property Address: 711 Metate Court GT CO 81601
Property Tax No: 2701-333-41-008
Subdivision: Spanish Trails
Property Owner: Joyce B. and DAVID C. Swanson Trust
Owner's Telephone: 970-309-3774
Owner's Address: 1136 CR Road Glenwood Springs CO 81601
Contractor's Name: Bill Green
Contractor's Telephone:
Contractor's Address:
Fence Material & Height: Redwood 6'

Plot plan must show property lines and property dimensions, all easements, all rights-of-way, all structures, all setbacks from property lines, and fence height(s). NOTE: Property line is likely one foot or more behind the sidewalk.

THIS SECTION TO BE COMPLETED BY COMMUNITY DEVELOPMENT DEPARTMENT STAFF
ZONE FD
SPECIAL CONDITIONS
SETBACKS: Front nothing but must be out of site triangle from property line (PL) or
Side from center of ROW, whichever is greater.
Side from PL Rear from PL

Fences exceeding six feet in height require a separate permit from the City/County Building Department. A fence constructed on a corner lot that extends past the rear of the house along the side yard or abuts an alley requires approval from the City Engineer (Section 4.1.J of the Grand Junction Zoning and Development Code).

The owner/applicant must correctly identify all property lines, easements, and rights-of-way and ensure the fence is located within the property's boundaries. Covenants, conditions, restrictions, easements and/or rights-of-way may restrict or prohibit the placement of fence(s). The owner/applicant is responsible for compliance with covenants, conditions, and restrictions which may apply. Fences built in easements may be subject to removal at the property owner's sole and absolute expense. Any modification of design and/or material as approved in this fence permit must be approved, in writing, by the Community Development Department Director.



I hereby acknowledge that I have read this application and the information and plot plan are correct; I agree to comply with any and all codes, ordinances, laws, regulations, or restrictions which apply. I understand that failure to comply shall result in legal action, which may include but not necessarily be limited to removal of the fence(s) at the owner's cost.

Applicant's Signature David Swanson Date 6/16/06
Community Development's Approval [Signature] Date 6/16/06
City Engineer's Approval (if required) [Signature] Date

# IMPROVEMENT LOCATION CERTIFICATE

711 Metate Court, Grand Junction, Colorado 81505

Lot 8, Block 11 Spanish Trail Filing 4 Subdivision, County of Mesa, State of Colorado.

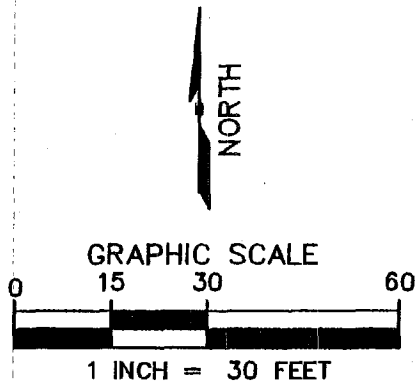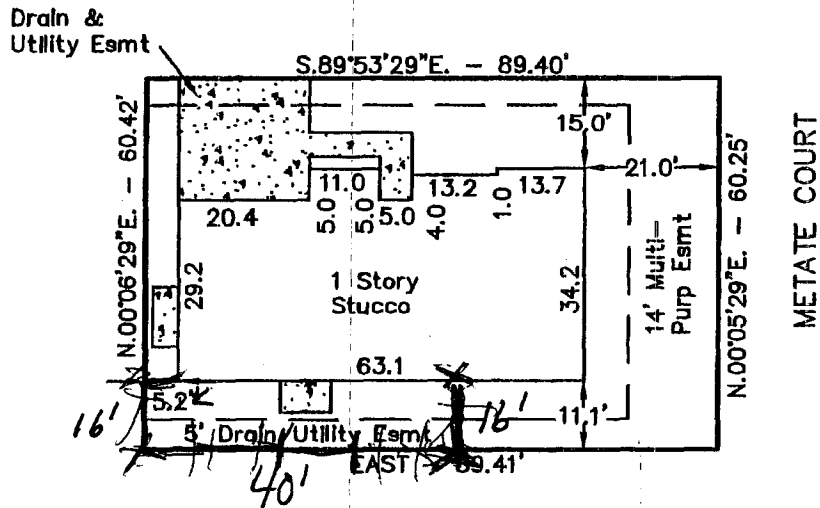

TITLE INFORMATION  
 PROVIDED BY:  
 Security Title Guaranty  
 FILE NO S0141465  
 BORROWER Swanson

I HEREBY CERTIFY THAT THIS IMPROVEMENT LOCATION CERTIFICATE WAS PREPARED FOR Bray and Company, THAT THIS IS NOT A LAND SURVEY PLAT OR IMPROVEMENT SURVEY PLAT, AND THAT IT IS NOT TO BE RELIED UPON FOR THE ESTABLISHMENT OF FENCES, BUILDINGS, OR OTHER FUTURE IMPROVEMENTS LINES. I FURTHER CERTIFY THE IMPROVEMENTS ON THE ABOVE DESCRIBED PARCEL ON THIS DATE 06/15/06, EXCEPT UTILITY CONNECTIONS ARE ENTIRELY WITHIN THE BOUNDARIES OF THE PARCEL, EXCEPT AS SHOWN, THAT THERE ARE NO ENCROACHMENTS UPON THE DESCRIBED PREMISES BY IMPROVEMENTS OF ANY ADJOINING PREMISES, EXCEPT AS INDICATED, AND THAT THERE IS NO APPARENT EVIDENCE OR SIGN OF ANY EASEMENT CROSSING OR BURDENING ANY PART OF SAID PARCEL, EXCEPT AS NOTED.

*James L. White*  
 James L. White PLS 31170 6/15/06



**WHITE  
 SURVEYING**

P.O. Box 873  
 Grand Junction, CO 81502-0873  
 (970) 243-5487 (phone/fax)  
 (970) 261-9010 (cell)

SURVEYED BY: JW	SURVEY DATE: 06/15/06
DRAWN BY: JW	REQUESTED BY: Bray and Company
JOB No. 3616	