FEE \$10.00

(White: Planning)

PERMIT #

(Pink: Code Enforcement)


14038

FENCE PERMIT

GRAND JUNCTION COMMUNITY DEVELOPMENT DEPARTMENT

Property Address: 1404 UteAve	GJ GD 81501
	001 2945-133-17-972
Subdivision:	
Property Owner: VFW	
Owner's Telephone: 970-242-9940	
Owner's Address: 1404 Ute Ave GJ Co 8150)	
Contractor's Name:	
Contractor's Telephone:	
Contractor's Address:	
Fence Material & Height: Oft Chanlink	
Plot plan must show property lines and property dimensions, all easements, all rights-of-way, all structures, all setbacks from property lines, and fence height(s). NOTE: Property line is likely one foot or more behind the sidewalk.	
THIS SECTION TO BE COMPLETED BY COMMUNITY DEVELOPMENT DEPARTMENT STAFF	
zoneC-1	SETBACKS: Front 15 from property line (PL) or
SPECIAL CONDITIONS	from center of ROW, whichever is greater.
	Side from PL Rear from PL
lot that extends past the rear of the house along the side yard or abuthe Grand Junction Zoning and Development Code). The owner/applicant must correctly identify all property lines, ease property's boundaries. Covenants, conditions, restrictions, easen fence(s). The owner/applicant is responsible for compliance with coveasements may be subject to removal at the property owner's sole a approved in this fence permit must be approved, in writing, by the Country of the codes, ordinances, laws, regulations, or restrictions which apply. The codes, ordinances of the fence of	rmation and plot plan are correct; I agree to comply with any and all nderstand that failure to comply shall result in legal action, which may he owner's cost. Date 6 28 06 Date 0 3000
City Engineer's Approval (if required)	Date
VALID FOR SIX MONTHS FROM DATE OF ISSUANCE (Section 2.2.E.1.d Grand Junction Zoning & Development Code)	

(Yellow: Customer)

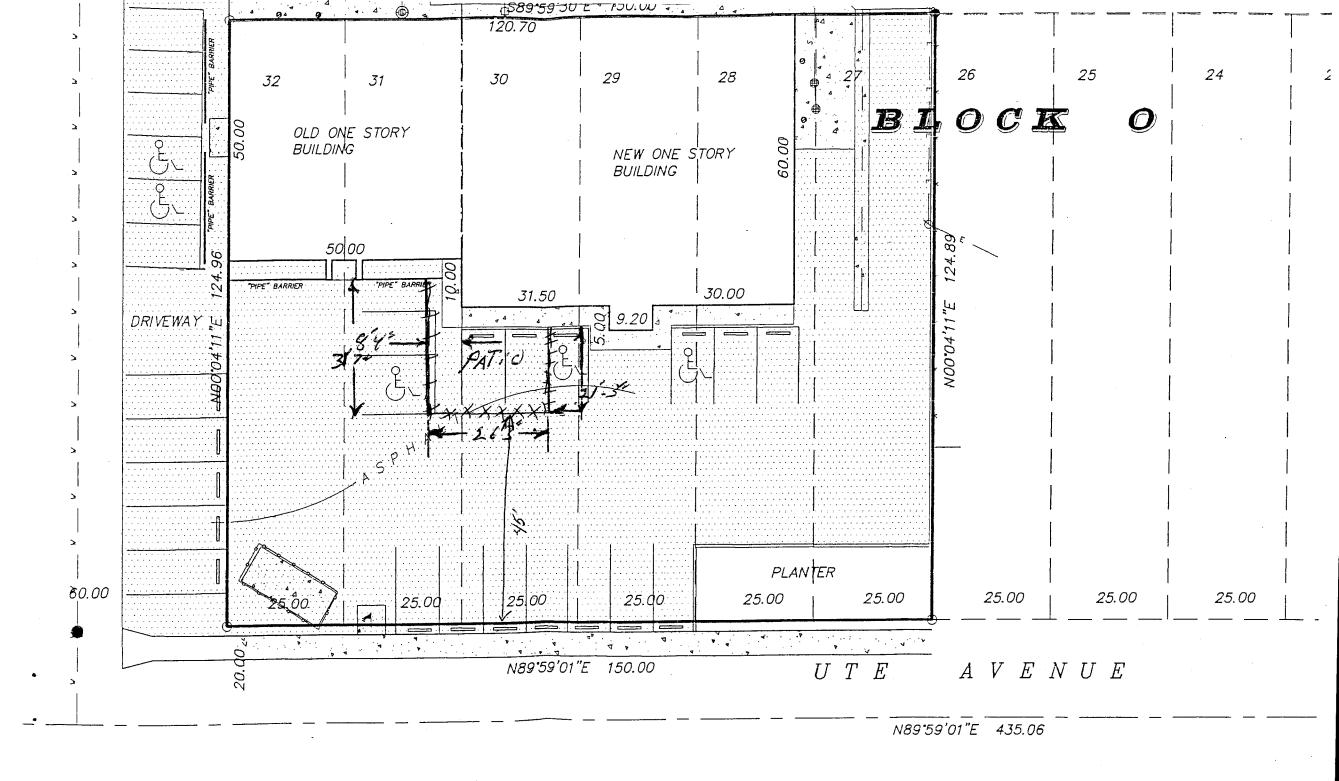





March 22, 2007

VFW 1404 Ute Avenue Grand Junction, CO 81501

Sent by Code Enforcement via certified mail return receipt requested

Re: Fence Permit – 1404 Ute Avenue; Parcel number 2945-133-17-972

To Whom It May Concern:

A fence permit was issued on June 28, 2006 for fencing around an area in front of the building. At the time the permit was issued, the use inside the fenced area was described as a place for patrons to step outside and smoke. Nishi Aragon, Planning Technician, explained to the representative from VFW at the time of application that no additional seating or other use could be added inside the fenced area.

It has come to the attention of the Planning Division that the fence was put up within required parking spaces. A structure with tables and seating has been added inside the fenced area and additional seating is available outside of the structure within the fenced area. These additions are in violation of the Zoning and Development Code Section 2.1. The Zoning and Development Code provides that a permit can be revoked when there is an unlawful use that departs from an approved plan.

The Fence Permit issued on June 28, 2006 is hereby revoked. Please remove the fence within ten (10) days of receipt of this letter to avoid Code Enforcement action.

Sincerely.

Ivy Williams

Public Works and Planning

CC: City Clerk

Code Enforcement