

FEE \$10.00

PERMIT # 14025

FENCE PERMIT
GRAND JUNCTION COMMUNITY DEVELOPMENT DEPARTMENT

Property Address: 2287 EL Monte Ct.
Property Tax No: 2945-071-32-001
Subdivision: Vista Del Rio
Property Owner: Chad Wolfe
Owner's Telephone: 263-8097
Owner's Address: 2287 EL Monte Ct
Contractor's Name: (owner) Chad Wolfe
Contractor's Telephone: 263-8097
Contractor's Address: 2287 EL Monte Ct
Fence Material & Height: Cedar 6'

Plot plan must show property lines and property dimensions, all easements, all rights-of-way, all structures, all setbacks from property lines, and fence height(s). NOTE: Property line is likely one foot or more behind the sidewalk.

THIS SECTION TO BE COMPLETED BY COMMUNITY DEVELOPMENT DEPARTMENT STAFF

ZONE PD SETBACKS: Front 20' from property line (PL) or
SPECIAL CONDITIONS _____ from center of ROW, whichever is greater.
Side 0' from PL Rear 0' from PL

Fences exceeding six feet in height require a separate permit from the City/County Building Department. A fence constructed on a corner lot that extends past the rear of the house along the side yard or abuts an alley requires approval from the City Engineer (Section 4.1.J of the Grand Junction Zoning and Development Code).

The owner/applicant must correctly identify all property lines, easements, and rights-of-way and ensure the fence is located within the property's boundaries. Covenants, conditions, restrictions, easements and/or rights-of-way may restrict or prohibit the placement of fence(s). The owner/applicant is responsible for compliance with covenants, conditions, and restrictions which may apply. Fences built in easements may be subject to removal at the property owner's sole and absolute expense. Any modification of design and/or material as approved in this fence permit must be approved, in writing, by the Community Development Department Director.

I hereby acknowledge that I have read this application and the information and plot plan are correct; I agree to comply with any and all codes, ordinances, laws, regulations, or restrictions which apply. I understand that failure to comply shall result in legal action, which may include but not necessarily be limited to removal of the fence(s) at the owner's cost.


Applicant's Signature Chad Wolfe Date 6-6/06
Community Development's Approval [Signature] Date 6/6/06
City Engineer's Approval (if required) _____ Date _____

VALID FOR SIX MONTHS FROM DATE OF ISSUANCE (Section 2.2.E.1.d Grand Junction Zoning & Development Code)

(White: Planning) (Yellow: Customer) (Pink: Code Enforcement)

2287

EL MONTE COURT

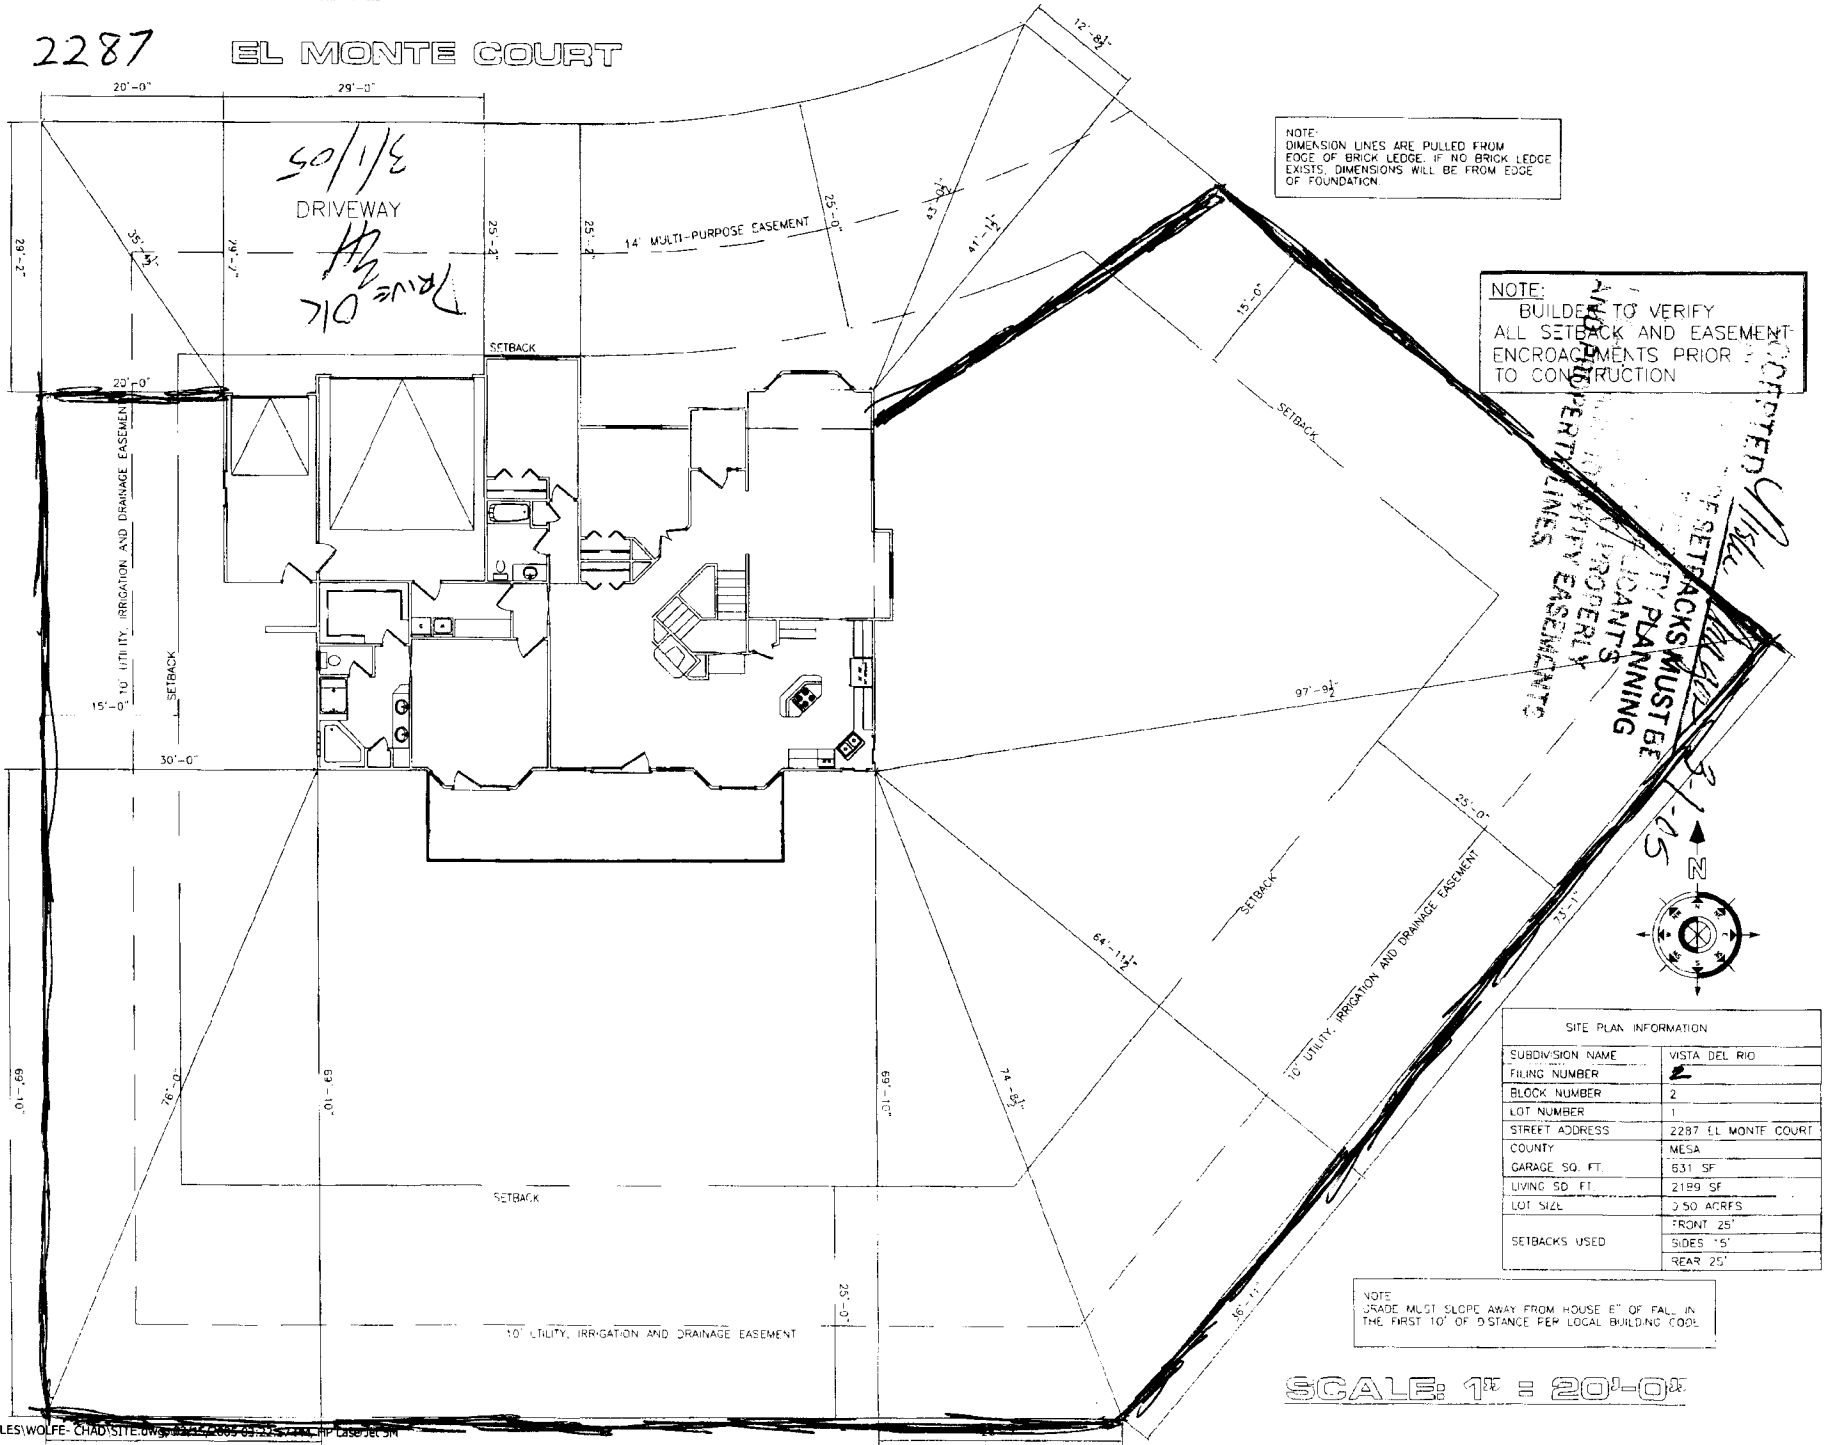

NOTE:
DIMENSION LINES ARE PULLED FROM
EDGE OF BRICK LEDGE. IF NO BRICK LEDGE
EXISTS, DIMENSIONS WILL BE FROM EDGE
OF FOUNDATION

NOTE:
BUILDER TO VERIFY
ALL SETBACK AND EASEMENT
ENCROACHMENTS PRIOR
TO CONSTRUCTION

PROPERTY LINES
PROPERTY EASEMENTS
SETBACKS MUST BE
APPROVED BY CITY PLANNING
DEPARTMENT
3-1-05



SITE PLAN INFORMATION	
SUBDIVISION NAME	VISTA DEL RIO
FILING NUMBER	1
BLOCK NUMBER	2
LOT NUMBER	1
STREET ADDRESS	2287 EL MONTE COURT
COUNTY	MESA
GARAGE SQ. FT.	631 SF
LIVING SQ. FT.	2199 SF
LOT SIZE	0.50 ACRES
SETBACKS USED	FRONT 25' SIDES 5' REAR 25'

NOTE:
GRADE MUST SLOPE AWAY FROM HOUSE IF OF FALL IN
THE FIRST 10' OF DISTANCE PER LOCAL BUILDING CODE.

SCALE: 1" = 20'-0"