



Fence Permit

PERMIT # 14862

Community Development Department
250 North 5th Street
Grand Junction, CO 81501
Phone: (970) 244-1430 FAX (970) 236-4031

FEE \$10.00

Property Address: 2501 Upr Buner

Property Tax No: 2945-032-99-020

Subdivision: Colonial Heights

Property Owner: Blue Star

Owner's Telephone: _____

Owner's Address: _____

Contractor's Name: Don Kuppas

Contractor's Telephone: 874-4821

Contractor's Address: 1570 H-50 rd

Fence Material & Height: 6' cedar Board

Plot plan must show property lines and property dimensions, all easements, all rights-of-way, all structures, all setbacks from property lines, and fence height(s). NOTE: Property line is likely one foot or more behind the sidewalk.

THIS SECTION TO BE COMPLETED BY COMMUNITY DEVELOPMENT DEPARTMENT STAFF	
ZONE <u>BMF-5</u>	SETBACKS: Front _____ from property line (PL) or
SPECIAL CONDITIONS _____	_____ from center of ROW, whichever is greater.
_____	Side _____ from PL Rear _____ from PL

Fences exceeding six feet in height require a separate permit from the City/County Building Department. A fence constructed on a corner lot that extends past the rear of the house along the side yard or abuts an alley requires approval from the City Engineer (Section 4.1.J of the Grand Junction Zoning and Development Code).

The owner/applicant must correctly identify all property lines, easements, and rights-of-way and ensure the fence is located within the property's boundaries. Covenants, conditions, restrictions, easements and/or rights-of-way may restrict or prohibit the placement of fence(s). The owner/applicant is responsible for compliance with covenants, conditions, and restrictions which may apply. Fences built in easements may be subject to removal at the property owner's sole and absolute expense. Any modification of design and/or material as approved in this fence permit must be approved, in writing, by the Community Development Department Director.

I hereby acknowledge that I have read this application and the information and plot plan are correct; I agree to comply with any and all codes, ordinances, laws, regulations, or restrictions which apply. I understand that failure to comply shall result in legal action, which may include but not necessarily be limited to removal of the fence(s) at the owner's cost.

Applicant's Signature [Signature] Date 2/1/06

Community Development's Approval [Signature] Date 2/1/06

City Engineer's Approval (if required) _____ Date _____


VALID FOR SIX MONTHS FROM DATE OF ISSUANCE (Section 2.2.E.1.d Grand Junction Zoning & Development Code)

(White: Community Development)

(Yellow: Applicant)

(Pink: Code Enforcement)

1. DETAILS
 CERTAINCE OF THESE TERMS
 NOTICE
 DRAWINGS BY OTHERS

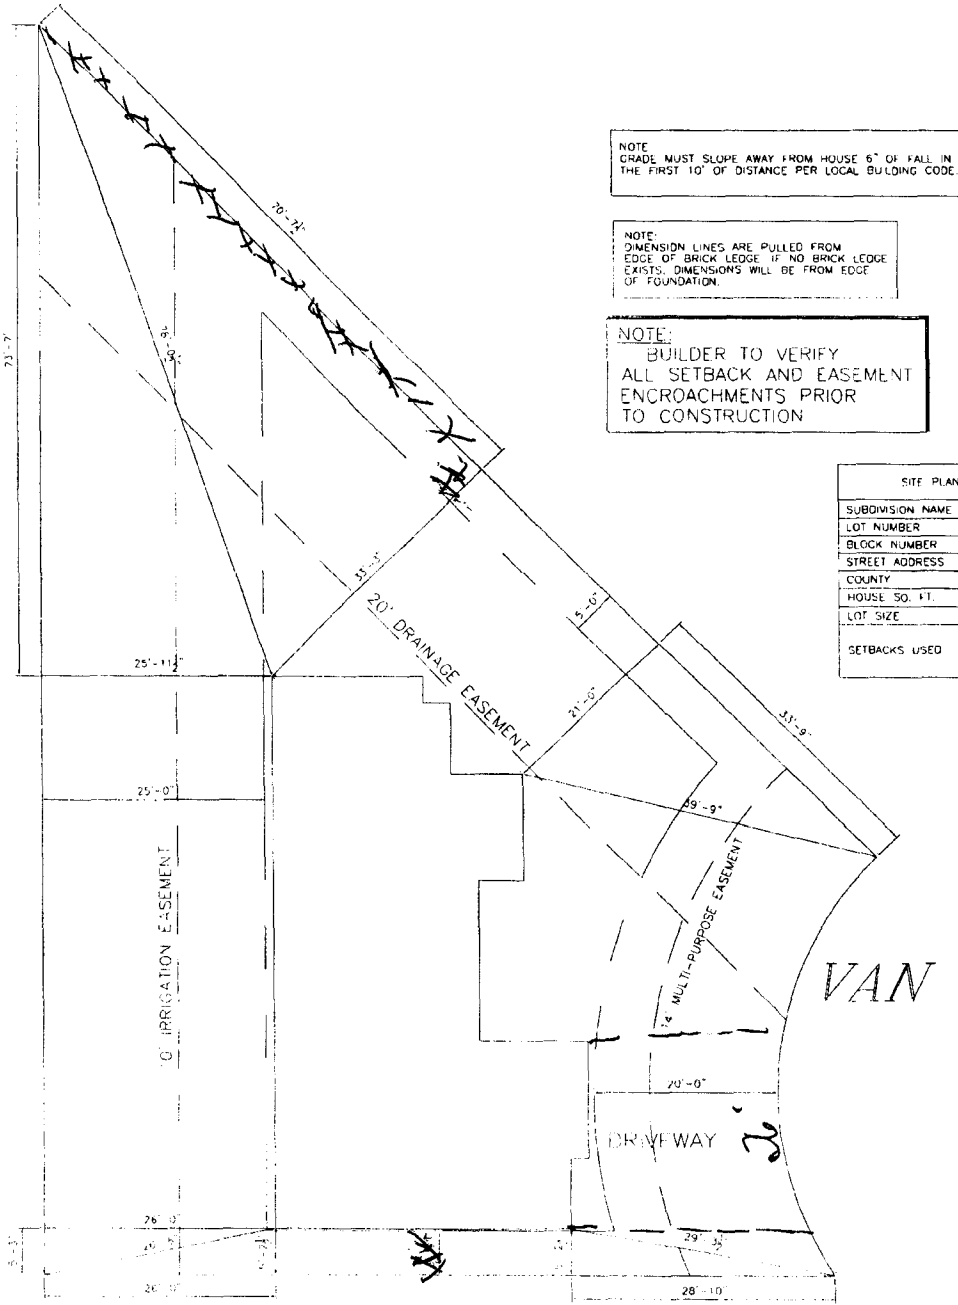

NOTE:
 GRADE MUST SLOPE AWAY FROM HOUSE 6" OF FALL IN
 THE FIRST 10' OF DISTANCE PER LOCAL BUILDING CODE.


NOTE:
 DIMENSION LINES ARE PULLED FROM
 EDGE OF BRICK LEDGE IF NO BRICK LEDGE
 EXISTS. DIMENSIONS WILL BE FROM EDGE
 OF FOUNDATION.

NOTE:
 BUILDER TO VERIFY
 ALL SETBACK AND EASEMENT
 ENCROACHMENTS PRIOR
 TO CONSTRUCTION

SITE PLAN INFORMATION	
SUBDIVISION NAME	COLONIAL HEIGHTS - FILING 3
LOT NUMBER	20
BLOCK NUMBER	1
STREET ADDRESS	2501 VAN BUREN AVE.
COUNTY	MESA
HOUSE NO. #1	?
LOT SIZE	8,308 SF
SETBACKS USED	FRONT 20'
	SIDES 5'
	REAR 25'

ACCEPTED
 ANY CHANGE OF SETBACKS MUST BE
 APPROVED BY THE CITY PLANNING
 DEPARTMENT.
 RESIDENTS MUST PROPERLY
 LOCATE AND IDENTIFY EASEMENTS
 AND PROPERTY LINES.

Ulsik Haas
 10/07/04

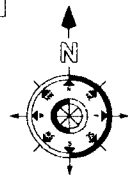

VAN BUREN AVENUE

DRIVE OK
SAH
 12/22/04

HP LaserJet 1100 (MS)