

FEE \$10.06

PERMIT # 14640

FENCE PERMIT
GRAND JUNCTION COMMUNITY DEVELOPMENT DEPARTMENT

Property Address: 2644 Haven Hill Dr
Property Tax No: 2701-261-33-008
Subdivision: Haven Hill Dr
Property Owner: Ron Sellers
Owner's Telephone: 242-8390
Owner's Address: Same
Contractor's Name:
Contractor's Telephone:
Contractor's Address:
Fence Material & Height: 6' Wood Fence

Plot plan must show property lines and property dimensions, all easements, all rights-of-way, all structures, all setbacks from property lines, and fence height(s). NOTE: Property line is likely one foot or more behind the sidewalk.

THIS SECTION TO BE COMPLETED BY COMMUNITY DEVELOPMENT DEPARTMENT STAFF
ZONE PD
SPECIAL CONDITIONS
SETBACKS: Front 20' from property line (PL) or from center of ROW, whichever is greater.
Side 10' from PL Rear 30' from PL

Fences exceeding six feet in height require a separate permit from the City/County Building Department. A fence constructed on a corner lot that extends past the rear of the house along the side yard or abuts an alley requires approval from the City Engineer (Section 4.1.J of the Grand Junction Zoning and Development Code).

The owner/applicant must correctly identify all property lines, easements, and rights-of-way and ensure the fence is located within the property's boundaries. Covenants, conditions, restrictions, easements and/or rights-of-way may restrict or prohibit the placement of fence(s). The owner/applicant is responsible for compliance with covenants, conditions, and restrictions which may apply. Fences built in easements may be subject to removal at the property owner's sole and absolute expense. Any modification of design and/or material as approved in this fence permit must be approved, in writing, by the Community Development Department Director.

I hereby acknowledge that I have read this application and the information and plot plan are correct; I agree to comply with any and all codes, ordinances, laws, regulations, or restrictions which apply. I understand that failure to comply shall result in legal action, which may include but not necessarily be limited to removal of the fence(s) at the owner's cost.

Applicant's Signature [Signature] Date 4/21/06
Community Development's Approval [Signature] Date 4/21/06
City Engineer's Approval (if required) Date




VALID FOR SIX MONTHS FROM DATE OF ISSUANCE (Section 2.2.E.1.d Grand Junction Zoning & Development Code)

(White: Planning) (Yellow: Customer) (Pink: Code Enforcement)

Jan Sellers HOUSE
 2444 Haven Hill Dr
 G.J. Co. 81506

Red = New and Extension of
 Existing fencing

SECTION B-B
 NO SCALE

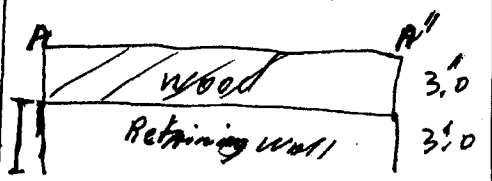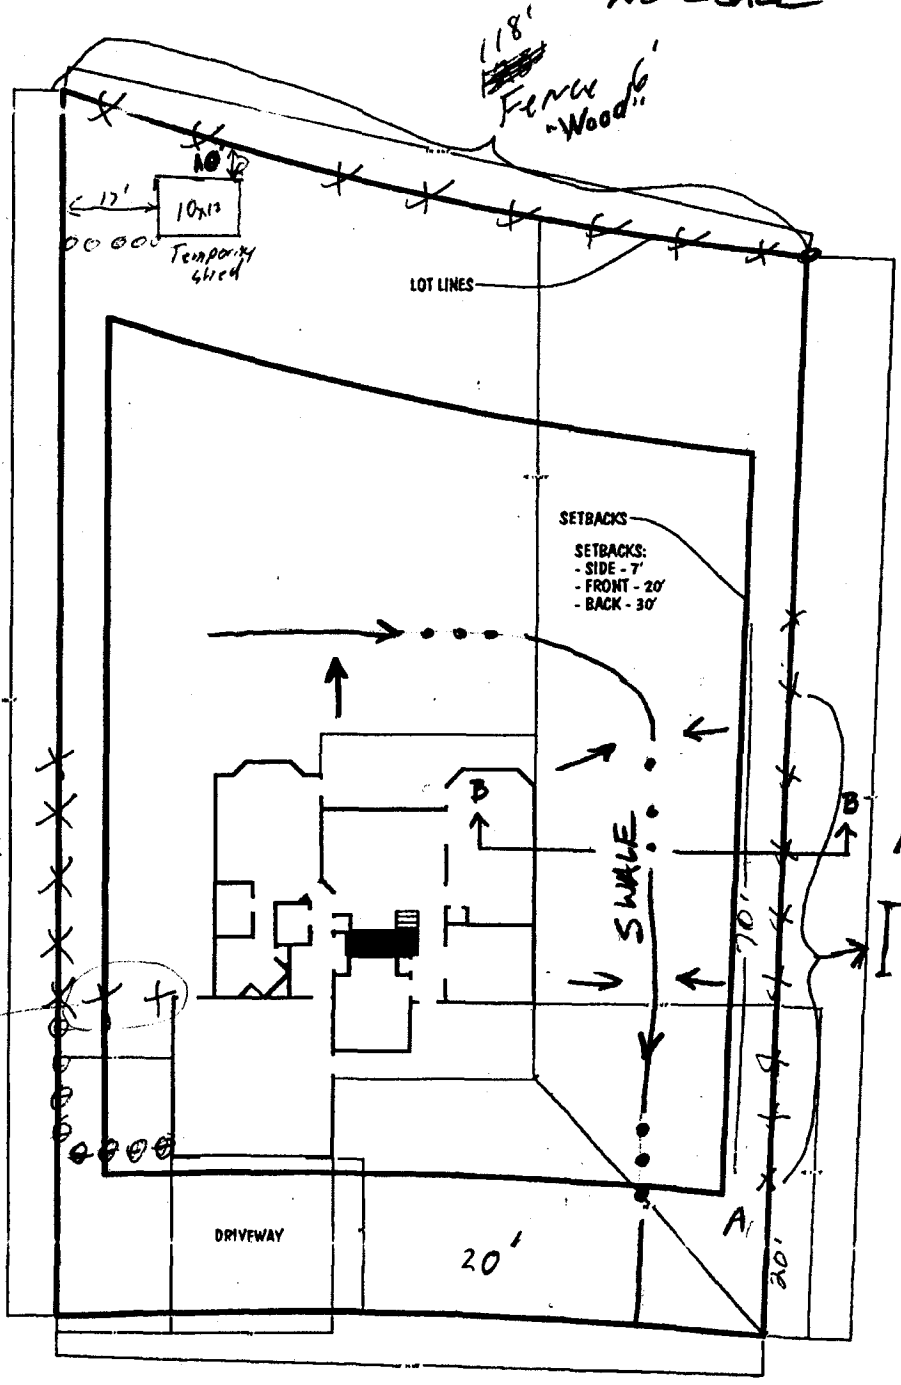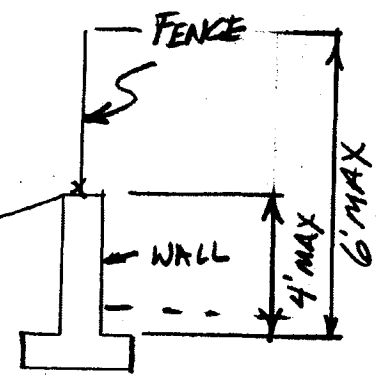

2694 HAVEN HILL DR.
 LOT 8, BLOCK 2, FILING 2,
 SUMMERHILL SUBDIVISION

TOFT CONSTRUCTION / GREG TOFT
 2692 HAVEN HILL DR.
 GRAND JUNCTION, CO 81506
 243-1351 / 234-8454

Greg Toft
 4-1-02