

FEE \$10.00

PERMIT # 14159

FENCE PERMIT
GRAND JUNCTION COMMUNITY DEVELOPMENT DEPARTMENT

Property Address: 2651 IRd 263-4315
Property Tax No: 2701-261-35-004 985-2288
Subdivision: GRAND VISTA
Property Owner: ROBERT H. AND SANDRA D. de GANABL
Owner's Telephone: 970-263-4315
Owner's Address: 2651 IRd
Contractor's Name: LANDSCAPE TECHNOLOGIES
Contractor's Telephone: 970-268-5620
Contractor's Address: P.O. BOX. 486 MOSA CO 81643
Fence Material & Height: Block 3 1/2'-4' retaining wall (partially buried)

Plot plan must show property lines and property dimensions, all easements, all rights-of-way, all structures, all setbacks from property lines, and fence height(s). NOTE: Property line is likely one foot or more behind the sidewalk.

THIS SECTION TO BE COMPLETED BY COMMUNITY DEVELOPMENT DEPARTMENT STAFF

ZONE RMF-5 SETBACKS: Front from property line (PL) or
SPECIAL CONDITIONS Needs to be 5' from center of ROW, whichever is greater.
off property line (just outside existing fence) Side from PL Rear from PL

Fences exceeding six feet in height require a separate permit from the City/County Building Department. A fence constructed on a corner lot that extends past the rear of the house along the side yard or abuts an alley requires approval from the City Engineer (Section 4.1.J of the Grand Junction Zoning and Development Code).

The owner/applicant must correctly identify all property lines, easements, and rights-of-way and ensure the fence is located within the property's boundaries. Covenants, conditions, restrictions, easements and/or rights-of-way may restrict or prohibit the placement of fence(s). The owner/applicant is responsible for compliance with covenants, conditions, and restrictions which may apply. Fences built in easements may be subject to removal at the property owner's sole and absolute expense. Any modification of design and/or material as approved in this fence permit must be approved, in writing, by the Community Development Department Director.


I hereby acknowledge that I have read this application and the information and plot plan are correct; I agree to comply with any and all codes, ordinances, laws, regulations, or restrictions which apply. I understand that failure to comply shall result in legal action, which may include but not necessarily be limited to removal of the fence(s) at the owner's cost.

Applicant's Signature Sandra D de Ganabl Date 8-9-06
Community Development's Approval Gayleen Henderson Date 8-9-06
City Engineer's Approval (if required) Date

VALID FOR SIX MONTHS FROM DATE OF ISSUANCE (Section 2.2.E.1.d Grand Junction Zoning & Development Code)
(White: Planning) (Yellow: Customer) (Pink: Code Enforcement)

8/28/02
 ACCEPTED *Y. J. Nelson*
 ANY CHANGE OF SETBACKS MUST BE
 APPROVED BY THE CITY PLANNING
 DEPT. IT IS THE APPLICANT'S
 RESPONSIBILITY TO PROPERLY
 LOCATE AND IDENTIFY EASEMENTS
 AND PROPERTY LINES

Kamal 20061
 2651 I ROAD

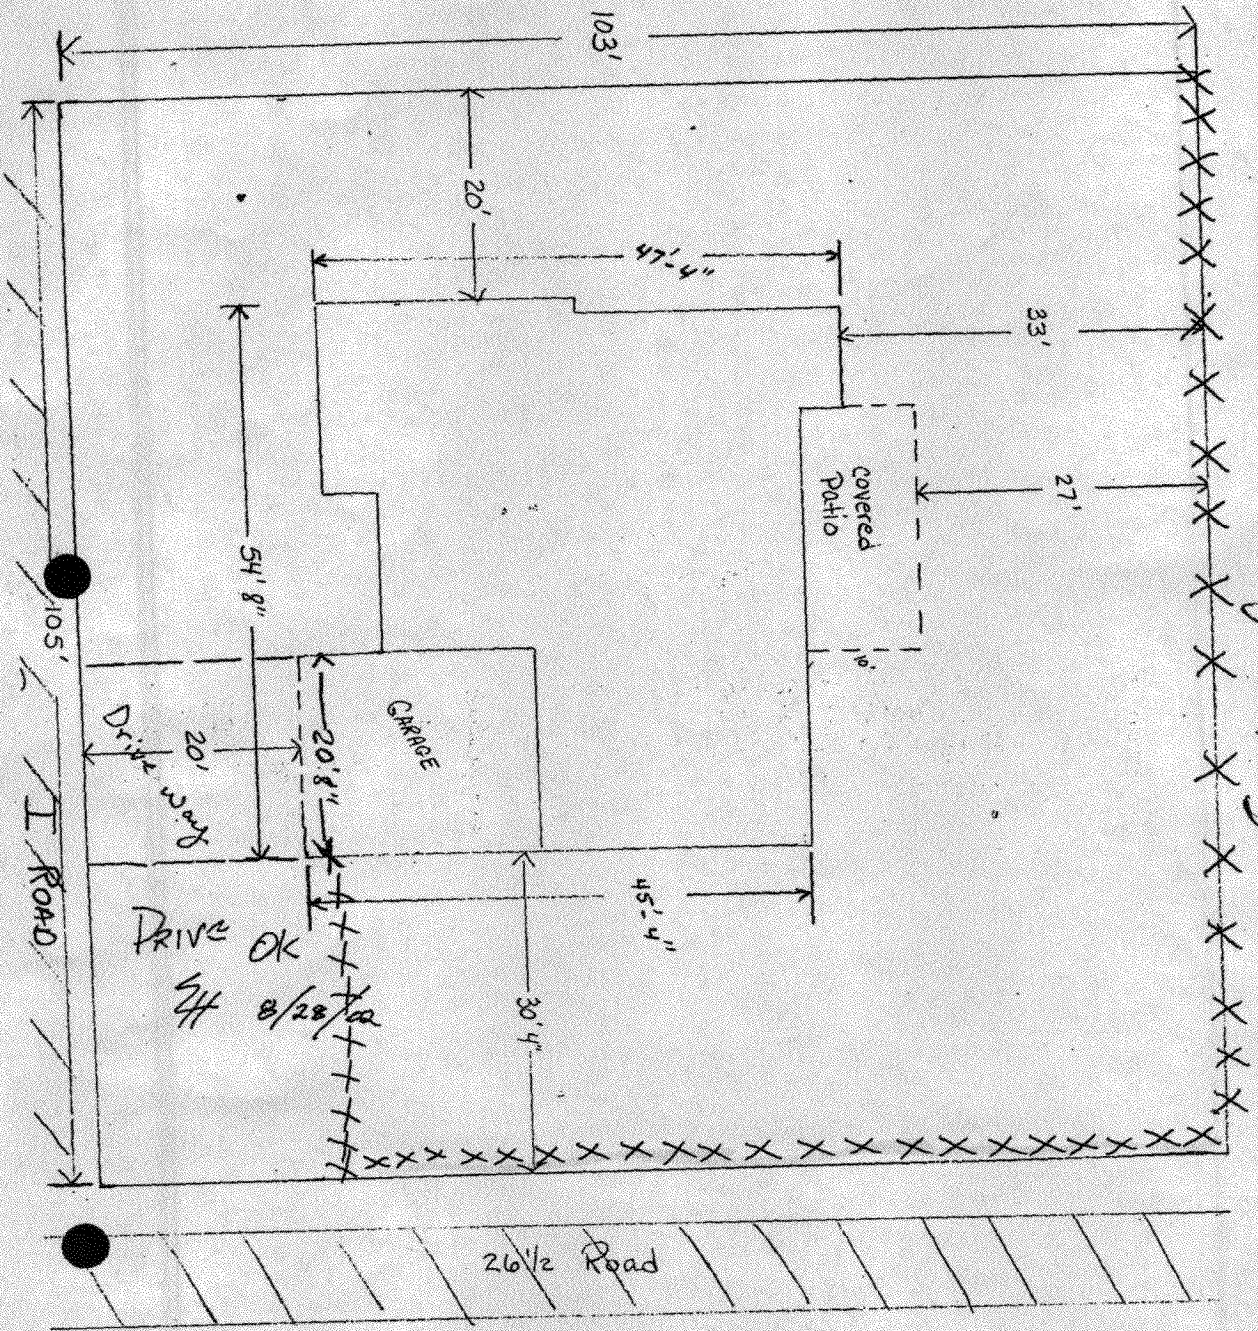

DRIVE OK
 5/4 8/28/02



26.51 I Rd

Grand Junction, CO 81506

Lot 4, Block 1

Grand Vista Subdivision

I RD

26 1/2 Rd

Retaining wall 3 1/2 - 4 ft