

FEE \$10.00

PERMIT # 14837

FENCE PERMIT
GRAND JUNCTION COMMUNITY DEVELOPMENT DEPARTMENT

Property Address: 2810 Village Park Drive, G.J. CO 81506
Property Tax No: 2943-063-44-015
Subdivision: Village Park Subdivision
Property Owner: Gabriel and Cory Kettle
Owner's Telephone: 970-640-9310
Owner's Address: 629 Stan Drive, G.J., CO 81504
Contractor's Name: John Davis
Contractor's Telephone: 255-8853
Contractor's Address:
Fence Material & Height: Cedar, 6ft.

Plot plan must show property lines and property dimensions, all easements, all rights-of-way, all structures, all setbacks from property lines, and fence height(s). NOTE: Property line is likely one foot or more behind the sidewalk.

THIS SECTION TO BE COMPLETED BY COMMUNITY DEVELOPMENT DEPARTMENT STAFF
ZONE R0
SPECIAL CONDITIONS
SETBACKS: Front 15' from property line (PL) or
Side from PL Rear from PL

Fences exceeding six feet in height require a separate permit from the City/County Building Department. A fence constructed on a corner lot that extends past the rear of the house along the side yard or abuts an alley requires approval from the City Engineer (Section 4.1.J of the Grand Junction Zoning and Development Code).

The owner/applicant must correctly identify all property lines, easements, and rights-of-way and ensure the fence is located within the property's boundaries. Covenants, conditions, restrictions, easements and/or rights-of-way may restrict or prohibit the placement of fence(s). The owner/applicant is responsible for compliance with covenants, conditions, and restrictions which may apply. Fences built in easements may be subject to removal at the property owner's sole and absolute expense. Any modification of design and/or material as approved in this fence permit must be approved, in writing, by the Community Development Department Director.

I hereby acknowledge that I have read this application and the information and plot plan are correct; I agree to comply with any and all codes, ordinances, laws, regulations, or restrictions which apply. I understand that failure to comply shall result in legal action, which may include but not necessarily be limited to removal of the fence(s) at the owner's cost.

Applicant's Signature [Signature] Date 01/04/06
Community Development's Approval [Signature] Date 1-4-06
City Engineer's Approval (if required) [Signature] Date

VALID FOR SIX MONTHS FROM DATE OF ISSUANCE (Section 2.2.E.1.d Grand Junction Zoning & Development Code)


(White: Planning) (Yellow: Customer) (Pink: Code Enforcement)

- NOTES:**
1. IT IS THE RESPONSIBILITY OF THE BUILDER OR OWNER TO VERIFY ALL DETAILS AND DIMENSIONS PRIOR TO CONSTRUCTION.
 2. USE OF THIS PLAN CONSTITUTES BUILDER AND OR HOME OWNERS ACCEPTANCE OF THESE TERMS.
 3. ALL DIMENSIONS ARE TO FACE OF STUD UNLESS OTHER WISE NOTED.
 4. WALLS ARE DRAWN AS 3-1/2" THICK FOR 2ND WALLS AND 5-1/2" FOR 2ND WALLS.
 5. THIS PLAN HAS NOT BEEN ENGINEERED BY AUTOCAD. SEE SEPARATE DRAWINGS BY OTHERS FOR ENGINEERING DATA.

BLOCK 5
 LOT 15
 6289 sf

NOTE:
 BUILDER TO VERIFY ALL SETBACK AND EASEMENT ENCROACHMENTS PRIOR TO CONSTRUCTION

SETBACKS:
 FRONT SB TO GARAGE 20' (15' TO HOUSE)
 SIDE SB 5'
 REAR SB BY GRAND VIEW 25'
 REAR SB BY DAWN 20'
 REAR SB BY VILLAGE PARK 10'

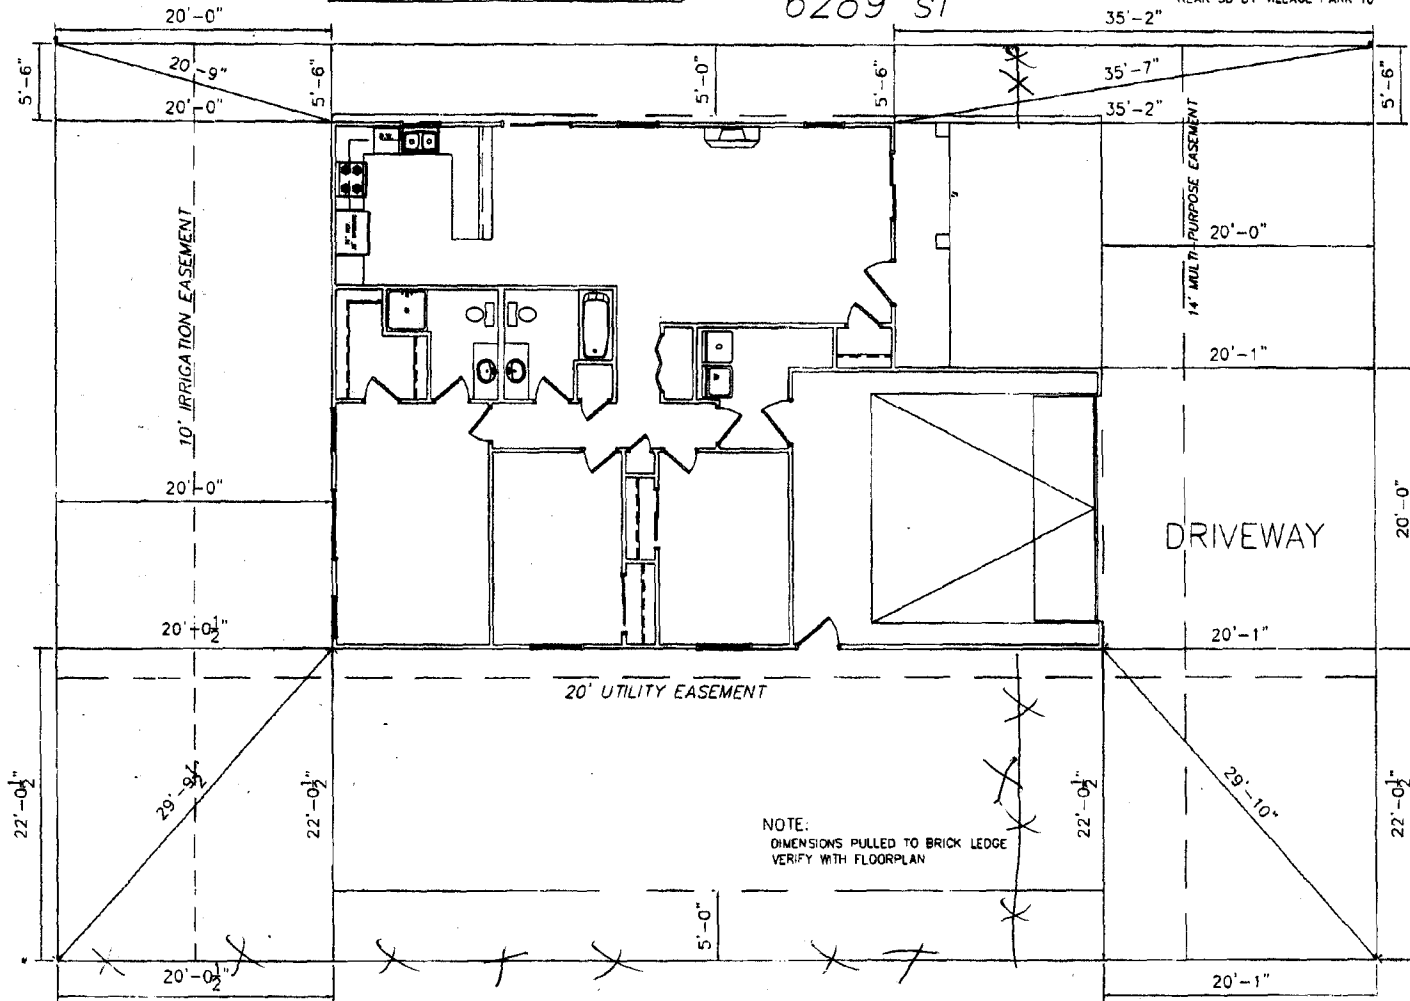

NOTE:
 DIMENSIONS PULLED TO BRICK LEDGE
 VERIFY WITH FLOORPLAN

Jlu
 W 4/13/04

4-20-04 *Dwyer H. Lewis*
 ACCEPTED
 ANY CHANGE TO THIS BLOCKS MUST BE APPROVED BY THE CITY PLANNING DEPT. IT IS THE APPLICANTS RESPONSIBILITY TO PROPERLY LOCATE AND IDENTIFY EASEMENTS AND PROPERTY LINES.

GRAND VIEW PARK DRIVE

2810