

FEE \$10.00

PERMIT #

14166

# FENCE PERMIT

## GRAND JUNCTION COMMUNITY DEVELOPMENT DEPARTMENT

Property Address: 2832 Margo Ct

Property Tax No: 2943-192-50-019

Subdivision: Summer Glen

Property Owner: Paul Rodriguez

Owner's Telephone: \_\_\_\_\_

Owner's Address: 2832 Margo Ct

Contractor's Name: \_\_\_\_\_

Contractor's Telephone: \_\_\_\_\_

Contractor's Address: \_\_\_\_\_

Fence Material & Height: Left cedar, 3' split rail

Plot plan must show property lines and property dimensions, all easements, all rights-of-way, all structures, all setbacks from property lines, and fence height(s). NOTE: Property line is likely one foot or more behind the sidewalk.

**THIS SECTION TO BE COMPLETED BY COMMUNITY DEVELOPMENT DEPARTMENT STAFF**

ZONE RMF-8 SETBACKS: Front 20' from property line (PL) or  
 SPECIAL CONDITIONS \_\_\_\_\_ from center of ROW, whichever is greater.  
 Side 0' from PL Rear 0' from PL

Fences exceeding six feet in height require a separate permit from the City/County Building Department. A fence constructed on a corner lot that extends past the rear of the house along the side yard or abuts an alley requires approval from the City Engineer (Section 4.1.J of the Grand Junction Zoning and Development Code).

The owner/applicant must correctly identify all property lines, easements, and rights-of-way and ensure the fence is located within the property's boundaries. Covenants, conditions, restrictions, easements and/or rights-of-way may restrict or prohibit the placement of fence(s). The owner/applicant is responsible for compliance with covenants, conditions, and restrictions which may apply. Fences built in easements may be subject to removal at the property owner's sole and absolute expense. Any modification of design and/or material as approved in this fence permit must be approved, in writing, by the Community Development Department Director.

I hereby acknowledge that I have read this application and the information and plot plan are correct; I agree to comply with any and all codes, ordinances, laws, regulations, or restrictions which apply. I understand that failure to comply shall result in legal action, which may include but not necessarily be limited to removal of the fence(s) at the owner's cost.

Applicant's Signature Corene Miles

Date Aug 11, 2006

Community Development's Approval Yishi Ma

Date 8/11/06

City Engineer's Approval (if required) \_\_\_\_\_

Date \_\_\_\_\_

VALID FOR SIX MONTHS FROM DATE OF ISSUANCE (Section 2.2.E.1.d Grand Junction Zoning & Development Code)



(White: Planning) (Yellow: Customer) (Pink: Code Enforcement)

*For future reference:  
 This area cannot be covered.*

*as modified  
 1-19-09*

*1/25/06*

ACCEPTED NA ~~XXXX~~  
 ANY CHANGE OF SETBACKS MUST BE APPROVED BY THE CITY PLANNING DEPARTMENT. THE PLANNING DEPARTMENT WILL PROPERLY LOCATE AND IDENTIFY EASEMENTS AND PROPERTY LINES.

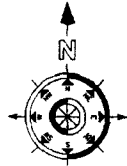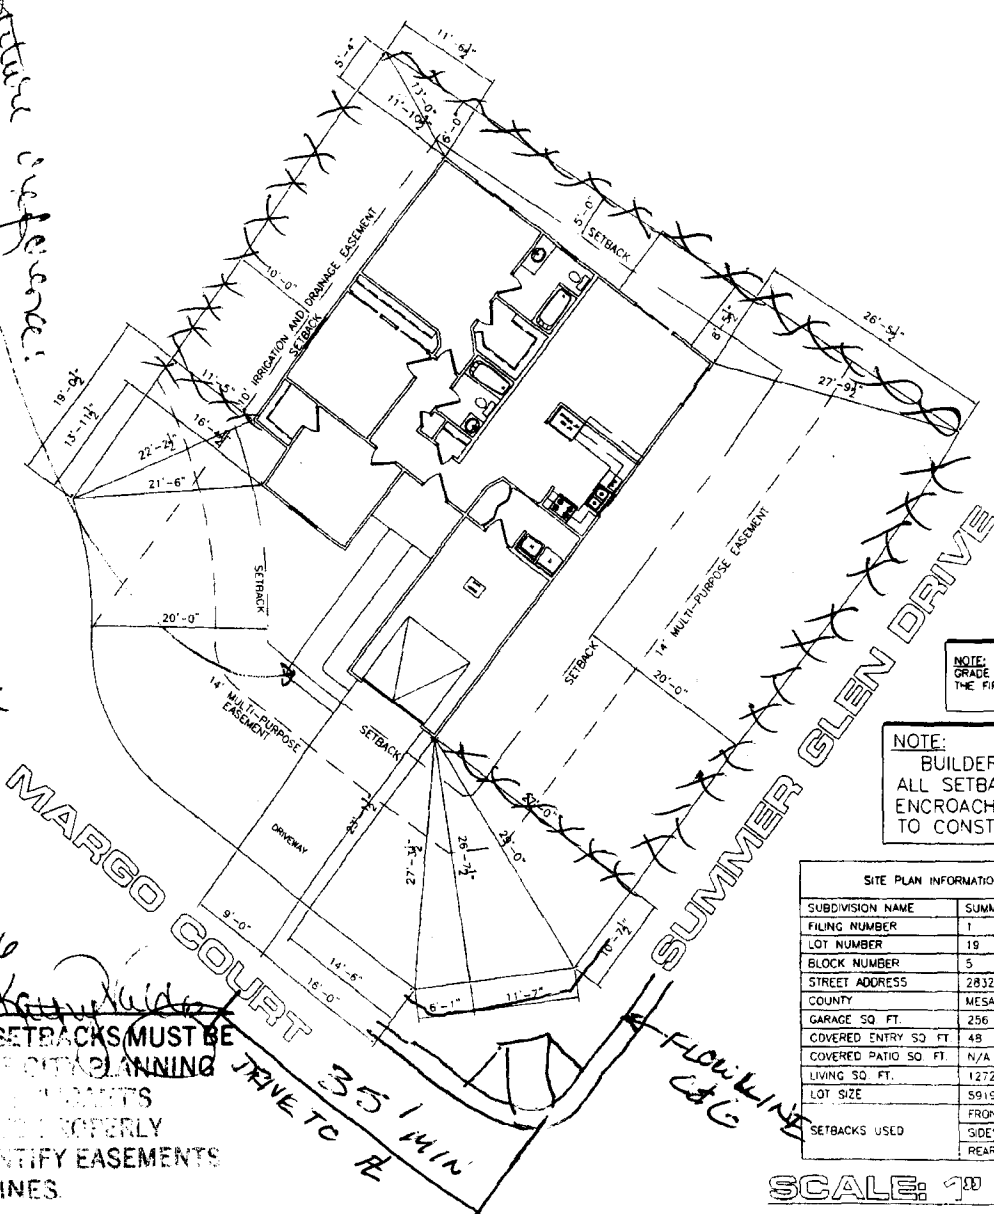

NOTE:  
 DIMENSION LINES ARE PULLED FROM EDGE OF BRICK LEDGE. IF NO BRICK LEDGE EXISTS, DIMENSIONS WILL BE FROM EDGE OF FOUNDATION.

NOTES:  
 1. IT IS THE RESPONSIBILITY OF THE BUILDER OR OWNER TO VERIFY ALL DETAILS AND CONDITIONS PRIOR TO CONSTRUCTION.  
 2. USE OF THIS PLAN CONSTITUTES BUILDER AND OR HOME OWNER'S ACCEPTANCE OF THESE TERMS.  
 3. ALL DIMENSIONS ARE TO EDGE OF FOUNDATION UNLESS OTHERWISE NOTED.  
 4. BUILDER AND OR OWNER TO VERIFY ALL SETBACKS AND EASEMENTS.  
 5. THIS PLAN HAS NOT BEEN ENGINEERED BY AUTOCAD. SEE SEPARATE DRAWINGS BY OTHERS FOR ENGINEERING DATA.

NOTE:  
 GRADE MUST SLOPE AWAY FROM HOUSE 6" OF FALL IN THE FIRST 10' OF DISTANCE PER LOCAL BUILDING CODE.

NOTE:  
 BUILDER TO VERIFY ALL SETBACK AND EASEMENT ENCROACHMENTS PRIOR TO CONSTRUCTION

SITE PLAN INFORMATION	
SUBDIVISION NAME	SUMMER GLEN
FILING NUMBER	1
LOT NUMBER	19
BLOCK NUMBER	5
STREET ADDRESS	2832 MARGO COURT
COUNTY	MESA
GARAGE SQ. FT.	256
COVERED ENTRY SQ. FT.	48
COVERED PATIO SQ. FT.	N/A
LIVING SQ. FT.	1272
LOT SIZE	5919.4 SQ. FT.
SETBACKS USED	FRONT 20' SIDES 5' REAR 10'

SCALE: 1" = 20'-0"

COPY