

FEE \$10.00

PERMIT # 14067

# FENCE PERMIT

## GRAND JUNCTION COMMUNITY DEVELOPMENT DEPARTMENT

Property Address: 2864 ARRASTA  
 Property Tax No: 2943-301-95-005  
 Subdivision: WINDWEEP HEIGHTS  
 Property Owner: PINNACLE HOMES  
 Owner's Telephone: 216 7828  
 Owner's Address: 3111 F Rd GJ 81503  
 Contractor's Name: Bookcliff Fence + Vinyl  
 Contractor's Telephone: 216-7659  
 Contractor's Address: 2834 B.3 Rd GJ 81503  
 Fence Material & Height: Vinyl 6'

Plot plan must show property lines and property dimensions, all easements, all rights-of-way, all structures, all setbacks from property lines, and fence height(s). NOTE: Property line is likely one foot or more behind the sidewalk.

**THIS SECTION TO BE COMPLETED BY COMMUNITY DEVELOPMENT DEPARTMENT STAFF**

ZONE RSF-4 SETBACKS: Front 20 from property line (PL) or  
 SPECIAL CONDITIONS \_\_\_\_\_ from center of ROW, whichever is greater.  
 Side \_\_\_\_\_ from PL Rear \_\_\_\_\_ from PL

Fences exceeding six feet in height require a separate permit from the City/County Building Department. A fence constructed on a corner lot that extends past the rear of the house along the side yard or abuts an alley requires approval from the City Engineer (Section 4.1.J of the Grand Junction Zoning and Development Code).

The owner/applicant must correctly identify all property lines, easements, and rights-of-way and ensure the fence is located within the property's boundaries. Covenants, conditions, restrictions, easements and/or rights-of-way may restrict or prohibit the placement of fence(s). The owner/applicant is responsible for compliance with covenants, conditions, and restrictions which may apply. Fences built in easements may be subject to removal at the property owner's sole and absolute expense. Any modification of design and/or material as approved in this fence permit must be approved, in writing, by the Community Development Department Director.

I hereby acknowledge that I have read this application and the information and plot plan are correct; I agree to comply with any and all codes, ordinances, laws, regulations, or restrictions which apply. I understand that failure to comply shall result in legal action, which may include but not necessarily be limited to removal of the fence(s) at the owner's cost.

Applicant's Signature Robert B. Bishop Date 7-5-06  
 Community Development's Approval [Signature] Date 7/5/06  
 City Engineer's Approval (if required) \_\_\_\_\_ Date \_\_\_\_\_

VALID FOR SIX MONTHS FROM DATE OF ISSUANCE (Section 2.2.E.1.d Grand Junction Zoning & Development Code)


(White: Planning) (Yellow: Customer) (Pink: Code Enforcement)

2864  
Araska

SCALE: 1/2"=1'-0"

LAND SQ. FT.	1007
LOT SQ.	1007
TOTAL	1007
AREA USED	
AREA 1	
AREA 2	
AREA 3	


7/5/06

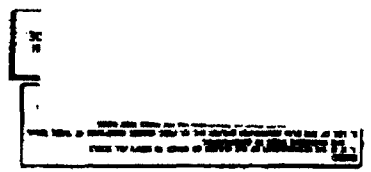


523-5272  
Henry  
Att.

Due 7/10

CLARK / Shumard

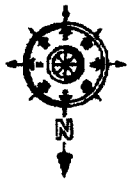

289'  
6' White  
Viny /  
Gates  
2-5'  
1-4'  
1-3'  
(912.50)73'

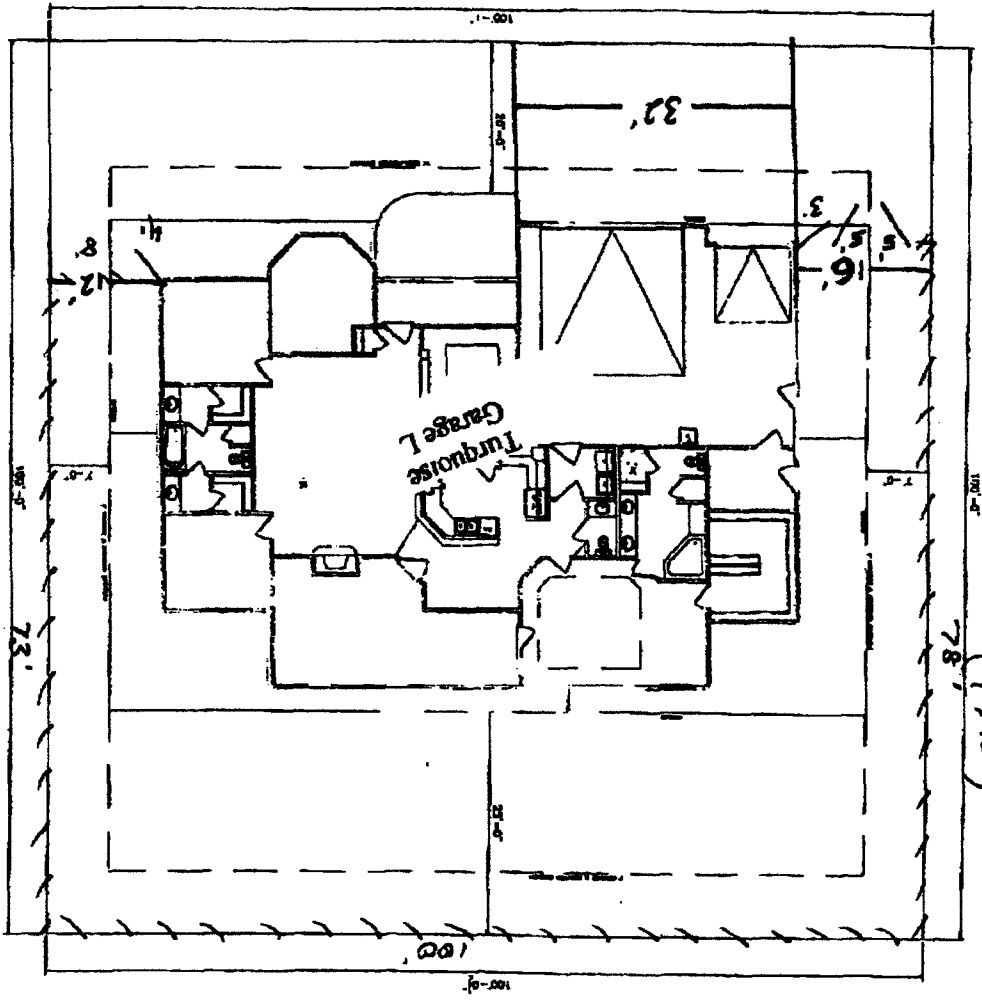

Comp Room (4975)