

FEE \$10.00

PERMIT #

13964

# FENCE PERMIT

## GRAND JUNCTION COMMUNITY DEVELOPMENT DEPARTMENT

Property Address: 2929 F 1/4 Rd

Property Tax No: 2943-053-77-003

Subdivision: \_\_\_\_\_

Property Owner: Zofia Walus

Owner's Telephone: 242-4891

Owner's Address: same

Contractor's Name: Valley Wide fence

Contractor's Telephone: 523-8150

Contractor's Address: 2105 E main

Fence Material & Height: 6' foot Privacy

Plot plan must show property lines and property dimensions, all easements, all rights-of-way, all structures, all setbacks from property lines, and fence height(s). NOTE: Property line is likely one foot or more behind the sidewalk.

**THIS SECTION TO BE COMPLETED BY COMMUNITY DEVELOPMENT DEPARTMENT STAFF**

ZONE Rmf-3 SETBACKS: Front 20 from property line (PL) or  
 SPECIAL CONDITIONS \_\_\_\_\_ from center of ROW, whichever is greater.  
 Side 0 from PL Rear 0 from PL

Fences exceeding six feet in height require a separate permit from the City/County Building Department. A fence constructed on a corner lot that extends past the rear of the house along the side yard or abuts an alley requires approval from the City Engineer (Section 4.1.J of the Grand Junction Zoning and Development Code).

The owner/applicant must correctly identify all property lines, easements, and rights-of-way and ensure the fence is located within the property's boundaries. Covenants, conditions, restrictions, easements and/or rights-of-way may restrict or prohibit the placement of fence(s). The owner/applicant is responsible for compliance with covenants, conditions, and restrictions which may apply. Fences built in easements may be subject to removal at the property owner's sole and absolute expense. Any modification of design and/or material as approved in this fence permit must be approved, in writing, by the Community Development Department Director.

I hereby acknowledge that I have read this application and the information and plot plan are correct; I agree to comply with any and all codes, ordinances, laws, regulations, or restrictions which apply. I understand that failure to comply shall result in legal action, which may include but not necessarily be limited to removal of the fence(s) at the owner's cost.

Applicant's Signature Cherynn Kallbeck

Date 5/24/06

Community Development's Approval Judith A. Furr

Date 6/21/06

City Engineer's Approval (if required) n.a.

Date \_\_\_\_\_

VALID FOR SIX MONTHS FROM DATE OF ISSUANCE (Section 2.2.E.1.d Grand Junction Zoning & Development Code)

(White: Planning)

(Yellow: Customer)


(Pink: Code Enforcement)

2929 F 1/4 ROAD - LOT 3 - FORREST ESTATES SUBDIVISION

SITE/PLOT PLAN - ~~DEVELOPER'S USE~~ (20)

P.O. Box 445  
Clifton, CO 81520


(970) 523-8150  
Fax: (970) 523-5272

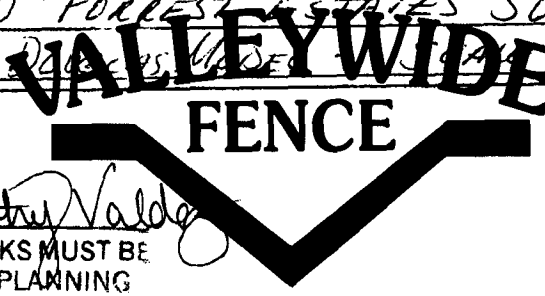


ACCEPTED NA *Kathy Valdez*


ANY CHANGES TO SETBACKS MUST BE APPROVED BY THE CITY PLANNING DEPARTMENT. THE APPLICANT'S RESPONSIBILITY TO PROPERLY LOCATE AND IDENTIFY EASEMENTS AND PROPERTY LINES.

2105 E. Main St. Grand Junction, CO 81501

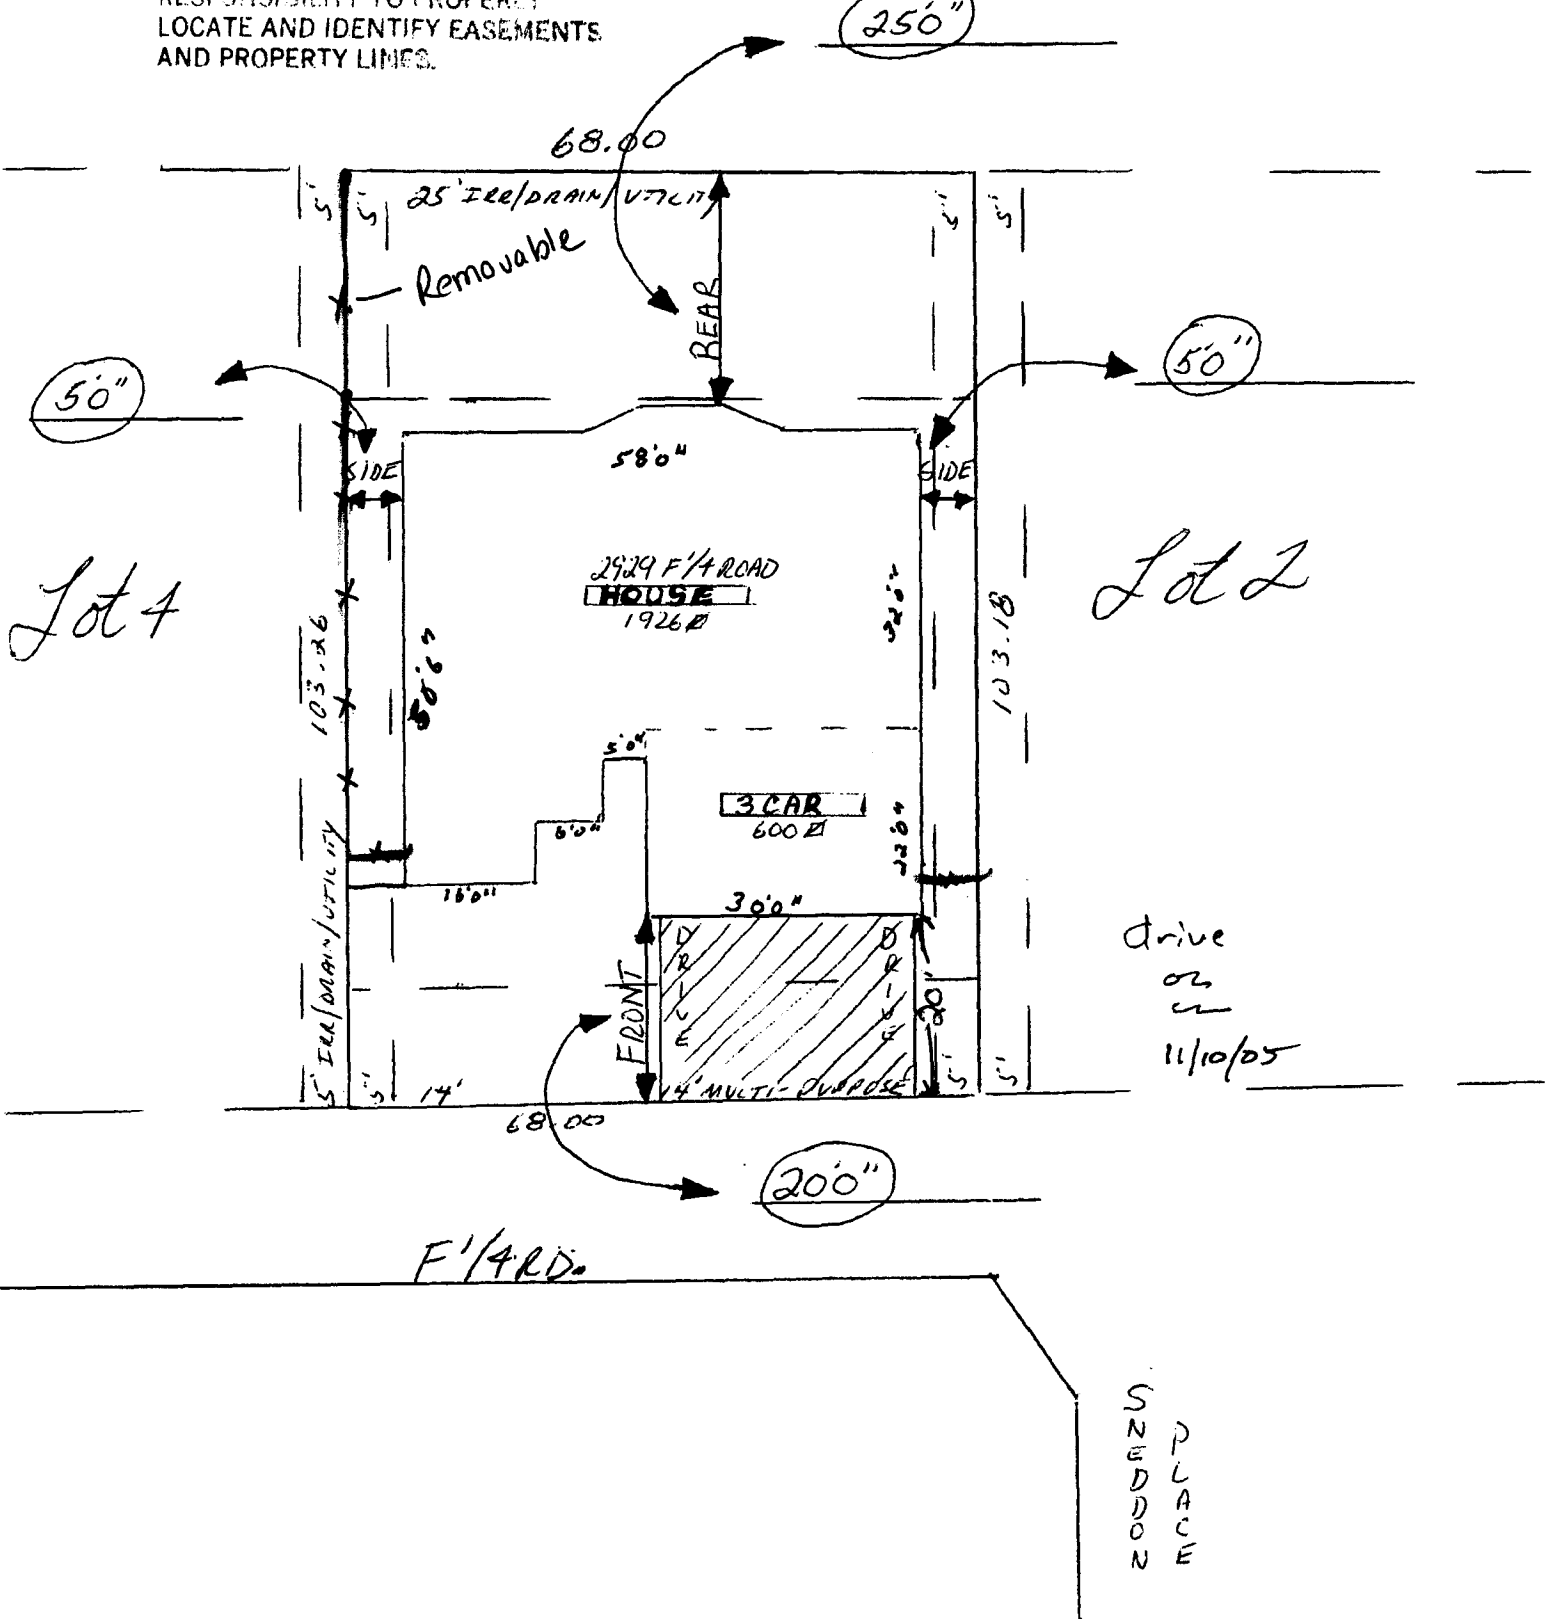

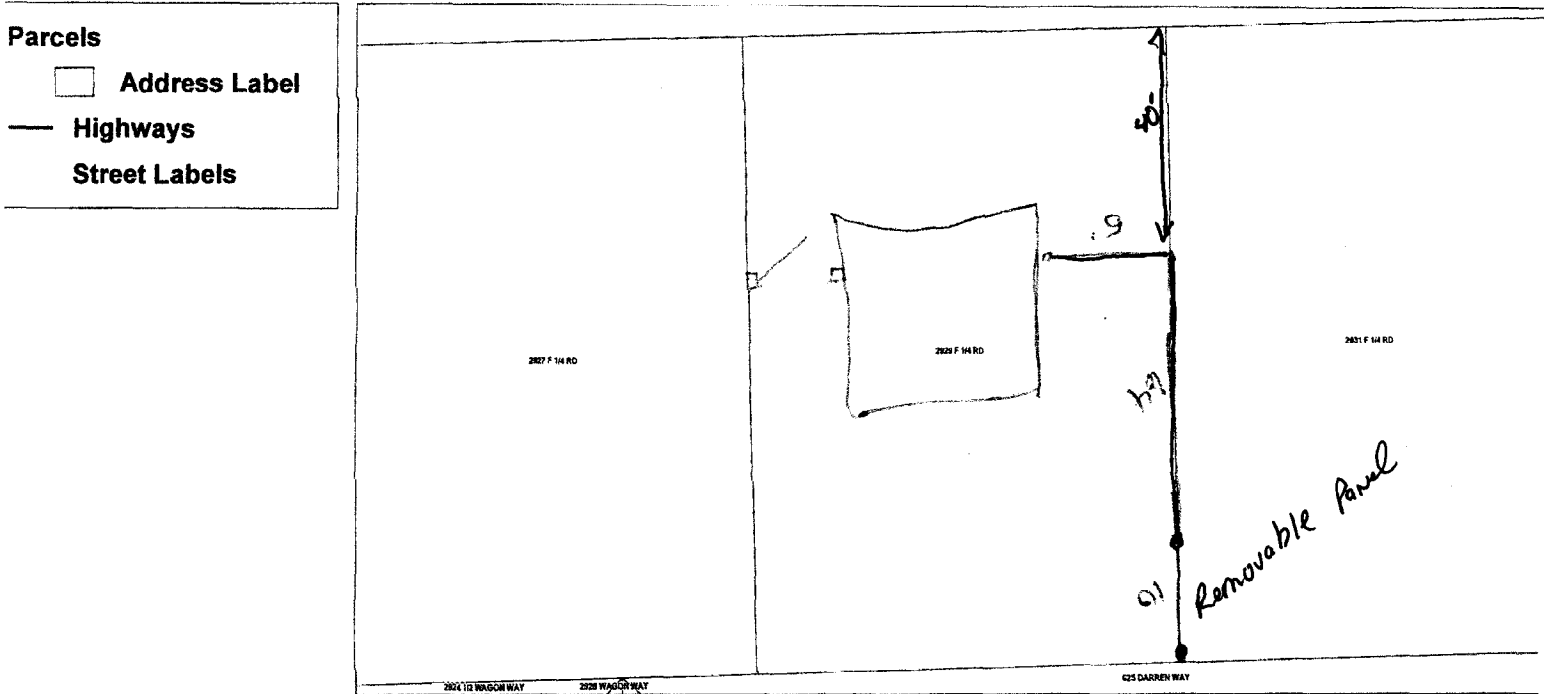

SCALE 1 : 375

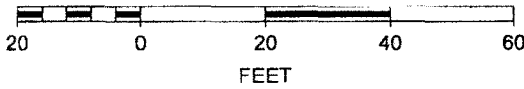

Zofia Wallus  
2929 F 1/4 Rd  
Grand Junction, Co 81504