

FEE \$10.00

PERMIT # 14106

FENCE PERMIT
GRAND JUNCTION COMMUNITY DEVELOPMENT DEPARTMENT

Property Address: 3014 Regal Glen Ct. Grand Jet., CO 81504
Property Tax No: 2943-043-08-005
Subdivision: monarch Glen
Property Owner: Bradley & Jesse Anderson
Owner's Telephone: (970) 523-5444
Owner's Address: 3014 Regal Glen Ct.
Contractor's Name: Five Star construction
Contractor's Telephone:
Contractor's Address:
Fence Material & Height: 6 foot cedar fence

Plot plan must show property lines and property dimensions, all easements, all rights-of-way, all structures, all setbacks from property lines, and fence height(s). NOTE: Property line is likely one foot or more behind the sidewalk.

THIS SECTION TO BE COMPLETED BY COMMUNITY DEVELOPMENT DEPARTMENT STAFF

ZONE RSF-4 SETBACKS: Front 20' from property line (PL) or
SPECIAL CONDITIONS \_\_\_\_\_ from center of ROW, whichever is greater.
Side 0 from PL Rear 0 from PL

Fences exceeding six feet in height require a separate permit from the City/County Building Department. A fence constructed on a corner lot that extends past the rear of the house along the side yard or abuts an alley requires approval from the City Engineer (Section 4.1.J of the Grand Junction Zoning and Development Code).

The owner/applicant must correctly identify all property lines, easements, and rights-of-way and ensure the fence is located within the property's boundaries. Covenants, conditions, restrictions, easements and/or rights-of-way may restrict or prohibit the placement of fence(s). The owner/applicant is responsible for compliance with covenants, conditions, and restrictions which may apply. Fences built in easements may be subject to removal at the property owner's sole and absolute expense. Any modification of design and/or material as approved in this fence permit must be approved, in writing, by the Community Development Department Director.

I hereby acknowledge that I have read this application and the information and plot plan are correct; I agree to comply with any and all codes, ordinances, laws, regulations, or restrictions which apply. I understand that failure to comply shall result in legal action, which may include but not necessarily be limited to removal of the fence(s) at the owner's cost.

Applicant's Signature [Signature] Date 7/13/06
Community Development's Approval [Signature] Date 7/13/06
City Engineer's Approval (if required) n.a. Date

VALID FOR SIX MONTHS FROM DATE OF ISSUANCE (Section 2.2.E.1.d Grand Junction Zoning & Development Code)

(White: Planning) (Yellow: Customer) (Pink: Code Enforcement)


# IMPROVEMENT LOCATION CERTIFICATE

3014 REGAL GLEN COURT

SECURITY TITLE S0142636  
 ANDERSON ACCOUNT  
 LOT 5 IN BLOCK 4 OF MONARCH GLEN SUBDIVISION,  
 MESA COUNTY, COLORADO.



SCALE: 1" = 20'

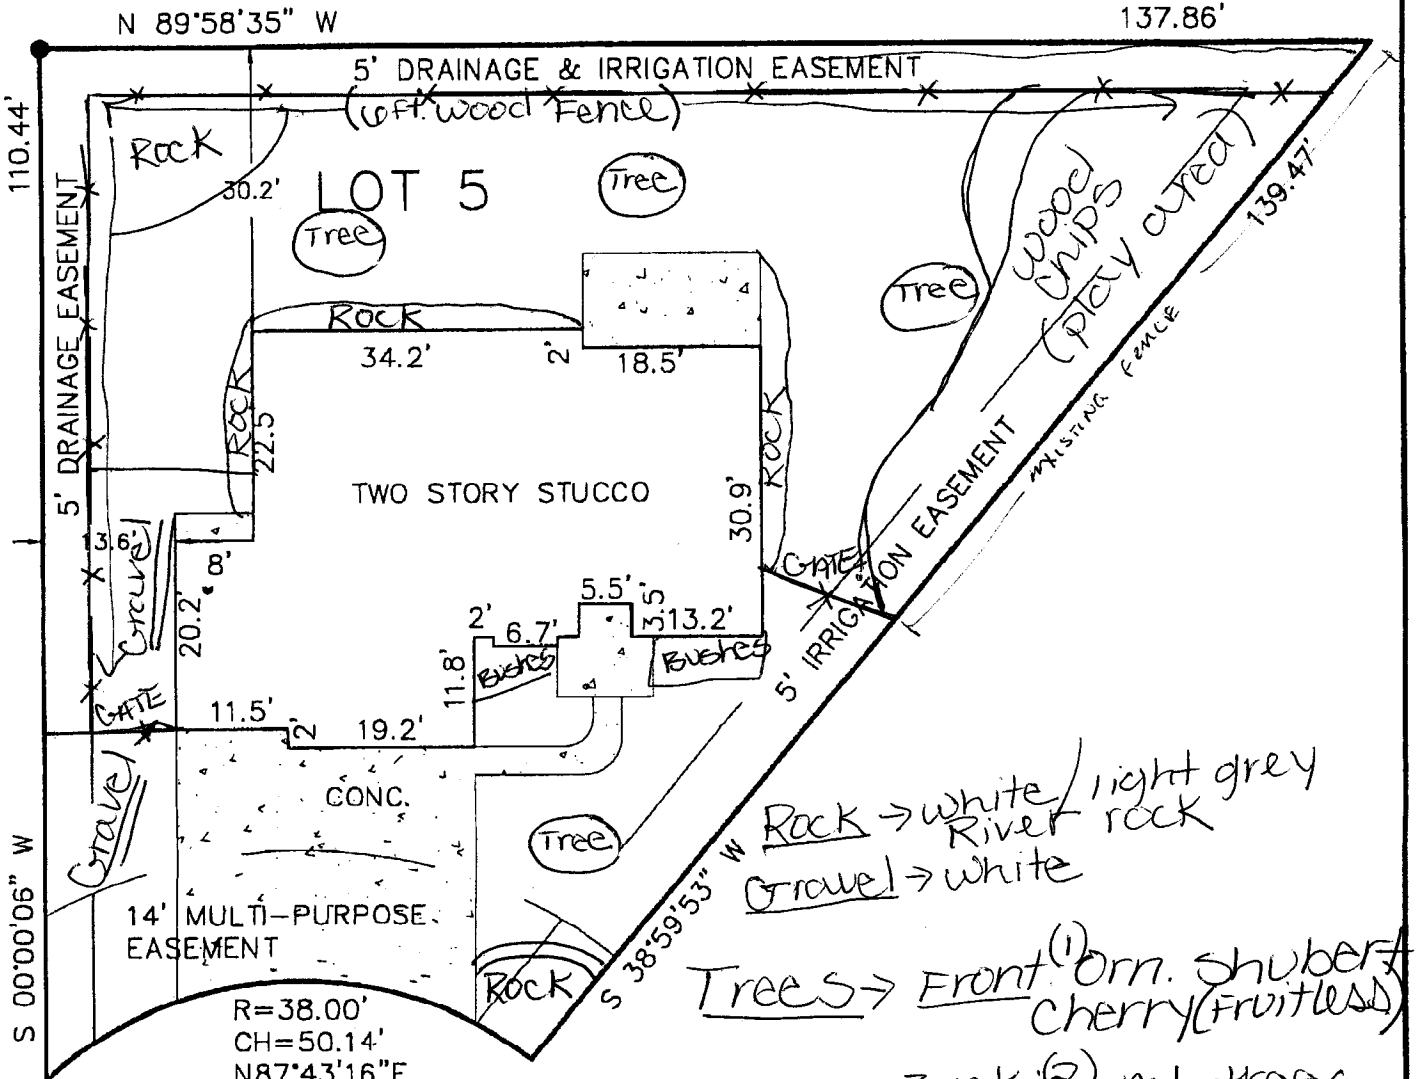

Rock → white / light grey  
 River rock

Gravel → white

Trees → Front (1) Orn. Shubert  
 Cherry (fruitless)

Back (2) Ash trees  
 (1) sunburst  
 honey locust.

Bushes → Barberry, Lilac,  
 Potentilla, yew, watacarnus,  
 Butterfly w. Juniper.

● = FOUND #5 REBAR WITH CAP

I HEREBY CERTIFY THAT THIS IMPROVEMENT LOCATION CERTIFICATE WAS PREPARED FOR BRAY & COMPANY  
 THAT IT IS NOT A LAND SURVEY PLAT OR IMPROVEMENT SURVEY PLAT, AND THAT IT IS NOT TO BE RELIED UPON FOR THE ESTABLISHMENT  
 OF FENCE, BUILDING OR OTHER FUTURE IMPROVEMENT LINES. I FURTHER CERTIFY THE IMPROVEMENTS ON THE ABOVE DESCRIBED PARCEL ON  
 THIS DATE, 6/12/06 EXCEPT UTILITY CONNECTIONS, ARE ENTIRELY WITHIN THE BOUNDARIES OF THE PARCEL, EXCEPT AS  
 SHOWN, THAT THERE ARE NO ENCROACHMENTS UPON THE DESCRIBED PREMISES BY IMPROVEMENTS ON ANY ADJOINING PREMISES, EXCEPT AS  
 INDICATED, AND THAT THERE IS NO EVIDENCE OR SIGN OF ANY EASEMENT CROSSING OR BURDENSING ANY PART OF SAID PARCEL, EXCEPT AS  
 NOTED.