



Fence Permit

PERMIT # 14990

Community Development Department
250 North 5th Street
Grand Junction, CO 81501
Phone: (970) 244-1430 FAX (970) 236-4031

FEE \$10.00

Handwritten mark

Property Address: 1202 WALNUT ST.

Property Tax No: 2945-122-41-010

Subdivision: FAIRMOUNT VILLAGE CONDOMINIUMS

Property Owner: JBB CORP.

Owner's Telephone: 303-278-7667

Owner's Address: 93 S. DEVINNEY ST., GOLDEN, CO. 80401

Contractor's Name: D & M CONSTRUCTION

Contractor's Telephone: 970-242-1914

Contractor's Address: 1309 N. 1ST. ST. GRAND JUNCTION, CO. 81501

Fence Material & Height: 6' CEDAR PICKET

Plot plan must show property lines and property dimensions, all easements, all rights-of-way, all structures, all setbacks from property lines, and fence height(s). NOTE: Property line is likely one foot or more behind the sidewalk.

THIS SECTION TO BE COMPLETED BY COMMUNITY DEVELOPMENT DEPARTMENT STAFF

ZONE R12+ SETBACKS: Front _____ from property line (PL) or

SPECIAL CONDITIONS _____ from center of ROW, whichever is greater.

Side _____ from PL Rear _____ from PL

Fences exceeding six feet in height require a separate permit from the City/County Building Department. A fence constructed on a corner lot that extends past the rear of the house along the side yard or abuts an alley requires approval from the City Engineer (Section 4.1.J of the Grand Junction Zoning and Development Code).

The owner/applicant must correctly identify all property lines, easements, and rights-of-way and ensure the fence is located within the property's boundaries. Covenants, conditions, restrictions, easements and/or rights-of-way may restrict or prohibit the placement of fence(s). The owner/applicant is responsible for compliance with covenants, conditions, and restrictions which may apply. Fences built in easements may be subject to removal at the property owner's sole and absolute expense. Any modification of design and/or material as approved in this fence permit must be approved, in writing, by the Community Development Department Director.

I hereby acknowledge that I have read this application and the information and plot plan are correct; I agree to comply with any and all codes, ordinances, laws, regulations, or restrictions which apply. I understand that failure to comply shall result in legal action, which may include but not necessarily be limited to removal of the fence(s) at the owner's cost.

Applicant's Signature Bill Moss Date 10-15-07

Community Development's Approval Wendy Spurr Date 10-16-07

City Engineer's Approval (if required) _____ Date _____


VALID FOR SIX MONTHS FROM DATE OF ISSUANCE (Section 2.2.E.1.d Grand Junction Zoning & Development Code)

(White: Community Development) (Yellow: Applicant) (Pink: Code Enforcement)

12TH STREET

BOOK CLIFF AVENUE

WALNUT AVENUE

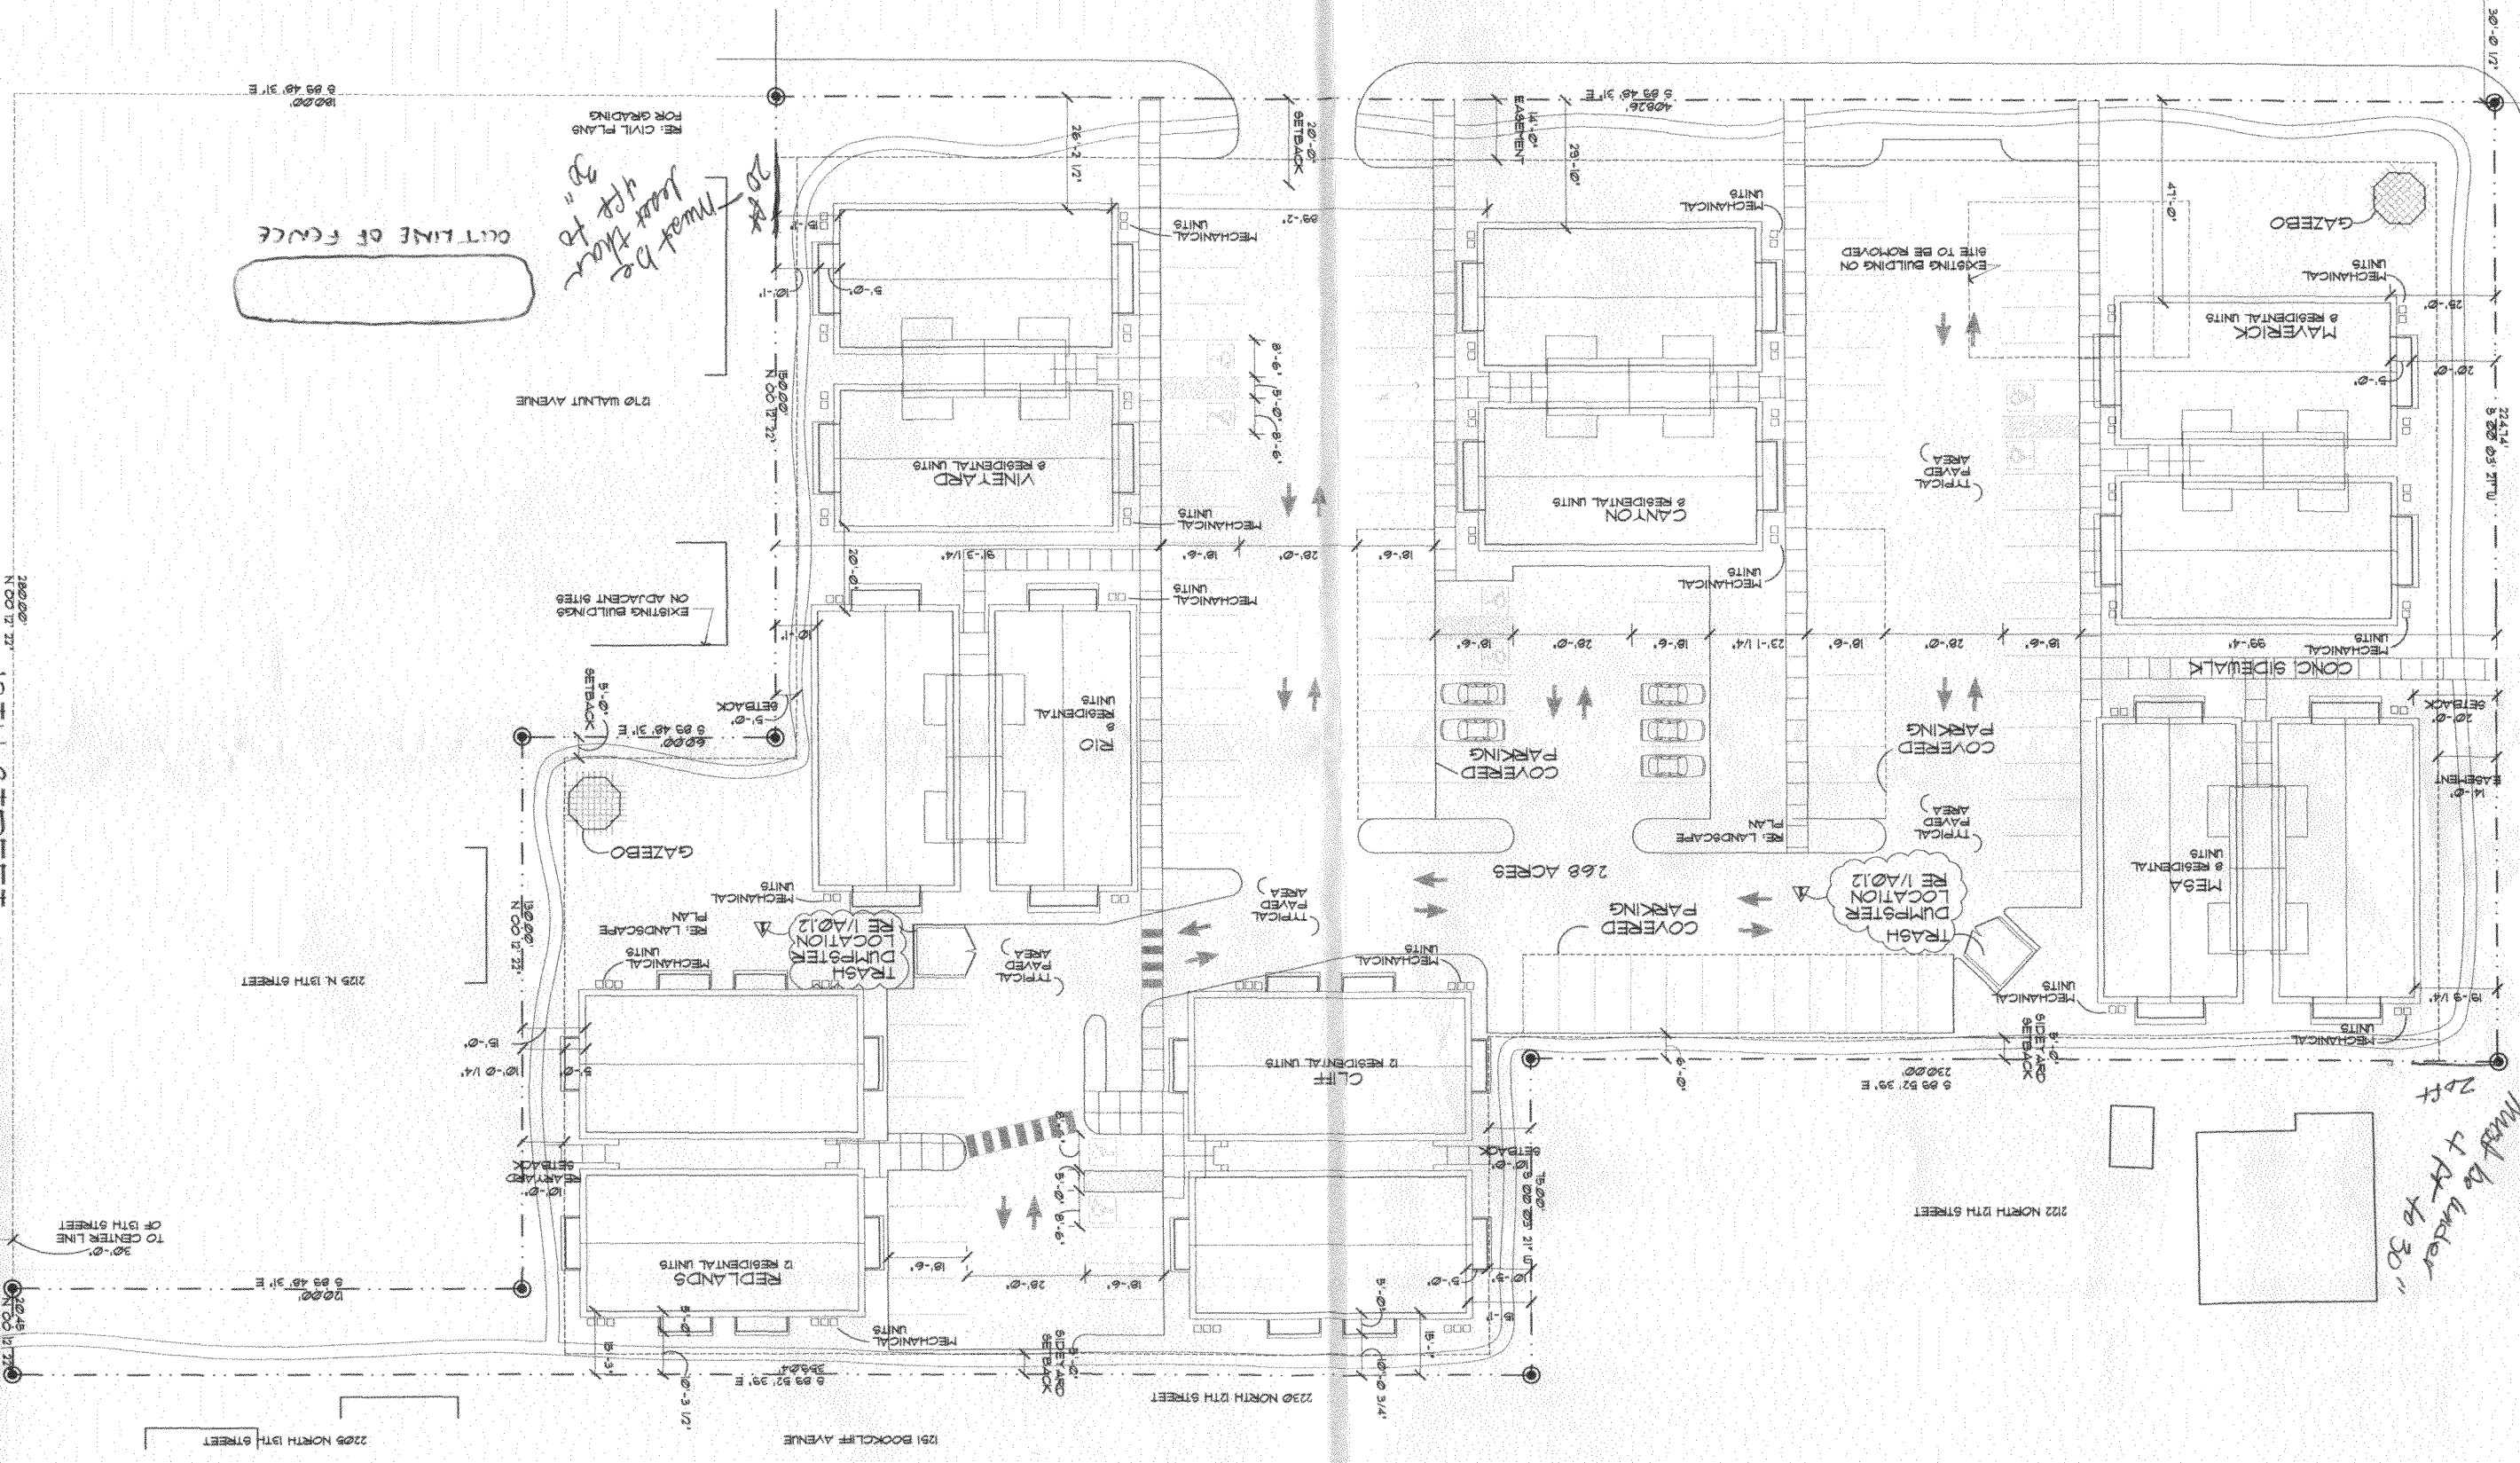

CUTLINE OF FENCE

*Must be
4 ft to 30"*

*Must be under
4 ft to 30"*

13TH STREET

TO CENTER LINE
OF 13TH STREET

2209 NORTH 13TH STREET

2209 NORTH 13TH STREET

2209 NORTH 13TH STREET

2209 NORTH 13TH STREET