



# Fence Permit

PERMIT # 15249

Community Development Department  
250 North 5<sup>th</sup> Street  
Grand Junction, CO 81501  
Phone: (970) 244-1430 FAX (970) 236-4031

FEE \$10.00

Property Address: 2660 BANGS CANYON DR  
2945-351-45-087  
 Subdivision: SPY GLASS RIDGE  
 Property Owner: NATHAN STATON  
 Owner's Telephone: 970 241 1301  
 Owner's Address: SAA  
 Contractor's Name: OWNER  
 Contractor's Telephone: OWNER  
 Contractor's Address: SAA  
 Fence Material & Height: 1 X 6 CEDAR 6' TALL

Plot plan must show property lines and property dimensions, all easements, all rights-of-way, all structures, all setbacks from property lines, and fence height(s). NOTE: Property line is likely one foot or more behind the sidewalk.

THIS SECTION TO BE COMPLETED BY COMMUNITY DEVELOPMENT DEPARTMENT STAFF	
ZONE <u>RSF-2 / Cluster</u>	SETBACKS: Front _____ from property line (PL) or
SPECIAL CONDITIONS _____	_____ from center of ROW, whichever is greater.
_____	Side _____ from PL Rear _____ from PL

Fences exceeding six feet in height require a separate permit from the City/County Building Department. A fence constructed on a corner lot that extends past the rear of the house along the side yard or abuts an alley requires approval from the City Engineer (Section 4.1.J of the Grand Junction Zoning and Development Code).

The owner/applicant must correctly identify all property lines, easements, and rights-of-way and ensure the fence is located within the property's boundaries. Covenants, conditions, restrictions, easements and/or rights-of-way may restrict or prohibit the placement of fence(s). The owner/applicant is responsible for compliance with covenants, conditions, and restrictions which may apply. Fences built in easements may be subject to removal at the property owner's sole and absolute expense. Any modification of design and/or material as approved in this fence permit must be approved, in writing, by the Community Development Department Director.

I hereby acknowledge that I have read this application and the information and plot plan are correct; I agree to comply with any and all codes, ordinances, laws, regulations, or restrictions which apply. I understand that failure to comply shall result in legal action, which may include but not necessarily be limited to removal of the fence(s) at the owner's cost.



Applicant's Signature [Signature] Date 7-6-07  
 Community Development's Approval [Signature] Date 7-11-07  
 City Engineer's Approval (if required) \_\_\_\_\_ Date \_\_\_\_\_

VALID FOR SIX MONTHS FROM DATE OF ISSUANCE (Section 2.2.E.1.d Grand Junction Zoning & Development Code)

(White: Community Development) (Yellow: Applicant) (Pink: Code Enforcement)

# TYPICAL EXTERIOR WALL SECTION

SCALE: 1/8" = 1'-0"

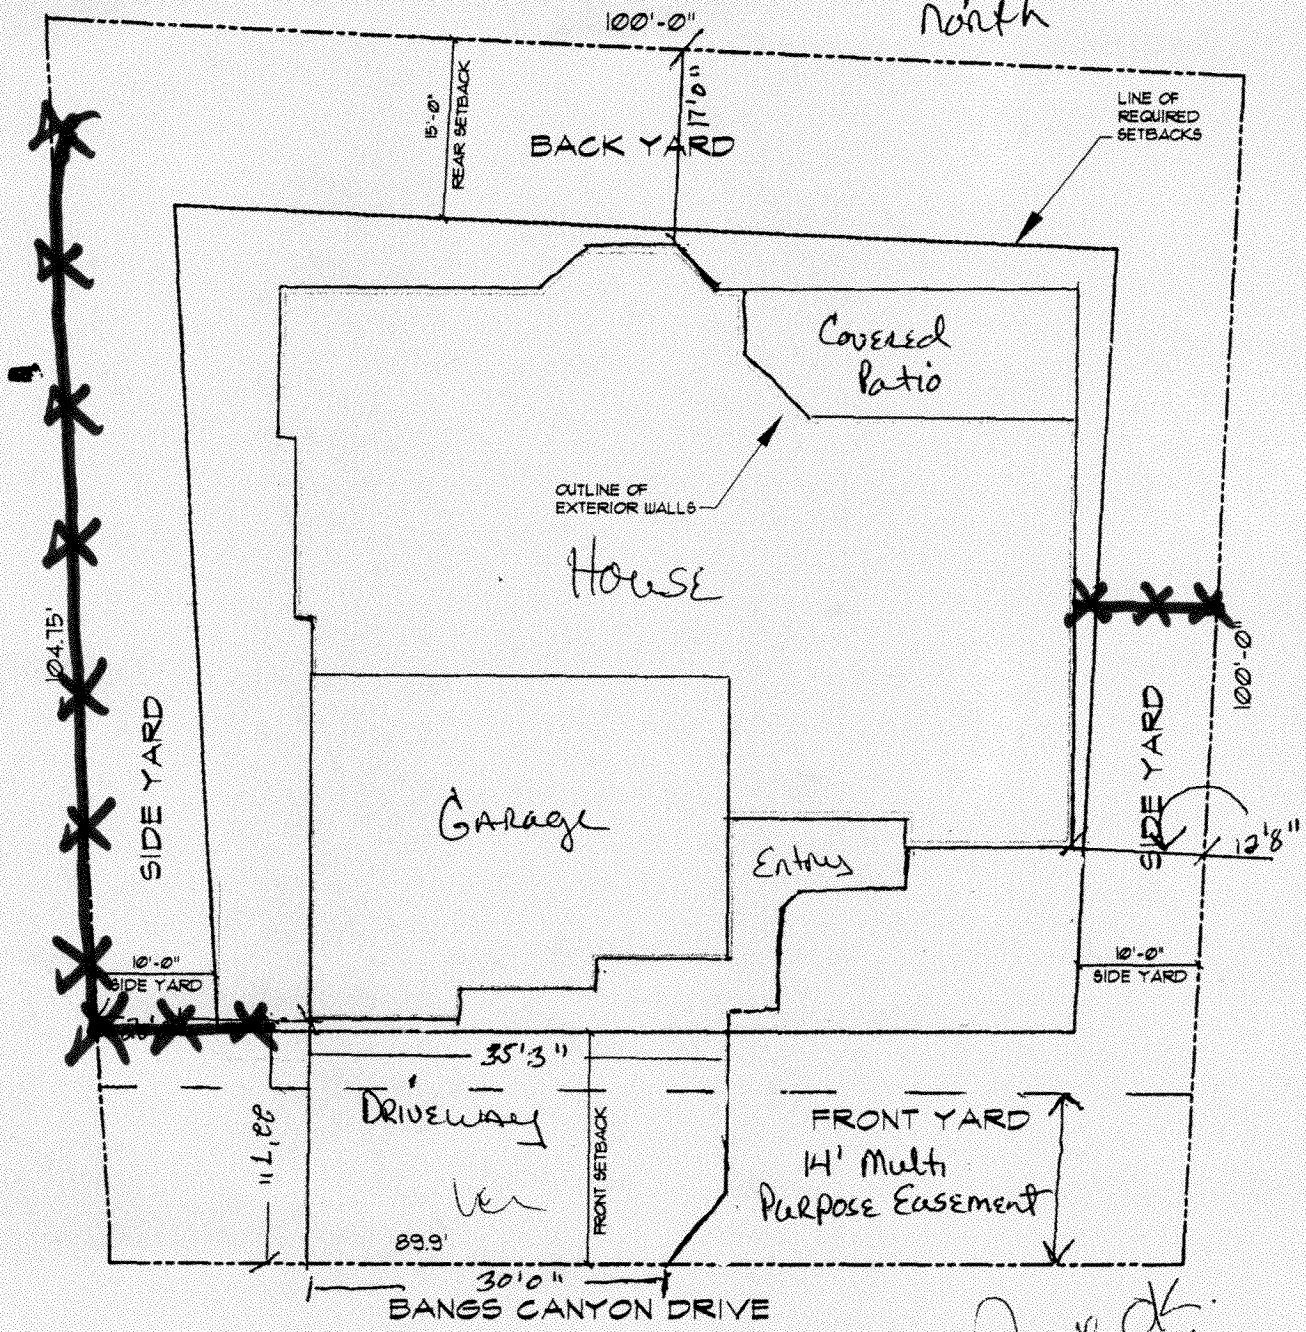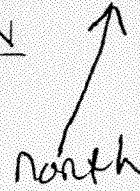


C:\Documents and Settings\Nathan\My Documents\AutoCAD\Projects\Stationer\21526660 Bangs Canyon.dwg, 12/05/06 at 10:34 AM



## STATION RESIDENCE SITE PLAN

SCALE: 1/8" = 1'-0"  
NOTE: NOT TO SCALE UNLESS PRINTED ON 24" X 36" PRINT

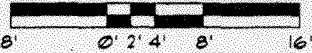

*Duneck*  
*SPK*  
*12/15/06*

Lot # 211 Filing # 2  
Spy Glass Ridge Subdivision  
2660 Bangs Canyon Dr.  
Parcel # 2945-351-45-087

2-12-07  
Rayleen Henderson