



# Fence Permit

PERMIT # 15232

Community Development Department  
250 North 5<sup>th</sup> Street  
Grand Junction, CO 81501  
Phone: (970) 244-1430 FAX (970) 236-4031

FEE \$10.00

Property Address: 2822 Meade Court, Grand Jct, CO 81506  
 Property Tax No: 2943-063-45-008  
 Subdivision: Village Park  
 Property Owner: Zachary & Brandee Kingery  
 Owner's Telephone: 970-256-1120  
 Owner's Address: 2822 Meade Court, Grand Jct, CO 81506  
 Contractor's Name: \_\_\_\_\_  
 Contractor's Telephone: \_\_\_\_\_  
 Contractor's Address: \_\_\_\_\_  
 Fence Material & Height: WOOD, 6ft

Plot plan must show property lines and property dimensions, all easements, all rights-of-way, all structures, all setbacks from property lines, and fence height(s). NOTE: Property line is likely one foot or more behind the sidewalk.

THIS SECTION TO BE COMPLETED BY COMMUNITY DEVELOPMENT DEPARTMENT STAFF	
ZONE <u>PD</u>	SETBACKS: Front <u>20 garage</u> <del>15 house</del> from property line (PL) or _____ from center of ROW, whichever is greater.
SPECIAL CONDITIONS _____	Side <u>0</u> from PL Rear <u>0</u> from PL

Fences exceeding six feet in height require a separate permit from the City/County Building Department. A fence constructed on a corner lot that extends past the rear of the house along the side yard or abuts an alley requires approval from the City Engineer (Section 4.1.J of the Grand Junction Zoning and Development Code).

The owner/applicant must correctly identify all property lines, easements, and rights-of-way and ensure the fence is located within the property's boundaries. Covenants, conditions, restrictions, easements and/or rights-of-way may restrict or prohibit the placement of fence(s). The owner/applicant is responsible for compliance with covenants, conditions, and restrictions which may apply. Fences built in easements may be subject to removal at the property owner's sole and absolute expense. Any modification of design and/or material as approved in this fence permit must be approved, in writing, by the Community Development Department Director.

I hereby acknowledge that I have read this application and the information and plot plan are correct; I agree to comply with any and all codes, ordinances, laws, regulations, or restrictions which apply. I understand that failure to comply shall result in legal action, which may include but not necessarily be limited to removal of the fence(s) at the owner's cost.

Applicant's Signature Brandee Kingery Date 11 MAY 2007  
 Community Development's Approval Judson Furr Date 5/11/2007  
 City Engineer's Approval (if required) \_\_\_\_\_ Date \_\_\_\_\_

VALID FOR SIX MONTHS FROM DATE OF ISSUANCE (Section 2.2.E.1.d Grand Junction Zoning & Development Code)

(White: Community Development) (Yellow: Applicant) (Pink: Code Enforcement)

# IMPROVEMENT LOCATION CERTIFICATE

2822 MEADE COURT

MERIDIAN LAND TITLE


KINGERY ACCOUNT

LOT 8 IN BLOCK 1 OF VILLAGE PARK, FILING 2,

MESA COUNTY, COLORADO. LEGAL PROVIDED BY SONSHINE II CONST.



SCALE: 1" = 20'

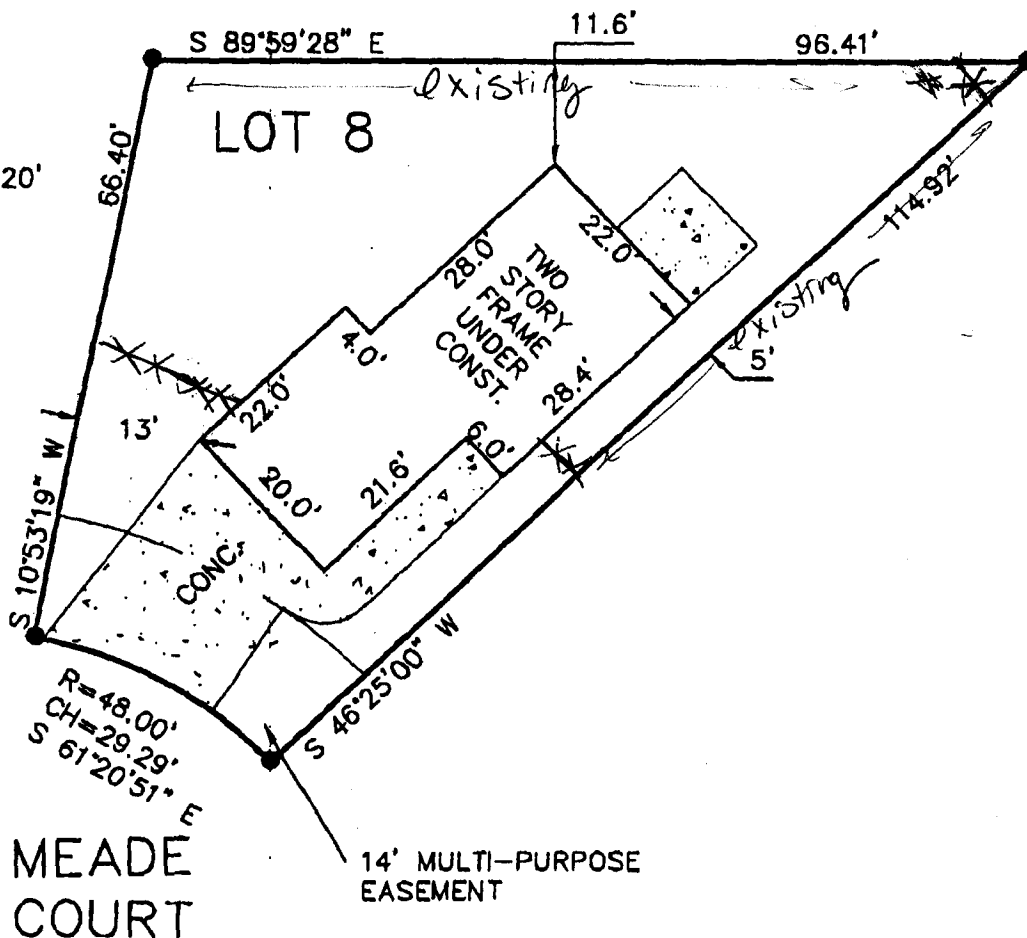

● = #5 REBAR WITH CAP

SONSHINE II CONST.

I HEREBY CERTIFY THAT THIS IMPROVEMENT LOCATION CERTIFICATE WAS PREPARED FOR SONSHINE II CONST. THAT IT IS NOT A LAND SURVEY PLAT OR IMPROVEMENT SURVEY PLAT, AND THAT IT IS NOT TO BE RELIED UPON FOR THE ESTABLISHMENT OF FENCE, BUILDING OR OTHER FUTURE IMPROVEMENT LINES. I FURTHER CERTIFY THE IMPROVEMENTS ON THE ABOVE DESCRIBED PARCEL ON THIS DATE, 3/24/04 EXCEPT UTILITY CONNECTIONS, ARE ENTIRELY WITHIN THE BOUNDARIES OF THE PARCEL, EXCEPT AS SHOWN, THAT THERE ARE NO ENCROACHMENTS UPON THE DESCRIBED PREMISES BY IMPROVEMENTS ON ANY ADJOINING PREMISES, EXCEPT AS INDICATED. AND THAT THERE IS NO EVIDENCE OR SIGN OF UNLAWFUL ENCROACHMENTS.