



Fence Permit

PERMIT # 14988

Community Development Department
250 North 5th Street
Grand Junction, CO 81501
Phone: (970) 244-1430 FAX (970) 236-4031

FEE \$10.00

pl

Property Address: 408 29 1/2 Rd Grand Jct., CO 81504

Property Tax No: 2943-174-40-015

Subdivision: Country Place Estates

Property Owner: Randon: Kindra Loyd

Owner's Telephone: (970) 255-1205

Owner's Address: 408 29 1/2 Rd Grand Jct., CO 81504

Contractor's Name: ST Construction

Contractor's Telephone: _____

Contractor's Address: _____

Fence Material & Height: 6 Ft Cedar

Plot plan must show property lines and property dimensions, all easements, all rights-of-way, all structures, all setbacks from property lines, and fence height(s). NOTE: Property line is likely one foot or more behind the sidewalk.

THIS SECTION TO BE COMPLETED BY COMMUNITY DEVELOPMENT DEPARTMENT STAFF

ZONE R-8 SETBACKS: Front 20 from property line (PL) or
 SPECIAL CONDITIONS _____ from center of ROW, whichever is greater.
 Side 5 from PL Rear 10 from PL

Fences exceeding six feet in height require a separate permit from the City/County Building Department. A fence constructed on a corner lot that extends past the rear of the house along the side yard or abuts an alley requires approval from the City Engineer (Section 4.1.J of the Grand Junction Zoning and Development Code).

The owner/applicant must correctly identify all property lines, easements, and rights-of-way and ensure the fence is located within the property's boundaries. Covenants, conditions, restrictions, easements and/or rights-of-way may restrict or prohibit the placement of fence(s). The owner/applicant is responsible for compliance with covenants, conditions, and restrictions which may apply. Fences built in easements may be subject to removal at the property owner's sole and absolute expense. Any modification of design and/or material as approved in this fence permit must be approved, in writing, by the Community Development Department Director.

I hereby acknowledge that I have read this application and the information and plot plan are correct; I agree to comply with any and all codes, ordinances, laws, regulations, or restrictions which apply. I understand that failure to comply shall result in legal action, which may include but not necessarily be limited to removal of the fence(s) at the owner's cost.

Applicant's Signature Kindra L. Loyd Date 10/10/07

Community Development's Approval Paul [Signature] Date 10/10/07

City Engineer's Approval (if required) _____ Date _____

VALID FOR SIX MONTHS FROM DATE OF ISSUANCE (Section 2.2.E.1.d Grand Junction Zoning & Development Code)

(White: Community Development)


(Yellow: Applicant)


(Pink: Code Enforcement)

6 ft. HIGH PRIVACY FENCE

CEDAR PICKET OR VINYL (SOLID - WHITE OR TAN)

PH

 = TAN GRAVEL

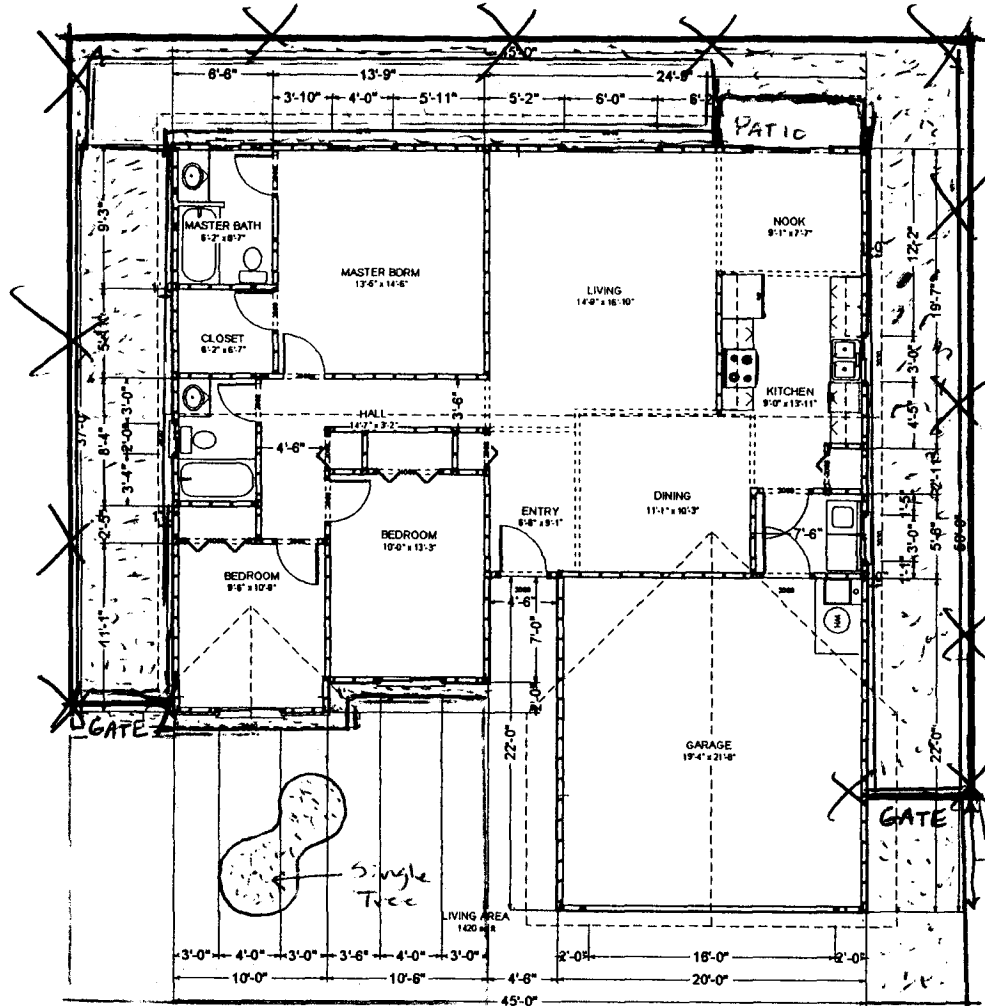

Landscaping
OK RB
5-07-07

5' to 6' to leave
Meters Accessible

> 20'
to prop loc

Fence OK
RS
20-SEP-07

408-29 1/2 Rd