



Fence Permit

PERMIT # 14999

Community Development Department
250 North 5th Street
Grand Junction, CO 81501
Phone: (970) 244-1430 FAX (970) 236-4031

FEE \$10.00

pl

Property Address: 459 CHATFIELD LANE

Property Tax No: 2943-151-16-016

Subdivision: CHATFIELD III

Property Owner: LE ANN CAMP

Owner's Telephone: 523-1033

Owner's Address: 459 CHATFIELD LANE

Contractor's Name: ARADIBERT LANDSCAPING & FENCING, INC.

Contractor's Telephone: 970-640-7463

Contractor's Address: 2840 AURIN COURT GJ, CO 81503

Fence Material & Height: CEDAR 6' HIGH

Plot plan must show property lines and property dimensions, all easements, all rights-of-way, all structures, all setbacks from property lines, and fence height(s). NOTE: Property line is likely one foot or more behind the sidewalk.

THIS SECTION TO BE COMPLETED BY COMMUNITY DEVELOPMENT DEPARTMENT STAFF

ZONE R-5 SETBACKS: Front _____ from property line (PL) or
 SPECIAL CONDITIONS _____ from center of ROW, whichever is greater.
 Side _____ from PL Rear _____ from PL

Fences exceeding six feet in height require a separate permit from the City/County Building Department. A fence constructed on a corner lot that extends past the rear of the house along the side yard or abuts an alley requires approval from the City Engineer (Section 4.1.J of the Grand Junction Zoning and Development Code).

The owner/applicant must correctly identify all property lines, easements, and rights-of-way and ensure the fence is located within the property's boundaries. Covenants, conditions, restrictions, easements and/or rights-of-way may restrict or prohibit the placement of fence(s). The owner/applicant is responsible for compliance with covenants, conditions, and restrictions which may apply. Fences built in easements may be subject to removal at the property owner's sole and absolute expense. Any modification of design and/or material as approved in this fence permit must be approved, in writing, by the Community Development Department Director.

I hereby acknowledge that I have read this application and the information and plot plan are correct; I agree to comply with any and all codes, ordinances, laws, regulations, or restrictions which apply. I understand that failure to comply shall result in legal action, which may include but not necessarily be limited to removal of the fence(s) at the owner's cost.

Applicant's Signature [Signature] Date 11/2/07

Community Development's Approval [Signature] Date 11-2-07


City Engineer's Approval (if required) _____ Date _____

VALID FOR SIX MONTHS FROM DATE OF ISSUANCE (Section 2.2.E.1.d Grand Junction Zoning & Development Code)

(White: Community Development) (Yellow: Applicant) (Pink: Code Enforcement)

NA Wendy Spurr R/H 4-18-07

PROJECT OF
 CHATFIELD III
 EASEMENT
 PROPERTY LINE

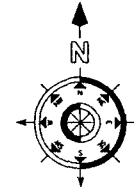


NOTE:
 BUILDER TO VERIFY
 ALL SETBACK AND EASEMENT
 ENCROACHMENTS PRIOR
 TO CONSTRUCTION

NOTE:
 DIMENSION LINES ARE PULLED FROM
 EDGE OF BRICK LEDGE. IF NO BRICK LEDGE
 EXISTS, DIMENSIONS WILL BE FROM EDGE
 OF FOUNDATION.

NOTE
 GRADE MUST SLDPE AWAY FROM HOUSE 6" OF FALL IN
 THE FIRST 10' OF DISTANCE PER LOCAL BUILDING CODE.

NOTICE:
 1. IT IS THE RESPONSIBILITY OF THE BUILDER OR OWNER TO VERIFY ALL DETAILS
 AND DIMENSIONS PRIOR TO CONSTRUCTION.
 2. USE OF THIS PLAN CONSTITUTES BUILDER AND OR HOME OWNERS ACCEPTANCE OF THESE TERMS.
 3. ALL DIMENSIONS ARE TO EDGE OF FOUNDATION UNLESS OTHER WISE NOTED.
 4. BUILDER AND OR OWNER TO VERIFY ALL SETBACKS AND EASEMENTS.
 5. THIS PLAN HAS NOT BEEN ENGINEERED BY AUTODRAFT. SEE SEPARATE DRAWINGS BY OTHERS
 FOR ENGINEERING DATA.

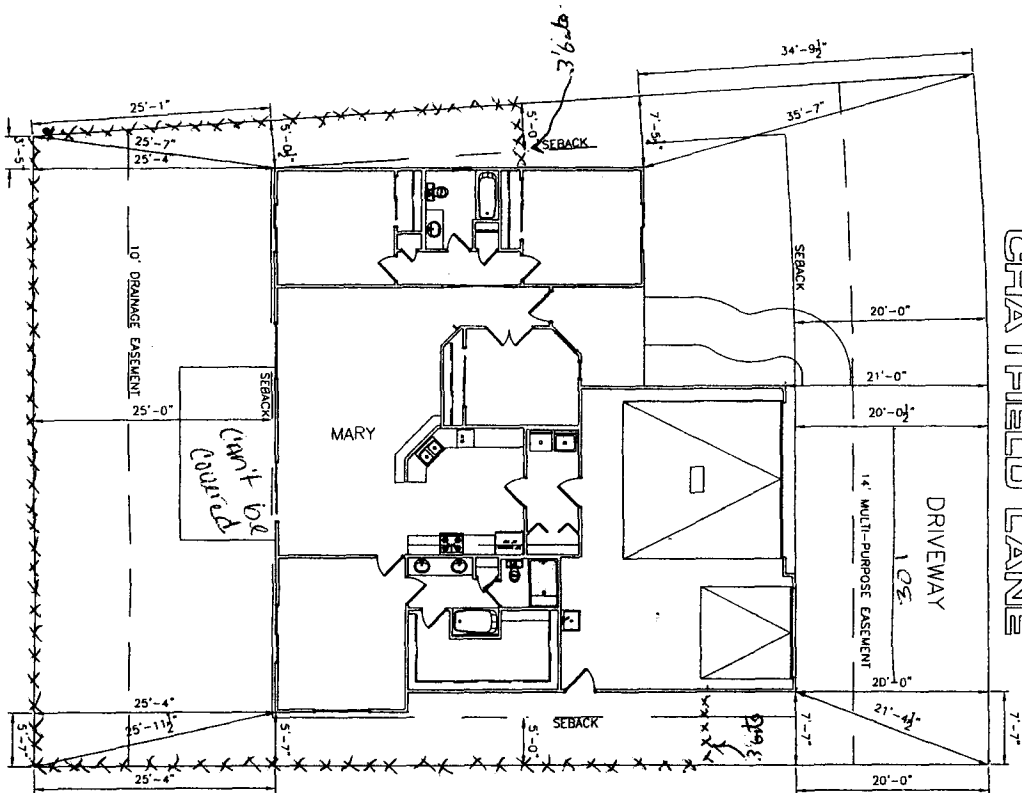

CHATFIELD LANE

Driveway OK
 R/H

SITE PLAN INFORMATION	
SUBDIVISION NAME	CHATFIELD III
FILING NUMBER	III
LOT NUMBER	16
BLOCK NUMBER	7
STREET ADDRESS	?
COUNTY	MESA
GARAGE SQ. FT.	709 SF
COVERED ENTRY SQ. FT.	84 SF
COVERED PATIO SQ. FT.	N/A
LIVING SQ. FT.	1787 SF
LOT SIZE	6799 SF
SETBACKS USED	FRONT 20' SIDES 5' REAR 25'

455 Chatfield Ln.

SCALE: 1"=20'-0"