

Fence Permit

250 North 5th Street

Grand Junction, CO 81501

Community Development Department

Phone: (970) 244-1430 FAX (970) 236-4031

PERMIT #

15111

FEE \$10.00

Property Address: <u>170 Ecos Bay St Grand Jet. Co</u>
Property Tax No: 2943-1102-94-005
Subdivision: Prairie View
Property Owner: Knoos Const Carl Coonce
Owner's Telephone: (970) 417 - 9858
Owner's Address: Same
Contractor's Name: Vallequoide Fence.
Contractor's Telephone: (970) 533-8150
Contractor's Address: 2105 E Main St. Granda let, CO
Fence Material & Height:

Plot plan must show property lines and property dimensions, all easements, all rights-of-way, all structures, all setbacks from property lines, and fence height(s). NOTE: Property line is likely one foot or more behind the sidewalk.

THIS SECTION TO BE COMPLETED BY COM	MUNITY DEVELOPMENT DEPARTMENT STAFF
ZONE KMF-5	SETBACKS: Front from property line (PL) or
SPECIAL CONDITIONS	from center of ROW, whichever is greater.
	Side from PL Rear from PL

Fences exceeding six feet in height require a separate permit from the City/County Building Department. A fence constructed on a corner lot that extends past the rear of the house along the side yard or abuts an alley requires approval from the City Engineer (Section 4.1.J of the Grand Junction Zoning and Development Code).

The owner/applicant must correctly identify all property lines, easements, and rights-of-way and ensure the fence is located within the property's boundaries. Covenants, conditions, restrictions, easements and/or rights-of-way may restrict or prohibit the placement of fence(s). The owner/applicant is responsible for compliance with covenants, conditions, and restrictions which may apply. Fences built in easements may be subject to removal at the property owner's sole and absolute expense. Any modification of design and/or material as approved in this fence permit must be approved, in writing, by the Community Development Department Director.

I hereby acknowledge that I have read this application and the information and plot plan are correct; I agree to comply with any and all codes, ordinances, laws, regulations, or restrictions which apply. I understand that failure to comply shall result in legal action, which may include but not necessarily be limited to removal of the fence(s) at the owner's cost.

Applicant's Signature	LO.
Community Development's Approval _	Werky Spure
City Engineer's Approval (if required)	/ /

Date 4/19/07


Date

VALID FOR SIX MONTHS FROM DATE OF ISSUANCE (Section 2.2.E.1.d Grand Junction Zoning & Development Code)

(White: Community Development)

(Yellow: Applicant)

(Pink: Code Enforcement)

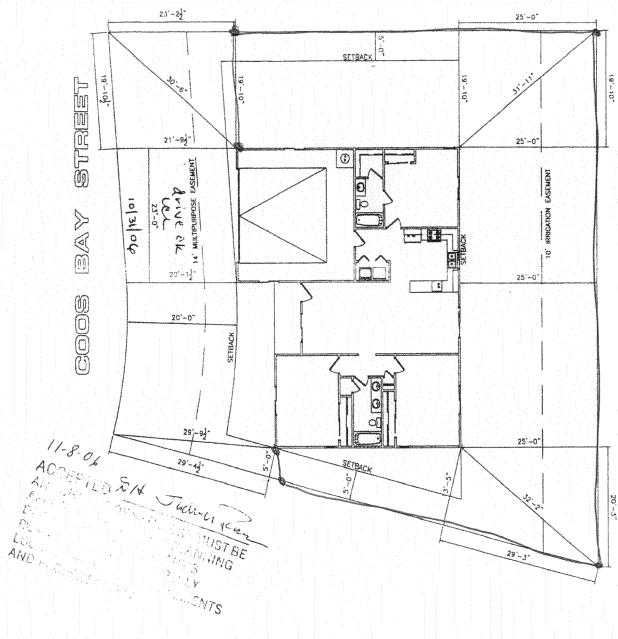

N ACTLE: 1. J. OF BUSCHERSENT OF THE BUSCHER OF OWNER TO YOUR' ALL DEVAL 3. J. OF BUSCHERSE FROM TO CONSTRUCTION. 3. USE OF HAS TAK AC CONSTRUCTS ANALORY AND DA HOME SHACEDFALLED F WHETE YOUR 3. ALL DIMENSION AND TO DOBE OF TOWARDON HALDES OTHER WHETE HOTEL 5. MUSCH AND OF DIMENSION OF ALL STRUCTS AND ALEXANDERS 5. MUSCH AND OF DIMENSION DEVELOPMENT OF ALTOCOMPT. SEE SEMANT DRAWARD BY CHURCH THE DRAWARD SHALL NOTE: GRADE MUST SLOPE AWAY FROM HOUSE 6" OF FALL IN THE FIRST 10" OF DISTANCE PER LOCAL BUILDING CODE. NOTE:: DIMENSION LINES ARE PULLED FROM EDGE OF BRICK LEDGE. IF NO BRICK LEDGE EXISTS, DIMENSIONS WILL BE FROM EDGE OF FOUNDATION. NOTE: BUILDER TO VERIFY ALL SETBACK AND EASEMENT ENCROACHMENTS PRIOR TO CONSTRUCTION SITE PLAN INFORMATION PRIARIE VIEW SUBDIVISION NAME FILING NUMBER 1 LOT NUMBER 5 BLOCK NUMBER 4 470 COOS BAY STREET ADDRESS COUNTY MESA GARAGE SO. FT. 496 SF 1351 SF LIVING SO. FT. LOT SIZE 7013 SF FRONT 20' SIDES 5' SETBACKS USED REAR 25

SCALE: 1/16"=1"-0"

÷.

ZIICAD DWGSIALL PLATSIPRAIRIE VIEWIPRAIRIE VIEW-5.dwg, 10/24/2006 03:17:33 PM, shawn, HP LaserJet 4.pc3