

FEE \$10.00

PERMIT #

14496

FENCE PERMIT
GRAND JUNCTION COMMUNITY DEVELOPMENT DEPARTMENT

Property Address: 6516 26 1/2 Rd Grand Junction, CO
Property Tax No: 2945 - 021 - 06 - 011
Subdivision: Round Hill
Property Owner: Anita Sheets
Owner's Telephone: (970) 250-9941
Owner's Address: Same
Contractor's Name: Valley Side Fence
Contractor's Telephone: (970) 523-8150
Contractor's Address: 2105 E Main St. Grand Junction, CO 81501
Fence Material & Height: 6 Foot Ornamental Iron Saybrook Style

Plot plan must show property lines and property dimensions, all easements, all rights-of-way, all structures, all setbacks from property lines, and fence height(s). NOTE: Property line is likely one foot or more behind the sidewalk.

THIS SECTION TO BE COMPLETED BY COMMUNITY DEVELOPMENT DEPARTMENT STAFF

ZONE RSF-1
SPECIAL CONDITIONS
SETBACKS: Front 20 from property line (PL) or
Side 0 from PL Rear 0 from PL

Fences exceeding six feet in height require a separate permit from the City/County Building Department. A fence constructed on a corner lot that extends past the rear of the house along the side yard or abuts an alley requires approval from the City Engineer (Section 4.1.J of the Grand Junction Zoning and Development Code).

The owner/applicant must correctly identify all property lines, easements, and rights-of-way and ensure the fence is located within the property's boundaries. Covenants, conditions, restrictions, easements and/or rights-of-way may restrict or prohibit the placement of fence(s). The owner/applicant is responsible for compliance with covenants, conditions, and restrictions which may apply. Fences built in easements may be subject to removal at the property owner's sole and absolute expense. Any modification of design and/or material as approved in this fence permit must be approved, in writing, by the Community Development Department Director.

I hereby acknowledge that I have read this application and the information and plot plan are correct; I agree to comply with any and all codes, ordinances, laws, regulations, or restrictions which apply. I understand that failure to comply shall result in legal action, which may include but not necessarily be limited to removal of the fence(s) at the owner's cost.

Applicant's Signature [Signature] Date 3-20-07
Community Development's Approval [Signature] Date 3/23/07
City Engineer's Approval (if required) Date

VALID FOR SIX MONTHS FROM DATE OF ISSUANCE (Section 2.2.E.1.d Grand Junction Zoning & Development Code)


(White: Planning)

(Yellow: Customer)

(Pink: Code Enforcement)

150

10' UTILITY AND IRRIGATION EASEMENT

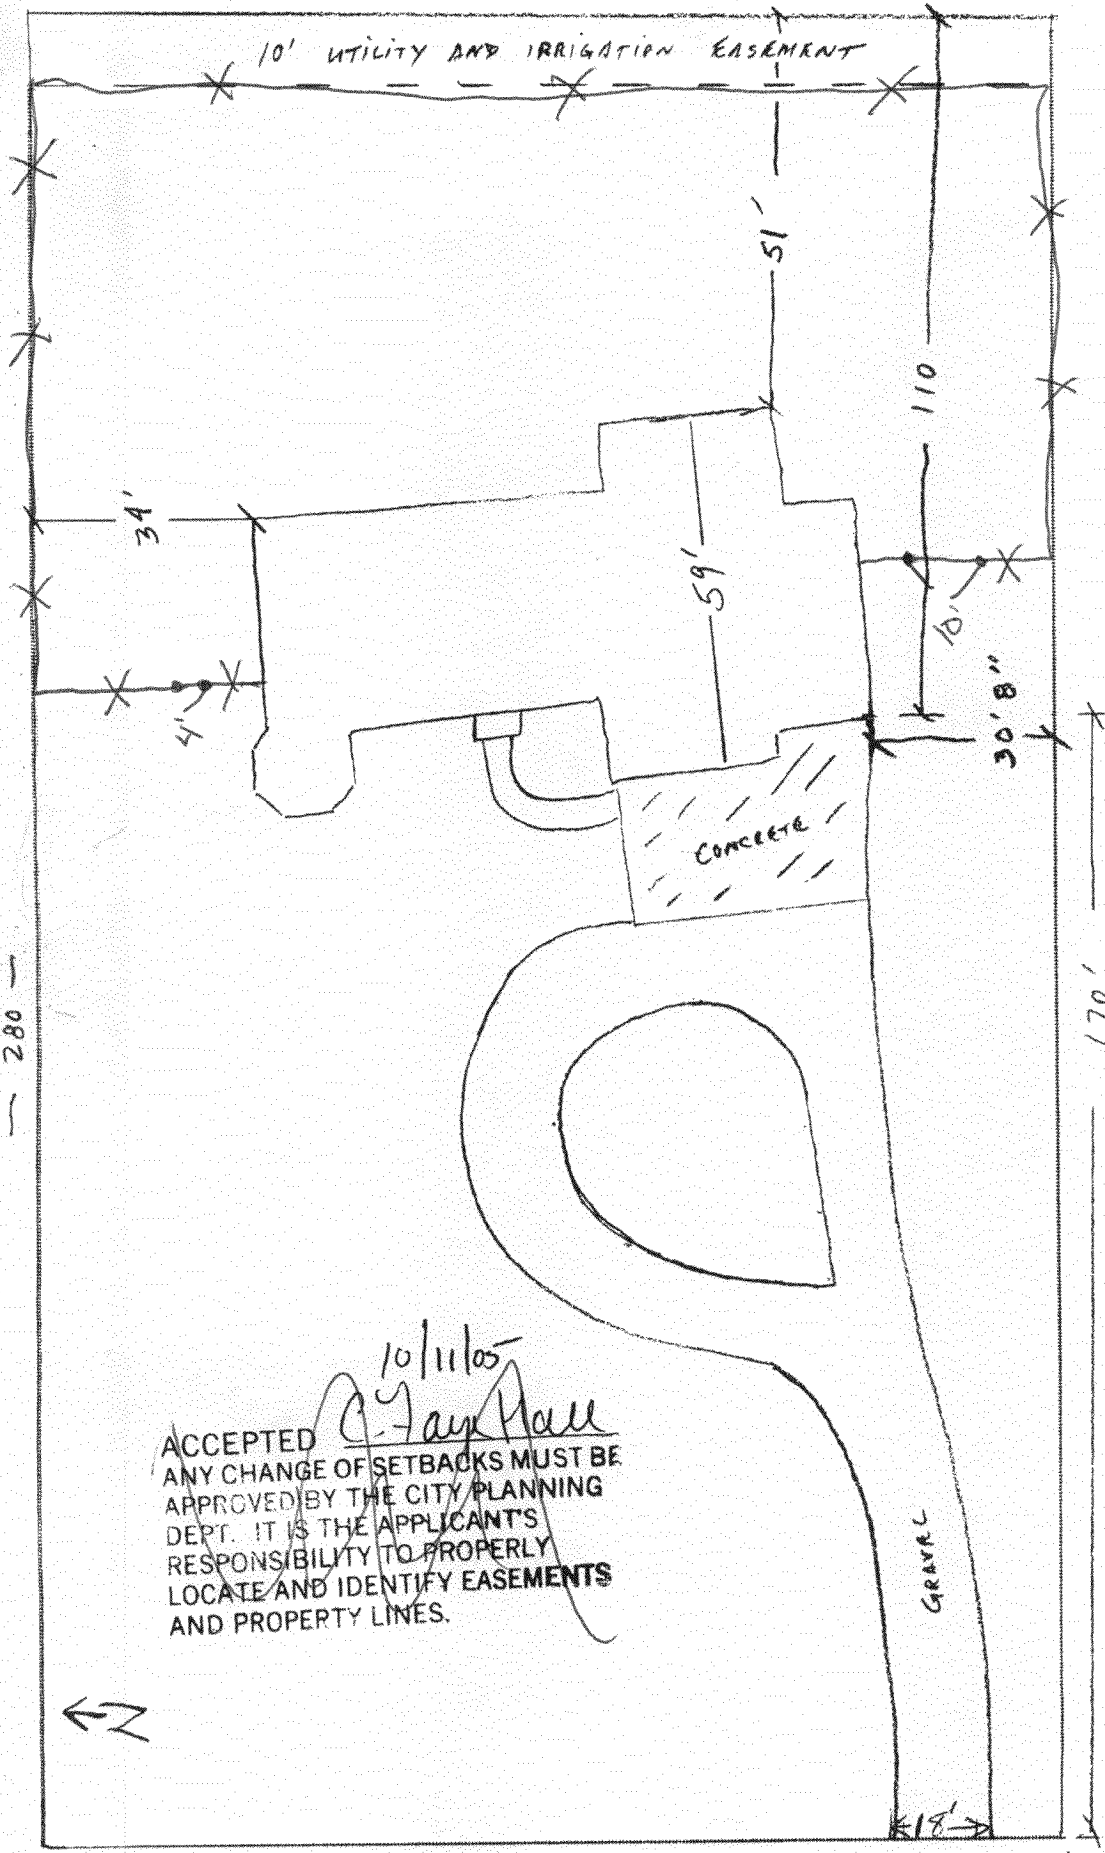

656 26 1/2 Rd

10/11/05
 ACCEPTED *E. Fay Hall*
 ANY CHANGE OF SETBACKS MUST BE APPROVED BY THE CITY PLANNING DEPT. IT IS THE APPLICANT'S RESPONSIBILITY TO PROPERLY LOCATE AND IDENTIFY EASEMENTS AND PROPERTY LINES.

ALIGN DRIVE WITH DRIVEWAY ACROSS 26 1/2 RD. DRIVE OK PER ERIC HANN *EH* 10/11/05 SEE ATTACHED SHEET

26 1/2 RD

116'4"