



# Fence Permit

PERMIT # 15297

Community Development Department  
250 North 5<sup>th</sup> Street  
Grand Junction, CO 81501  
Phone: (970) 244-1430 FAX (970) 236-4031

FEE \$10.00

*[Handwritten mark]*

Property Address: 704 26 1/2 Road, GJ CO 81506

Property Tax No: 2701-364-00-057

Subdivision: BK 938, P 82

Property Owner: Ann Rose

Owner's Telephone: \_\_\_\_\_

Owner's Address: 704 26 1/2 Rd GJ CO 81506

Contractor's Name: owner

Contractor's Telephone: \_\_\_\_\_

Contractor's Address: \_\_\_\_\_

Fence Material & Height: 6" Pine on Spruce Plank 6' high

Plot plan must show property lines and property dimensions, all easements, all rights-of-way, all structures, all setbacks from property lines, and fence height(s). NOTE: Property line is likely one foot or more behind the sidewalk.

THIS SECTION TO BE COMPLETED BY COMMUNITY DEVELOPMENT DEPARTMENT STAFF	
ZONE <u>R-2</u>	SETBACKS: Front <u>20</u> from property line (PL) or
SPECIAL CONDITIONS <u>[initials]</u>	_____ from center of ROW, whichever is greater.
_____	Side <u>15</u> from PL Rear <u>30</u> from PL

Fences exceeding six feet in height require a separate permit from the City/County Building Department. A fence constructed on a corner lot that extends past the rear of the house along the side yard or abuts an alley requires approval from the City Engineer (Section 4.1.J of the Grand Junction Zoning and Development Code).

The owner/applicant must correctly identify all property lines, easements, and rights-of-way and ensure the fence is located within the property's boundaries. Covenants, conditions, restrictions, easements and/or rights-of-way may restrict or prohibit the placement of fence(s). The owner/applicant is responsible for compliance with covenants, conditions, and restrictions which may apply. Fences built in easements may be subject to removal at the property owner's sole and absolute expense. Any modification of design and/or material as approved in this fence permit must be approved, in writing, by the Community Development Department Director.

I hereby acknowledge that I have read this application and the information and plot plan are correct; I agree to comply with any and all codes, ordinances, laws, regulations, or restrictions which apply. I understand that failure to comply shall result in legal action, which may include but not necessarily be limited to removal of the fence(s) at the owner's cost.

Applicant's Signature Ann Rose Date 10/15/07

Community Development's Approval Paul Hunt Date 10/15/07


City Engineer's Approval (if required) \_\_\_\_\_ Date \_\_\_\_\_

VALID FOR SIX MONTHS FROM DATE OF ISSUANCE (Section 2.2.E.1.d Grand Junction Zoning & Development Code)

(White: Community Development)

(Yellow: Applicant)

(Pink: Code Enforcement)

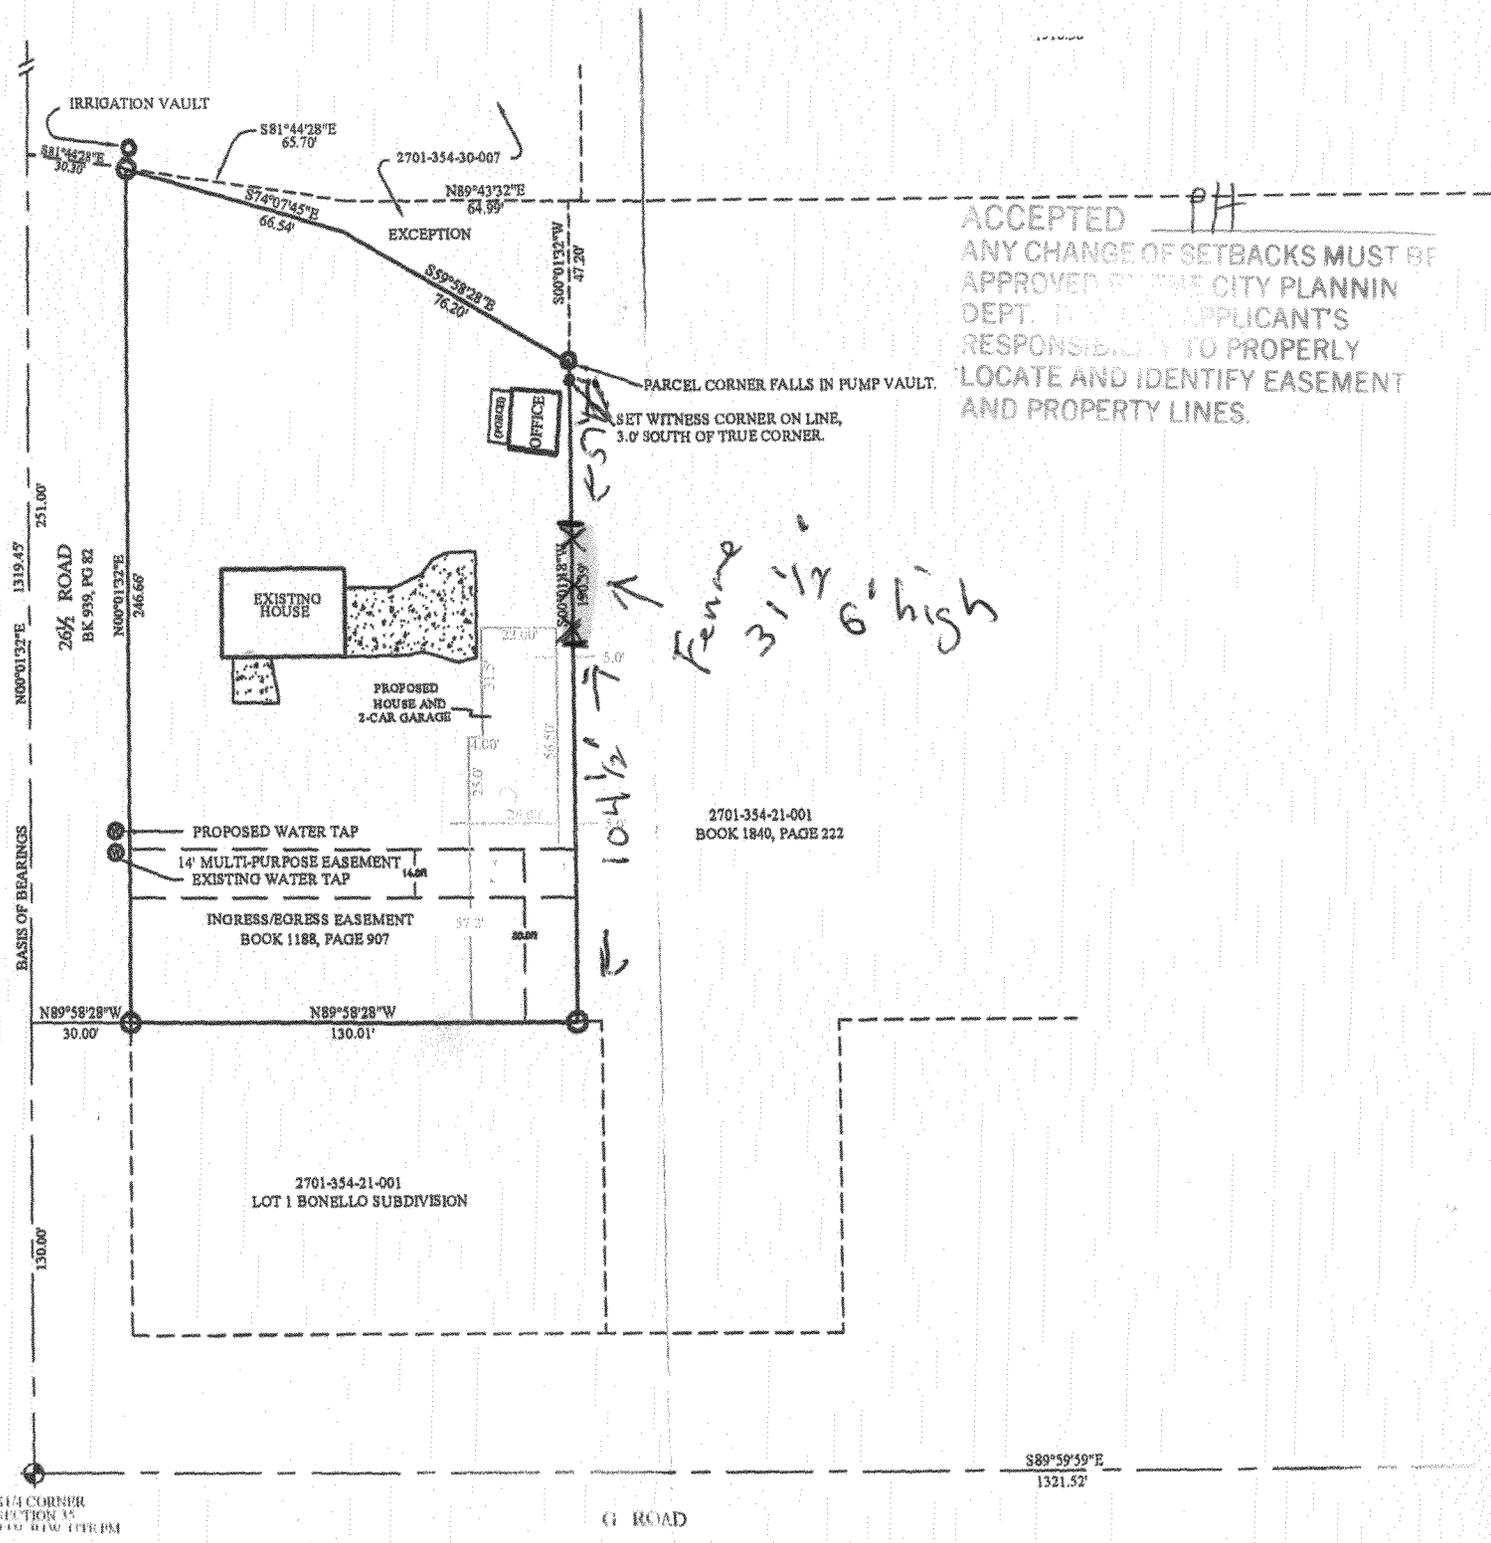

ACCEPTED PH

ANY CHANGE OF SETBACKS MUST BE APPROVED BY THE CITY PLANNING DEPT. IT IS THE APPLICANT'S RESPONSIBILITY TO PROPERLY LOCATE AND IDENTIFY EASEMENT AND PROPERTY LINES.

- GEND**
- ⊕ MESA COUNTY SURVEY MONUMENT OR BLM SURVEY MONUMENT
  - ⊙ SET REBAR & CAP LS 29419
  - FOUND MONUMENT
  - ⊗ WATER METER
  - PARCEL LINE
  - - - ADJOINING LOT
  - - - EASEMENT