
PERMIT #

14598

FENCE PERMIT

GRAND JUNCTION COMMUNITY DEVELOPMENT DEPARTMENT

Property Address: 244 Woodridge COUTT. G. J., CO 81505	
Property Tax No: 2701-341-00-141	
Property Owner: RED HART Homes at Wood-ielge	
Owner's Telephone: 234-0811	
Owner's Address: 2320-E12 Rd. G.J. CO 81503	
Contractor's Name: RED HART ConsT	
Contractor's Telephone: 234-0812	
Contractor's Address: Sene	
Contractor's Address: Sane Fence Material & Height: 3'Tall Tan Vinyl - 2 (ail)	
Plot plan must show property lines and property dimensions, all easements, all rights-of-way, all structures, all setbacks from property lines, and fence height(s). NOTE: Property line is likely one foot or more behind the sidewalk.	
THIS SECTION TO BE COMPLETED BY COM	MMUNITY DEVELOPMENT DEPARTMENT STAFF
ZONE DD	SETBACKS: Front from property line (PL) or
SPECIAL CONDITIONS 3' Phrmetec	from center of ROW, whichever is greater.
bence only	
	n the City/County Building Department. A fence constructed on a corne abuts an alley requires approval from the City Engineer (Section 4.1.J.)
The owner/applicant must correctly identify all property lines, easements, and rights-of-way and ensure the fence is located within the property's boundaries. Covenants, conditions, restrictions, easements and/or rights-of-way may restrict or prohibit the placement of fence(s). The owner/applicant is responsible for compliance with covenants, conditions, and restrictions which may apply. Fences built in easements may be subject to removal at the property owner's sole and absolute expense. Any modification of design and/or material as approved in this fence permit must be approved, in writing, by the Community Development Department Director.	
I hereby acknowledge that I have read this application and the in codes, ordinances, laws, regulations, or restrictions which apply. I include but not necessarily be limited to removal of the fence(s) a	nformation and plot plan are correct; I agree to comply with any and a I understand that failure to comply shall result in legal action, which ma at the owner's cost.
Applicant's Signature	Date May 8 2007
Community Development's Approval	$\frac{1}{Date} \frac{May 8 2007}{Date 5 0 07}$
City Engineer's Approval (if required)	Date
VALID FOR SIX MONTHS FROM DATE OF ISSUANCE (S	Section 2.2.E.1.d Grand Junction Zoning & Development Code)
(White: Planning) (Yellow: Cus	stomer) (Pink: Code Enforcement)

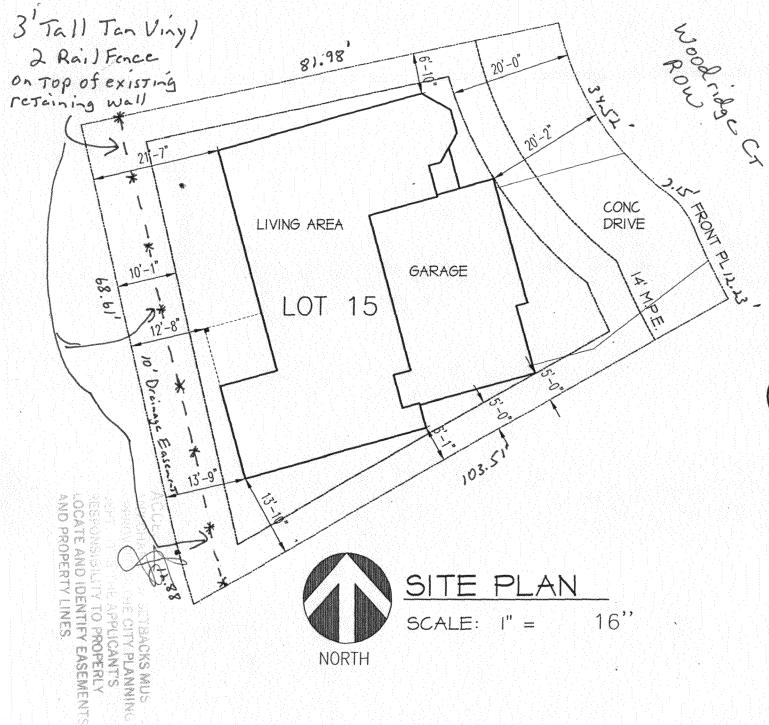

RED HART

Daniel R. Gearhart 970/244-8975

DATE: 03/11/07

SPEC HOME

PLAN 2 LOT 15

724 WOODRIDGE COURT

SETBACKS FRONT: 20' REAR: 10' SIDE: 5'