

FEE \$10.00

PERMIT # 14557 *P*

FENCE PERMIT
GRAND JUNCTION COMMUNITY DEVELOPMENT DEPARTMENT

Property Address: 733 Woodridge Ct., G.J., CO 81505
 Property Tax No: 2701-344-37-021
 Subdivision: Woodridge
 Property Owner: RED HART Homes at Woodridge
 Owner's Telephone: 234-0822 (Dan)
 Owner's Address: 2320 - E 1/2 Rd. G.J., CO 81503
 Contractor's Name: RED HART Const
 Contractor's Telephone: 234-0822
 Contractor's Address: 2320 - E 1/2 Rd. G.J., CO 81503
 Fence Material & Height: 6' Tall Tan Vinyl Privacy

Plot plan must show property lines and property dimensions, all easements, all rights-of-way, all structures, all setbacks from property lines, and fence height(s). NOTE: Property line is likely one foot or more behind the sidewalk.

THIS SECTION TO BE COMPLETED BY COMMUNITY DEVELOPMENT DEPARTMENT STAFF	
ZONE <u>PD</u>	SETBACKS: Front <u>20</u> from property line (PL) or
SPECIAL CONDITIONS _____	_____ from center of ROW, whichever is greater.
_____	Side <u>0</u> from PL Rear <u>10</u> from PL

Fences exceeding six feet in height require a separate permit from the City/County Building Department. A fence constructed on a corner lot that extends past the rear of the house along the side yard or abuts an alley requires approval from the City Engineer (Section 4.1.J of the Grand Junction Zoning and Development Code).

The owner/applicant must correctly identify all property lines, easements, and rights-of-way and ensure the fence is located within the property's boundaries. Covenants, conditions, restrictions, easements and/or rights-of-way may restrict or prohibit the placement of fence(s). The owner/applicant is responsible for compliance with covenants, conditions, and restrictions which may apply. Fences built in easements may be subject to removal at the property owner's sole and absolute expense. Any modification of design and/or material as approved in this fence permit must be approved, in writing, by the Community Development Department Director.

I hereby acknowledge that I have read this application and the information and plot plan are correct; I agree to comply with any and all codes, ordinances, laws, regulations, or restrictions which apply. I understand that failure to comply shall result in legal action, which may include but not necessarily be limited to removal of the fence(s) at the owner's cost.

Applicant's Signature *Paul R. Gult* Date OCT 21, 2007
 Community Development's Approval *Paul Hornbeck* Date 10/22/07
 City Engineer's Approval (if required) _____ Date _____

VALID FOR SIX MONTHS FROM DATE OF ISSUANCE (Section 2.2.E.1.d Grand Junction Zoning & Development Code)

(White: Planning) (Yellow: Customer) (Pink: Code Enforcement)

~~133~~ & 733 Woodridge CT Fencing




Daniel R. Gearhart
970/244-8975

DATE: 05/08/07

SPEC HOME

LOTS 20 & 21
731 & 733 WOODRIDGE CT

SETBACKS
FRONT: 20'
REAR: 10'
L. SIDE: 0'
R. SIDE: 0'

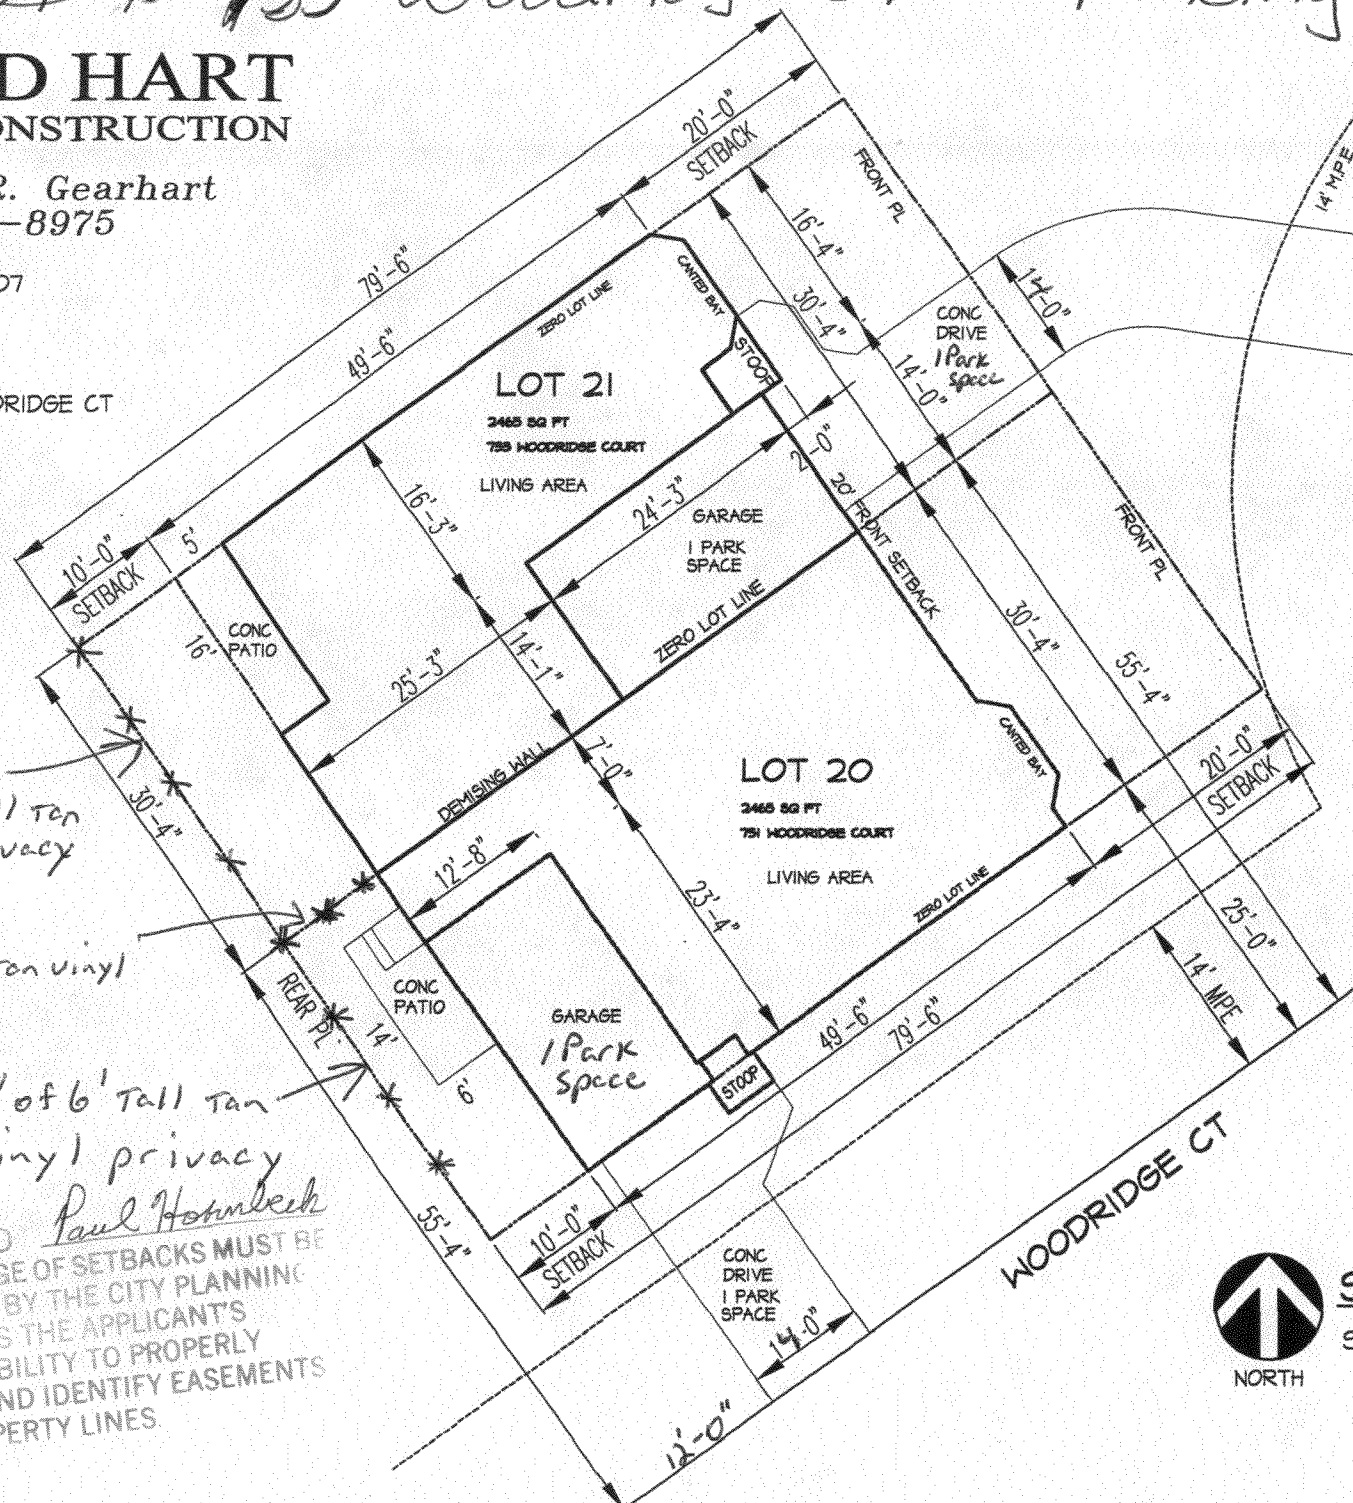

30' of 6' tall tan vinyl privacy

10' of 6' tall tan vinyl privacy

24' of 6' tall tan vinyl privacy

ACCEPTED Paul Hotinberk
ANY CHANGE OF SETBACKS MUST BE APPROVED BY THE CITY PLANNING DEPT. IT IS THE APPLICANT'S RESPONSIBILITY TO PROPERLY LOCATE AND IDENTIFY EASEMENTS AND PROPERTY LINES.



SITE PLAN
SCALE: 1" = 16'