



Fence Permit

PERMIT # 14952

Community Development Department
250 North 5th Street
Grand Junction, CO 81501
Phone: (970) 244-1430 FAX (970) 236-4031

FEE \$10.00

pl

Property Address: 764 Old Orchard St

Property Tax No: 2701-352-71-003

Subdivision: Old Orchard Estates

Property Owner: J.T. Teague

Owner's Telephone: (970) 242-1841

Owner's Address: Same

Contractor's Name: Valleywide Fence

Contractor's Telephone: (970) 523-8150

Contractor's Address: 2105 E Main St.

Fence Material & Height: 6' Vinyl + 6' Decorative Aluminum

Plot plan must show property lines and property dimensions, all easements, all rights-of-way, all structures, all setbacks from property lines, and fence height(s). NOTE: Property line is likely one foot or more behind the sidewalk.

THIS SECTION TO BE COMPLETED BY COMMUNITY DEVELOPMENT DEPARTMENT STAFF	
ZONE <u>Z-2</u>	SETBACKS: Front <u>20</u> from property line (PL) or
SPECIAL CONDITIONS _____	_____ from center of ROW, whichever is greater.
_____	Side _____ from PL Rear _____ from PL

Fences exceeding six feet in height require a separate permit from the City/County Building Department. A fence constructed on a corner lot that extends past the rear of the house along the side yard or abuts an alley requires approval from the City Engineer (Section 4.1.J of the Grand Junction Zoning and Development Code).

The owner/applicant must correctly identify all property lines, easements, and rights-of-way and ensure the fence is located within the property's boundaries. Covenants, conditions, restrictions, easements and/or rights-of-way may restrict or prohibit the placement of fence(s). The owner/applicant is responsible for compliance with covenants, conditions, and restrictions which may apply. Fences built in easements may be subject to removal at the property owner's sole and absolute expense. Any modification of design and/or material as approved in this fence permit must be approved, in writing, by the Community Development Department Director.

I hereby acknowledge that I have read this application and the information and plot plan are correct; I agree to comply with any and all codes, ordinances, laws, regulations, or restrictions which apply. I understand that failure to comply shall result in legal action, which may include but not necessarily be limited to removal of the fence(s) at the owner's cost.

Applicant's Signature [Signature]

Date 9-11-07

Community Development's Approval [Signature]

Date 9/13/07

City Engineer's Approval (if required) _____

Date _____

VALID FOR SIX MONTHS FROM DATE OF ISSUANCE (Section 2.2.E.1.d Grand Junction Zoning & Development Code)

(White: Community Development)


(Yellow: Applicant)

(Pink: Code Enforcement)

New Orchard Ct.

Minimum
38'-0" Aluminum

Library Street

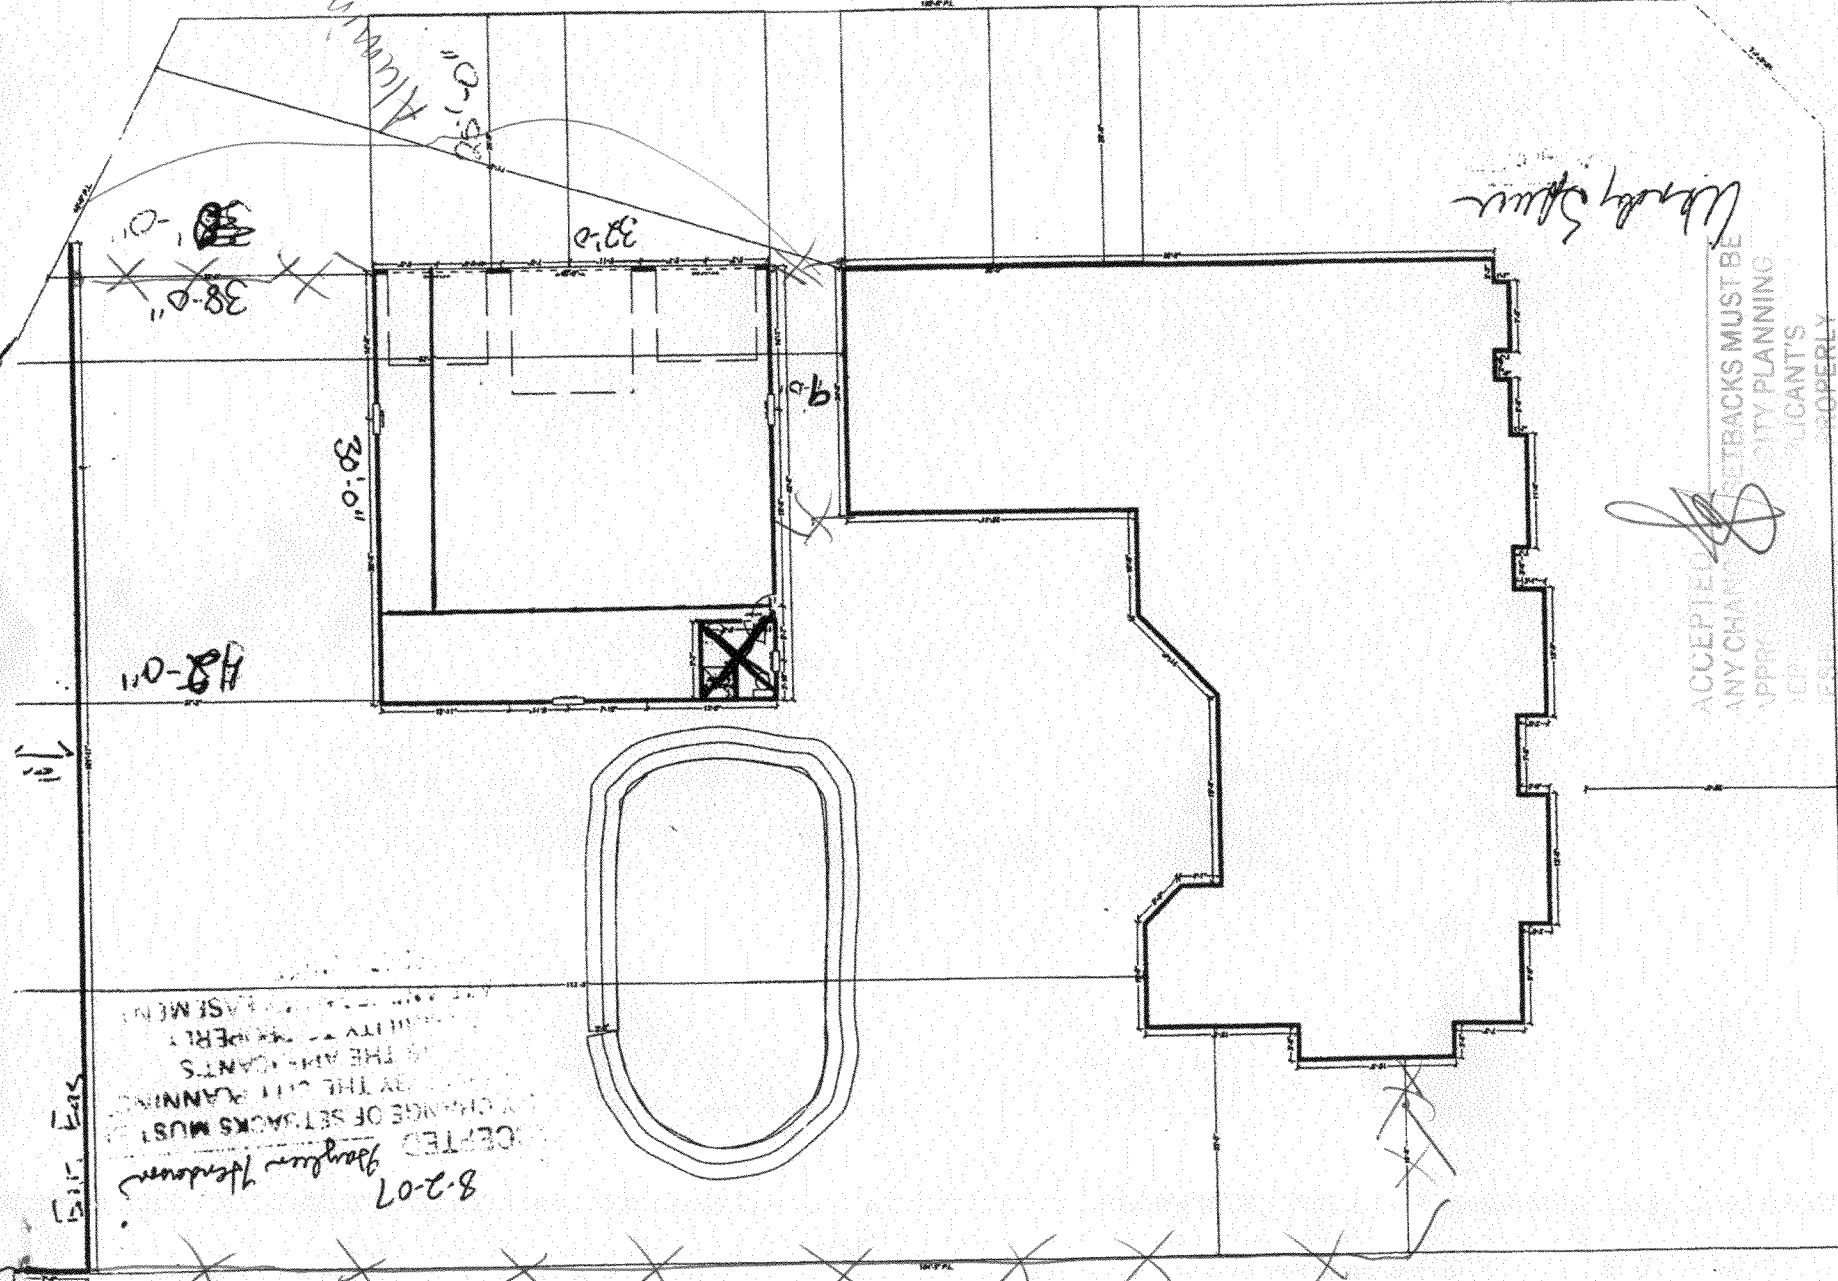

48'-0"

39'-0"

32'-0"

9'-0"

ACCEPTED
 CHANGE OF SETBACKS MUST
 BE APPROVED BY THE CITY PLANNING
 DEPARTMENT AS THE APPLICANTS
 ARE RESPONSIBLE FOR THE QUALITY OF THE
 SUBMITTALS AND THE CITY PLANNING
 DEPARTMENT IS NOT RESPONSIBLE FOR THE
 QUALITY OF THE SUBMITTALS.

8-2-07
 Jennifer Henderson

ACCEPTED SETBACKS MUST BE
 ANY CHANGE OF CITY PLANNING
 DEPARTMENT APPLICANTS
 RESPONSIBLE FOR PROPERLY
 LOCATE AND IDENTIFY EASEMENTS
 AND DEEDS TO THE RECORD.

[Signature]

Old Orchard St.