

(White: Community Development)

Fence Permit

PERMIT# 15256


FEE \$10.00

(Pink: Code Enforcement)

Community Development Department 250 North 5th Street Grand Junction, CO 81501 Phone: (970) 244-1430 FAX (970) 236-4031

Property Address: 2860 Rock CREEK Dr.	
Property Tax No:	
Subdivision: UNAWEED WEIGHTS	
Property Owner: PINNACIE Homes	
Owner's Telephone: 241-6646	
Owner's Address: 3/// F Rd	
Contractor's Name: Book cliff FENCE + VINY	
Contractor's Telephone: 216-7828	
Contractor's Address: 41.1 Wash buen	
Fence Material & Height: 6' Viny /	
Plot plan must show property lines and property dimensions, all easements, all rights-of-way, all structures, all setbacks from property lines, and fence height(s). NOTE: Property line is likely one foot or more behind the sidewalk.	
THIS SECTION TO BE COMPLETED BY COMM	IUNITY DEVELOPMENT DEPARTMENT STAFF
ZONE K-4	SETBACKS: Front from property line (PL) or
SPECIAL CONDITIONS	from center of ROW, whichever is greater.
Line of site novement you per R.D.	Side from PL Rear from PL
Fences exceeding six feet in height require a separate permit from the City/County Building Department. A fence constructed on a corner lot that extends past the rear of the house along the side yard or abuts an alley requires approval from the City Engineer (Section 4.1.J of the Grand Junction Zoning and Development Code).	
The owner/applicant must correctly identify all property lines, easements, and rights-of-way and ensure the fence is located within the property's boundaries. Covenants, conditions, restrictions, easements and/or rights-of-way may restrict or prohibit the placement of fence(s). The owner/applicant is responsible for compliance with covenants, conditions, and restrictions which may apply. Fences built in easements may be subject to removal at the property owner's sole and absolute expense. Any modification of design and/or material as approved in this fence permit must be approved, in writing, by the Community Development Department Director.	
I hereby acknowledge that I have read this application and the information and plot plan are correct; I agree to comply with any and all codes, ordinances, laws, regulations, or restrictions which apply. I understand that failure to comply shall result in legal action, which may include but not necessarily be limited to removal of the fence(s) at the owner's cost.	
Applicant's Signature	Date 2/17/7
Community Development's Approval Judestr Ver	Date 1/19/07
City Engineer's Approval (if required)	Date
VALID FOR SIX MONTHS FROM DATE OF ISSUANCE (Section 2.2.E.1.d Grand Junction Zoning & Development Code)	

(Yellow: Applicant)

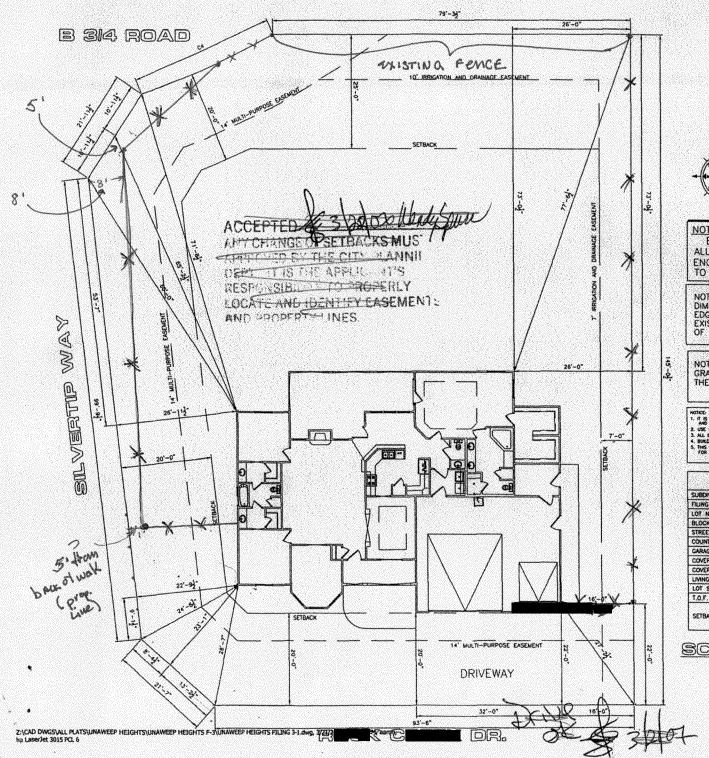



NOTE: BUILDER TO VERIFY ALL SETBACK AND EASEMENT ENCROACHMENTS PRIOR TO CONSTRUCTION

DIMENSION LINES ARE PULLED FROM EDGE OF BRICK LEDGE. IF NO BRICK LEDGE EXISTS, DIMENSIONS WILL BE FROM EDGE OF FOUNDATION.

GRADE MUST SLOPE AWAY FROM HOUSE 6" OF FALL IN THE FIRST 10" OF DISTANCE PER LOCAL BUILDING CODE.

HOTICE.

1. If IS THE RESPONSIBILITY OF THE BUILDER OR DWHOT TO VERYY ALL DETAILS AND EMPOSITION PRIOR TO CONSTRUCTION.

2. USE OF THIS PLAN CONSTITUTES BUILDER AND OR HOME OWNERS ACCEPTANCE OF THESE TONIS.

3. ALL DWINDSOM AND TO EDEE OF TEMPORATION UNLESS CHIEF MICH MOTED.

4. BUILDER AND OR DWINE TO VERYY ALL SETBACKS AND ENCORPORT.

5. HISTORIES AND THE SEASON ACCORDING BY AUTOMATE. SEX SEPARATE DRIVENINGS BY OTHERS TOR ENGANGED EACH.

SITE PLAN INFORMATION SUBDIVISION NAME UNAWEEP HEIGHTS FILING NUMBER LOT NUMBER BLOCK NUMBER STREET ADDRESS 2860 ROCK CREEK COUNTY MESA CARAGE SQ. FT. 841 SF COVERED ENTRY SO, FT. 85 SF COVERED PATIO SQ. FT. 328 SF LIVING SQ. FT. 2098 SF LOT SIZE 16215 SF T.O.F. MIN --4664.5-MAX --4666.5 FRONT 20" SETBACKS USED SIDES 7" REAR 25

SCALE: 1"=20"-0"