



Fence Permit

PERMIT # 15271 *PA*

Community Development Department
250 North 5th Street
Grand Junction, CO 81501
Phone: (970) 244-1430 FAX (970) 236-4031

FEE \$10.00

Property Address: 2864 ROCK CREEK

Property Tax No: 2943 301 33 004

Subdivision: UNAWEEP HEIGHTS

Property Owner: PINNACLE HOMES

Owner's Telephone: 241-6646

Owner's Address: 3111 F Rd GT 81503

Contractor's Name: BOOKCLIFF FENCE + VINYL

Contractor's Telephone: 214-7828

Contractor's Address: 461 WASHBURN

Fence Material & Height: VINYL 6'

Plot plan must show property lines and property dimensions, all easements, all rights-of-way, all structures, all setbacks from property lines, and fence height(s). NOTE: Property line is likely one foot or more behind the sidewalk.

THIS SECTION TO BE COMPLETED BY COMMUNITY DEVELOPMENT DEPARTMENT STAFF	
ZONE <u>R-4</u>	SETBACKS: Front _____ from property line (PL) or
SPECIAL CONDITIONS _____	_____ from center of ROW, whichever is greater.
_____	Side _____ from PL Rear _____ from PL

Fences exceeding six feet in height require a separate permit from the City/County Building Department. A fence constructed on a corner lot that extends past the rear of the house along the side yard or abuts an alley requires approval from the City Engineer (Section 4.1.J of the Grand Junction Zoning and Development Code).

The owner/applicant must correctly identify all property lines, easements, and rights-of-way and ensure the fence is located within the property's boundaries. Covenants, conditions, restrictions, easements and/or rights-of-way may restrict or prohibit the placement of fence(s). The owner/applicant is responsible for compliance with covenants, conditions, and restrictions which may apply. Fences built in easements may be subject to removal at the property owner's sole and absolute expense. Any modification of design and/or material as approved in this fence permit must be approved, in writing, by the Community Development Department Director.

I hereby acknowledge that I have read this application and the information and plot plan are correct; I agree to comply with any and all codes, ordinances, laws, regulations, or restrictions which apply. I understand that failure to comply shall result in legal action, which may include but not necessarily be limited to removal of the fence(s) at the owner's cost.

Applicant's Signature Robert B. Belcher Date 8/17/07

Community Development's Approval Wesley Spurr Date 8/17/07

City Engineer's Approval (if required) _____ Date _____

VALID FOR SIX MONTHS FROM DATE OF ISSUANCE (Section 2.2.E.1.d Grand Junction Zoning & Development Code)


(White: Community Development) (Yellow: Applicant) (Pink: Code Enforcement)

Due 8/22


Grates
1-3'
2-4'4"

2864
~~Apposta~~
Rock Creek

cc: 7884
319

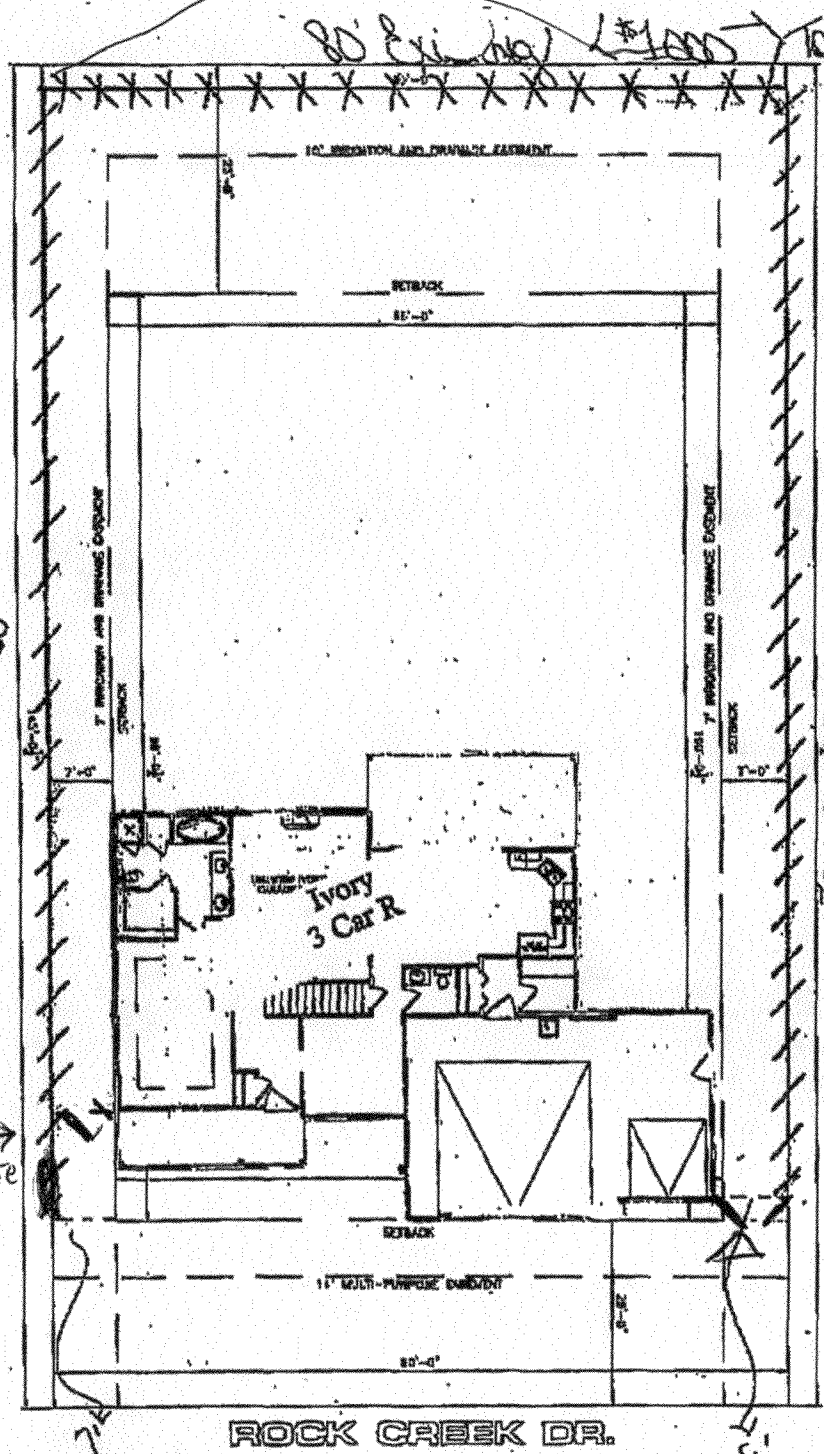

20' Easement #1000 to Pinvale

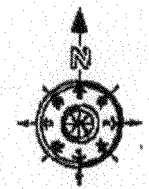

NOTE:
BUILDER TO VERIFY
ALL SETBACK AND EASEMENT
ENCROACHMENTS PRIOR
TO CONSTRUCTION

NOTE:
DIMENSION LINES ARE PULLED FROM
EDGE OF BRICK LEDGE. IF NO BRICK LEDGE
EXISTS, DIMENSIONS WILL BE FROM EDGE
OF FOUNDATION.

NOTE:
GRADE MUST SLOPE AWAY FROM HOUSE 6" OF FALL IN
THE FIRST 10' OF DISTANCE PER LOCAL BUILDING CODE.

NOTES:
1. TO THE EXTENT OF THE BASIS ON WHICH TO NOTE ALL DETAILS
THE CONTRACTOR SHALL BE RESPONSIBLE.
2. ANY OF THE PLAN IDENTIFIED BUILDING HAS OR SHALL BEING ACCORDING TO THEIR PERMITS.
3. ALL DIMENSIONS ARE TO FACE UNLESS OTHERWISE NOTED.
4. ALL DIMENSIONS ARE TO FACE UNLESS OTHERWISE NOTED.
5. THE PLAN HAS NOT BEEN CHECKED BY ANYONE.
FOR CONSTRUCTION ONLY.

SITE PLAN INFORMATION	
SUBDIVISION NAME	CHERRY HEIGHTS
PLANS NUMBER	3
LOT NUMBER	4
BLOCK NUMBER	1
STREET ADDRESS	3
COUNTY	NECA
GARAGE SQ. FT.	1
COVERED ENTRY SQ. FT.	1
CONCRETE PATIO SQ. FT.	1
LAWN SQ. FT.	1
LOT SIZE	11881 SF
T.O.F.	MIN. - 7'2" - MAX. - 7'10"
SETBACKS USED	FRONT 20'
	SIDES 7'
	REAR 25'

SCALE: 1"=20'-0"

AB02815

A.H.
Bab

2-4'4" Grates