



Fence Permit

PERMIT # 15125

Community Development Department
250 North 5th Street
Grand Junction, CO 81501
Phone: (970) 244-1430 FAX (970) 236-4031

FEE \$10.00

Property Address: 2936 Mia Drive

Property Tax No: 2943-293-22-002

Subdivision: Crista Lee

Property Owner: Mike Eliot

Owner's Telephone: 314-1687

Owner's Address: 2936 Mia Drive

Contractor's Name: Medina's Landscaping

Contractor's Telephone: 245-2410

Contractor's Address: 235 28 1/2 Rd

Fence Material & Height: 6' Vinyl Fence

Plot plan must show property lines and property dimensions, all easements, all rights-of-way, all structures, all setbacks from property lines, and fence height(s). NOTE: Property line is likely one foot or more behind the sidewalk.

THIS SECTION TO BE COMPLETED BY COMMUNITY DEVELOPMENT DEPARTMENT STAFF	
ZONE <u>R-4</u>	SETBACKS: Front <u>20'</u> from property line (PL) or
SPECIAL CONDITIONS _____	_____ from center of ROW, whichever is greater.
_____	Side <u>0</u> from PL Rear <u>0</u> from PL

Fences exceeding six feet in height require a separate permit from the City/County Building Department. A fence constructed on a corner lot that extends past the rear of the house along the side yard or abuts an alley requires approval from the City Engineer (Section 4.1.J of the Grand Junction Zoning and Development Code).

The owner/applicant must correctly identify all property lines, easements, and rights-of-way and ensure the fence is located within the property's boundaries. Covenants, conditions, restrictions, easements and/or rights-of-way may restrict or prohibit the placement of fence(s). The owner/applicant is responsible for compliance with covenants, conditions, and restrictions which may apply. Fences built in easements may be subject to removal at the property owner's sole and absolute expense. Any modification of design and/or material as approved in this fence permit must be approved, in writing, by the Community Development Department Director.

I hereby acknowledge that I have read this application and the information and plot plan are correct; I agree to comply with any and all codes, ordinances, laws, regulations or restrictions which apply. I understand that failure to comply shall result in legal action, which may include but not necessarily be limited to removal of the fence(s) at the owner's cost.

Applicant's Signature Jose Beerna Date 5/7/2007

Community Development's Approval Judith A. Pasi Date 5/7/2007


City Engineer's Approval (if required) _____ Date _____

VALID FOR SIX MONTHS FROM DATE OF ISSUANCE (Section 2.2.E.1.d Grand Junction Zoning & Development Code)

(White: Community Development) (Yellow: Applicant) (Pink: Code Enforcement)

IMPROVEMENT LOCATION CERTIFICATE

2936 Mia Drive

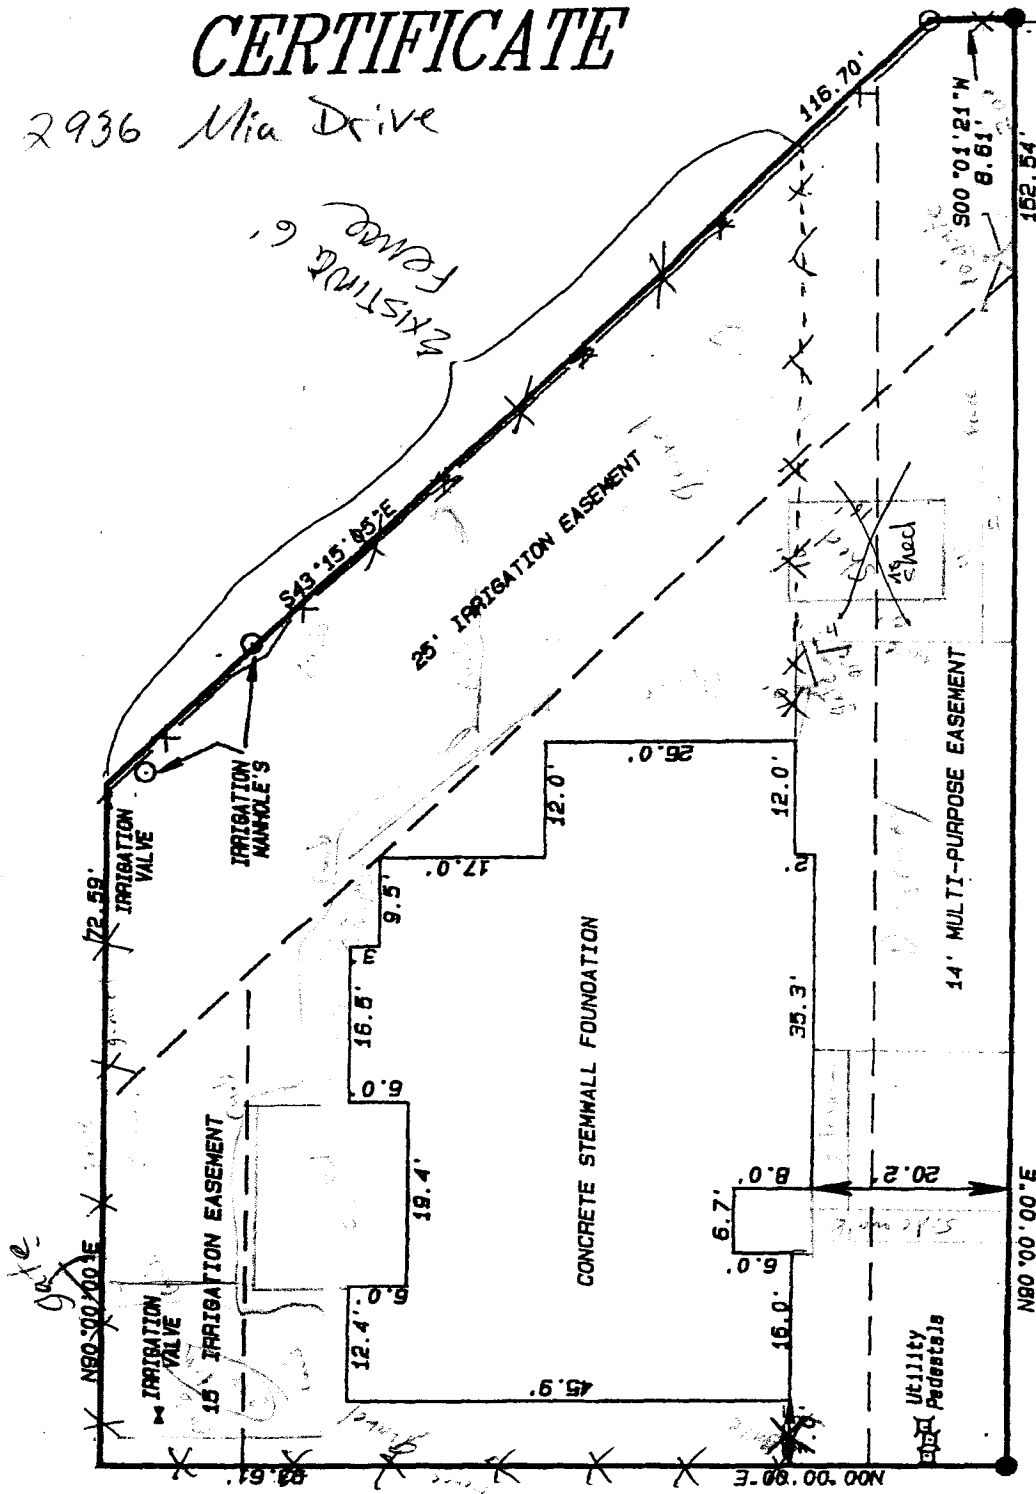

PROPERTY DESCRIPTION: Lot 2, Block ONE,
Crista Lee Subdivision
City of Grand Junction, Mesa County Colorado.
2936 MIA DRIVE

NOTE: THE STRUCTURE LOCATION MEETS
CITY OF GRAND JUNCTION SET-BACK REQUIREMENTS
AND CITY APPROVED SITE PLAN.



I hereby certify that this improvement location certificate was prepared for Liberty Savings Bank, that it is not a land survey plat or improvement survey plat, and that it is not to be relied upon for the establishment of fence, building, or other future improvement lines. I further certify that the improvements on the above described