



Fence Permit

PERMIT # 15284

Community Development Department
250 North 5th Street
Grand Junction, CO 81501
Phone: (970) 244-1430 FAX (970) 236-4031

FEE \$10.00

Property Address: 2938 Annelie Ln

Property Tax No: 2943-053-88-000

Subdivision: Forrest Estates

Property Owner: Rich Watts

Owner's Telephone: (970) 433-1991

Owner's Address: Same

Contractor's Name: Valley Side Fence

Contractor's Telephone: (970) 923-8150

Contractor's Address: 205 E Main St.

Fence Material & Height: 6' Vinyl

Plot plan must show property lines and property dimensions, all easements, all rights-of-way, all structures, all setbacks from property lines, and fence height(s). NOTE: Property line is likely one foot or more behind the sidewalk.

| THIS SECTION TO BE COMPLETED BY COMMUNITY DEVELOPMENT DEPARTMENT STAFF | |
|--|--|
| ZONE <u>R-5</u> | SETBACKS: Front <u>20</u> from property line (PL) or |
| SPECIAL CONDITIONS _____ | _____ from center of ROW, whichever is greater. |
| _____ | Side <u>5</u> from PL Rear <u>25</u> from PL |

Fences exceeding six feet in height require a separate permit from the City/County Building Department. A fence constructed on a corner lot that extends past the rear of the house along the side yard or abuts an alley requires approval from the City Engineer (Section 4.1.J of the Grand Junction Zoning and Development Code).

The owner/applicant must correctly identify all property lines, easements, and rights-of-way and ensure the fence is located within the property's boundaries. Covenants, conditions, restrictions, easements and/or rights-of-way may restrict or prohibit the placement of fence(s). The owner/applicant is responsible for compliance with covenants, conditions, and restrictions which may apply. Fences built in easements may be subject to removal at the property owner's sole and absolute expense. Any modification of design and/or material as approved in this fence permit must be approved, in writing, by the Community Development Department Director.

I hereby acknowledge that I have read this application and the information and plot plan are correct; I agree to comply with any and all codes, ordinances, laws, regulations, or restrictions which apply. I understand that failure to comply shall result in legal action, which may include but not necessarily be limited to removal of the fence(s) at the owner's cost.

Applicant's Signature [Signature] Date 9-24-07


Community Development's Approval [Signature] Date 9/27/07

City Engineer's Approval (if required) _____ Date _____

VALID FOR SIX MONTHS FROM DATE OF ISSUANCE (Section 2.2.E.1.d Grand Junction Zoning & Development Code)

(White: Community Development) (Yellow: Applicant) (Pink: Code Enforcement)

2938 ANNEVILLE - LOT 6 - BLOCK 2 - FOREST ESTATES - FILING II
SITE - PLOT PLAN - DOUGLAS MODEL - SCALE 80

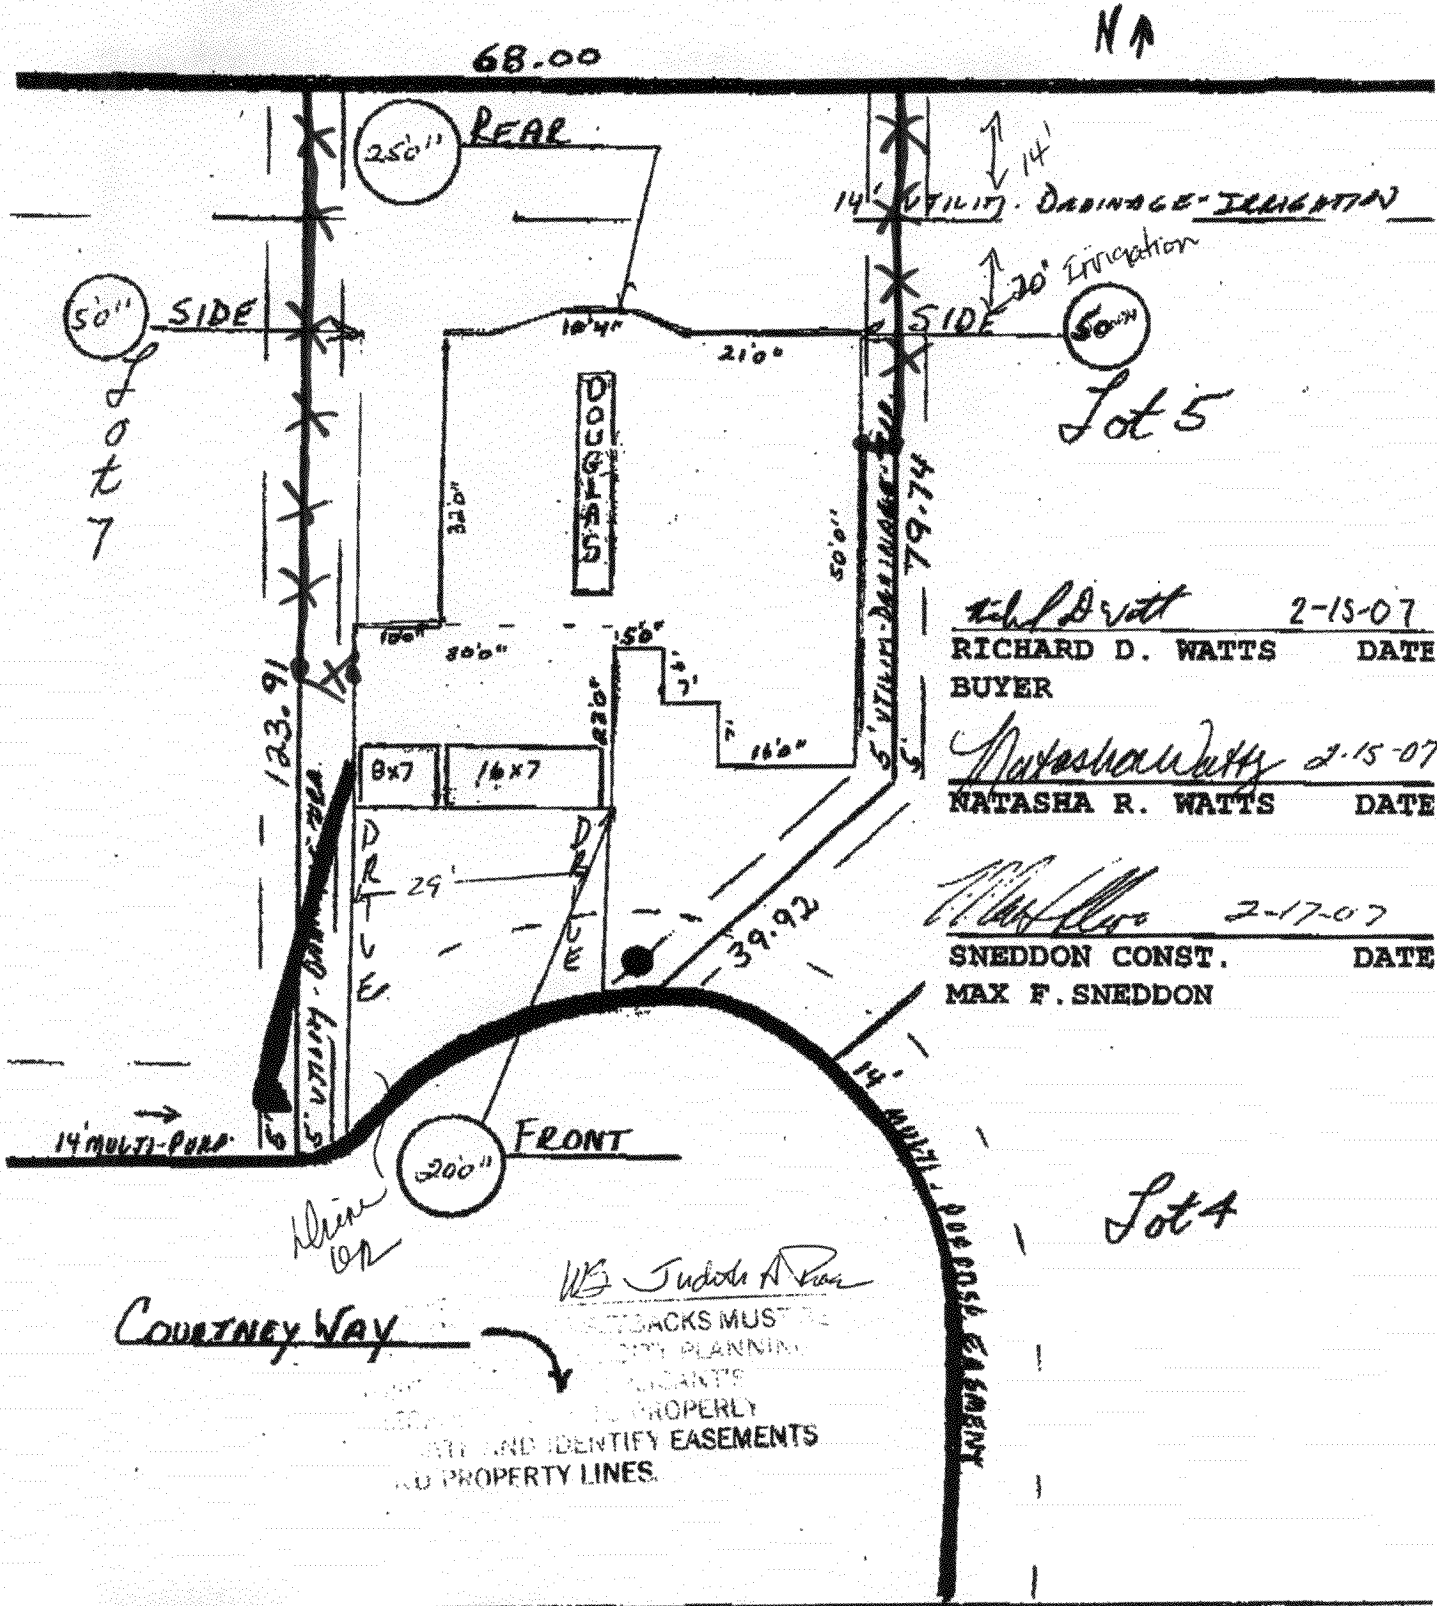

Richard D. Watts 2-15-07
 RICHARD D. WATTS DATE
 BUYER

Natasha R. Watts 2-15-07
 NATASHA R. WATTS DATE

Max F. Sneddon 2-17-07
 SNEDDON CONST. DATE
 MAX F. SNEDDON

COURTNEY WAY

WS Judith A. Poon
 SETBACKS MUST BE
 CITY PLANNING
 PLANNING
 TO PROPERLY
 AND IDENTIFY EASEMENTS
 AND PROPERTY LINES.

Lot 4

Lot 5

Lot 7

14' MULTI-PUMP

Wine

PREPARED BY: SNEDDON CONSTRUCTION INCORPORATED