



Approved
6-24-08
Skip Hartz

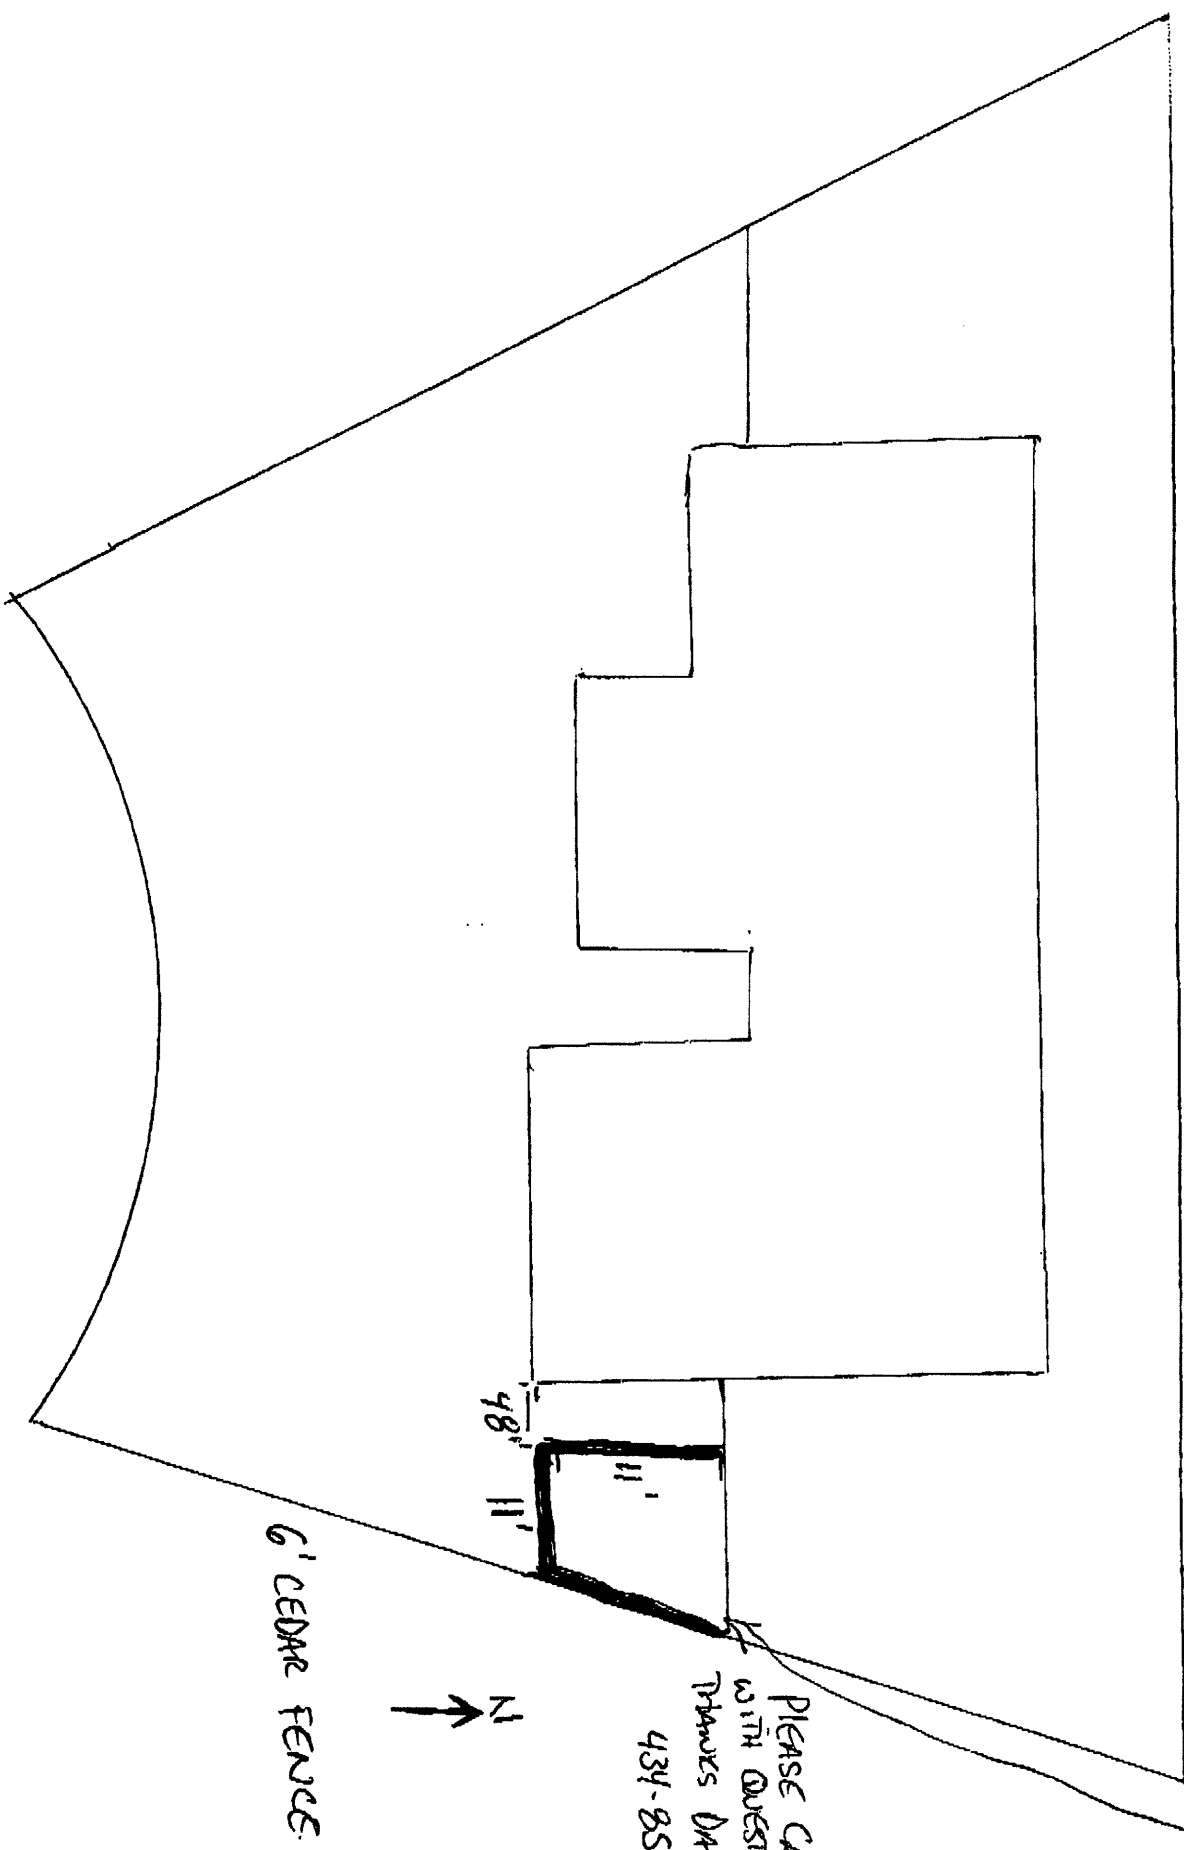

633 KINGS GLEN LOOP.
FENCE CHANGE IN BLUE
THIS IS TO PUT TRAILER IN
BACK YARD.

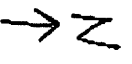

6' CEDAR FENCE

PLEASE CALL
WITH QUESTIONS
DRIVES DRIVE
434-859.