

Fence Permit

PERMIT # **NO** 15421

Public Works & Planning Department
250 North 5th Street
Grand Junction, CO 81501
Phone: (970) 244-1430 FAX: (970) 256-4031

Fee \$10.00

Property Address: 708 Cloverdale DV
 Property Tax No: 2701-353-69-001
 Subdivision: 2620 GRAND Phase II
 Property Owner: Casery Cassioy
 Owner's Telephone: 970 433 0713
 Owner's Address: 708 Cloverdale
 Contractor's Name: Reliable Landscaping Rosewood
 Contractor's Telephone: 970 640 8408
 Contractor's Address: 1752 L Y Road Fruita CO 81521
 Fence Material & Height: ~~wood~~ Vinyl 6'

Plot plan must show property lines and property dimensions, all easements, all rights-of-way, all structures, all setbacks from property lines, and fence height(s). NOTE: Property line is likely one foot or more behind the sidewalk.

THIS SECTION TO BE COMPLETED BY PLANNING STAFF	
ZONE <u>R-5</u>	SETBACKS: Front <u>20</u> from property line (PL) or
SPECIAL CONDITIONS <u>20' from property</u>	<u>Ø</u> from center of ROW, whichever is greater.
<u>line around front curve with 6' ^{width}</u>	Side <u>Ø</u> from PL Rear <u>Ø</u> from PL
<u>per trans eng. see photo.</u>	

Fences exceeding six feet in height require a separate permit from the City/County Building Department. A fence constructed on a corner lot that extends past the rear of the house along the side yard or abuts an alley requires approval from the City Engineer (Section 4.1.J of the Grand Junction Zoning and Development Code).

The owner/applicant must correctly identify all property lines, easements, and rights-of-way and ensure the fence is located within the property's boundaries. Covenants, conditions, restrictions, easements and/or rights-of-way may restrict or prohibit the placement of fence(s). The owner/applicant is responsible for compliance with covenants, conditions, and restrictions which may apply. Fences built in easements may be subject to removal at the property owner's sole and absolute expense. Any modification of design and/or material as approved in this fence permit must be approved, in writing, by the Public Works & Planning Department Director.

I hereby acknowledge that I have read this application and the information and plot plan are correct; I agree to comply with any and all codes, ordinances, laws, regulations, or restrictions which apply. I understand that failure to comply shall result in legal action, which may include but not necessarily be limited to removal of the fence(s) at the owner's cost.

Applicant's Signature [Signature] Date 7/23/08
 Planning Approval [Signature] Date 8/5/08
 City Engineer's Approval (if required) _____ Date _____

VALID FOR SIX MONTHS FROM DATE OF ISSUANCE (Section 2.2.E.1.d Grand Junction Zoning & Development Code)

(White: Planning)


(Yellow: Applicant)

(Pink: Neighborhood Services)


City of Grand Junction GIS City Map ©

8/29/08
TO: LYDIA
FROM: NINA
RE: SIGHT DIST. 708 CLOVERDALE

Parcels	Address Label
Air Photos	2008 Photos
	Highways
	Street Labels
	City Limits
	Grand Junction
	Fruita
	Palisade
	Mesa County

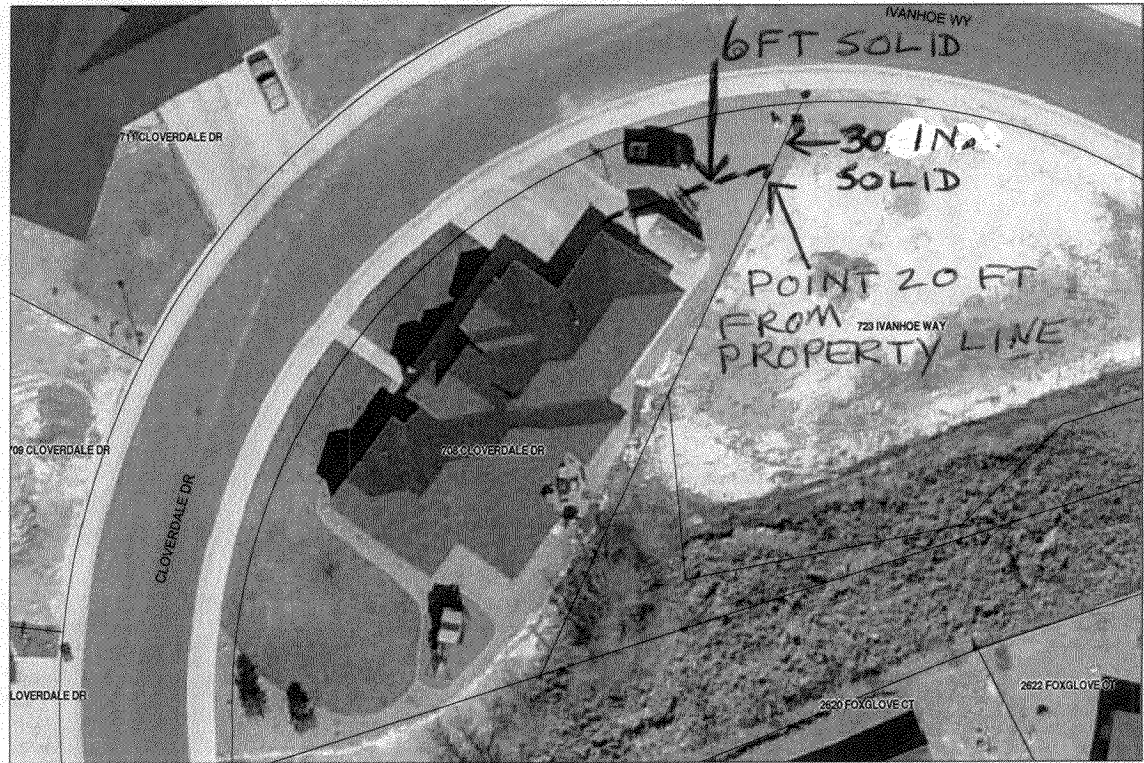

SCALE 1 : 600

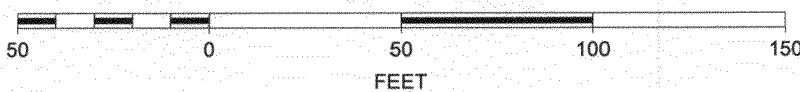

PER TR. ENG. RECOMMENDATION

New

