



# Fence Permit

PERMIT # 14914

Community Development Department  
250 North 5<sup>th</sup> Street  
Grand Junction, CO 81501  
Phone: (970) 244-1430 FAX (970) 236-4031

FEE \$10.00

Property Address: 741 Woodridge Ct, Grand Jct, CO 81505  
 Property Tax No: 2701-341-37-025  
 Subdivision: Woodridge  
 Property Owner: RED HART Homes at Woodridge  
 Owner's Telephone: 234-0822 (Dan)  
 Owner's Address: 2320-E 1/2 Rd. G.J., CO 81503  
 Contractor's Name: RED HART CONST  
 Contractor's Telephone: 234-0822  
 Contractor's Address: 2320-E 1/2 Rd. G.J., CO 81503  
 Fence Material & Height: 3' Tall Tan vinyl privacy + 6' Tall Tan vinyl privacy

Plot plan must show property lines and property dimensions, all easements, all rights-of-way, all structures, all setbacks from property lines, and fence height(s). NOTE: Property line is likely one foot or more behind the sidewalk.

**THIS SECTION TO BE COMPLETED BY COMMUNITY DEVELOPMENT DEPARTMENT STAFF**

ZONE PD SETBACKS: Front \_\_\_\_\_ from property line (PL) or  
 SPECIAL CONDITIONS \_\_\_\_\_ from center of ROW, whichever is greater.  
 Side \_\_\_\_\_ from PL Rear \_\_\_\_\_ from PL

Fences exceeding six feet in height require a separate permit from the City/County Building Department. A fence constructed on a corner lot that extends past the rear of the house along the side yard or abuts an alley requires approval from the City Engineer (Section 4.1.J of the Grand Junction Zoning and Development Code).

The owner/applicant must correctly identify all property lines, easements, and rights-of-way and ensure the fence is located within the property's boundaries. Covenants, conditions, restrictions, easements and/or rights-of-way may restrict or prohibit the placement of fence(s). The owner/applicant is responsible for compliance with covenants, conditions, and restrictions which may apply. Fences built in easements may be subject to removal at the property owner's sole and absolute expense. Any modification of design and/or material as approved in this fence permit must be approved, in writing, by the Community Development Department Director.

I hereby acknowledge that I have read this application and the information and plot plan are correct; I agree to comply with any and all codes, ordinances, laws, regulations, or restrictions which apply. I understand that failure to comply shall result in legal action, which may include but not necessarily be limited to removal of the fence(s) at the owner's cost.

Applicant's Signature Daniel R. Dault Date Jan 27 2008  
 Community Development's Approval Pat Dunlap Date 1/30/08  
 City Engineer's Approval (if required) \_\_\_\_\_ Date \_\_\_\_\_

VALID FOR SIX MONTHS FROM DATE OF ISSUANCE (Section 2.2.E.1.d Grand Junction Zoning & Development Code)


(White: Community Development) (Yellow: Applicant) (Pink: Code Enforcement)

G 1/2 Road

741 Woodridge Ct

Planning Dept.

Fencing Lot 26

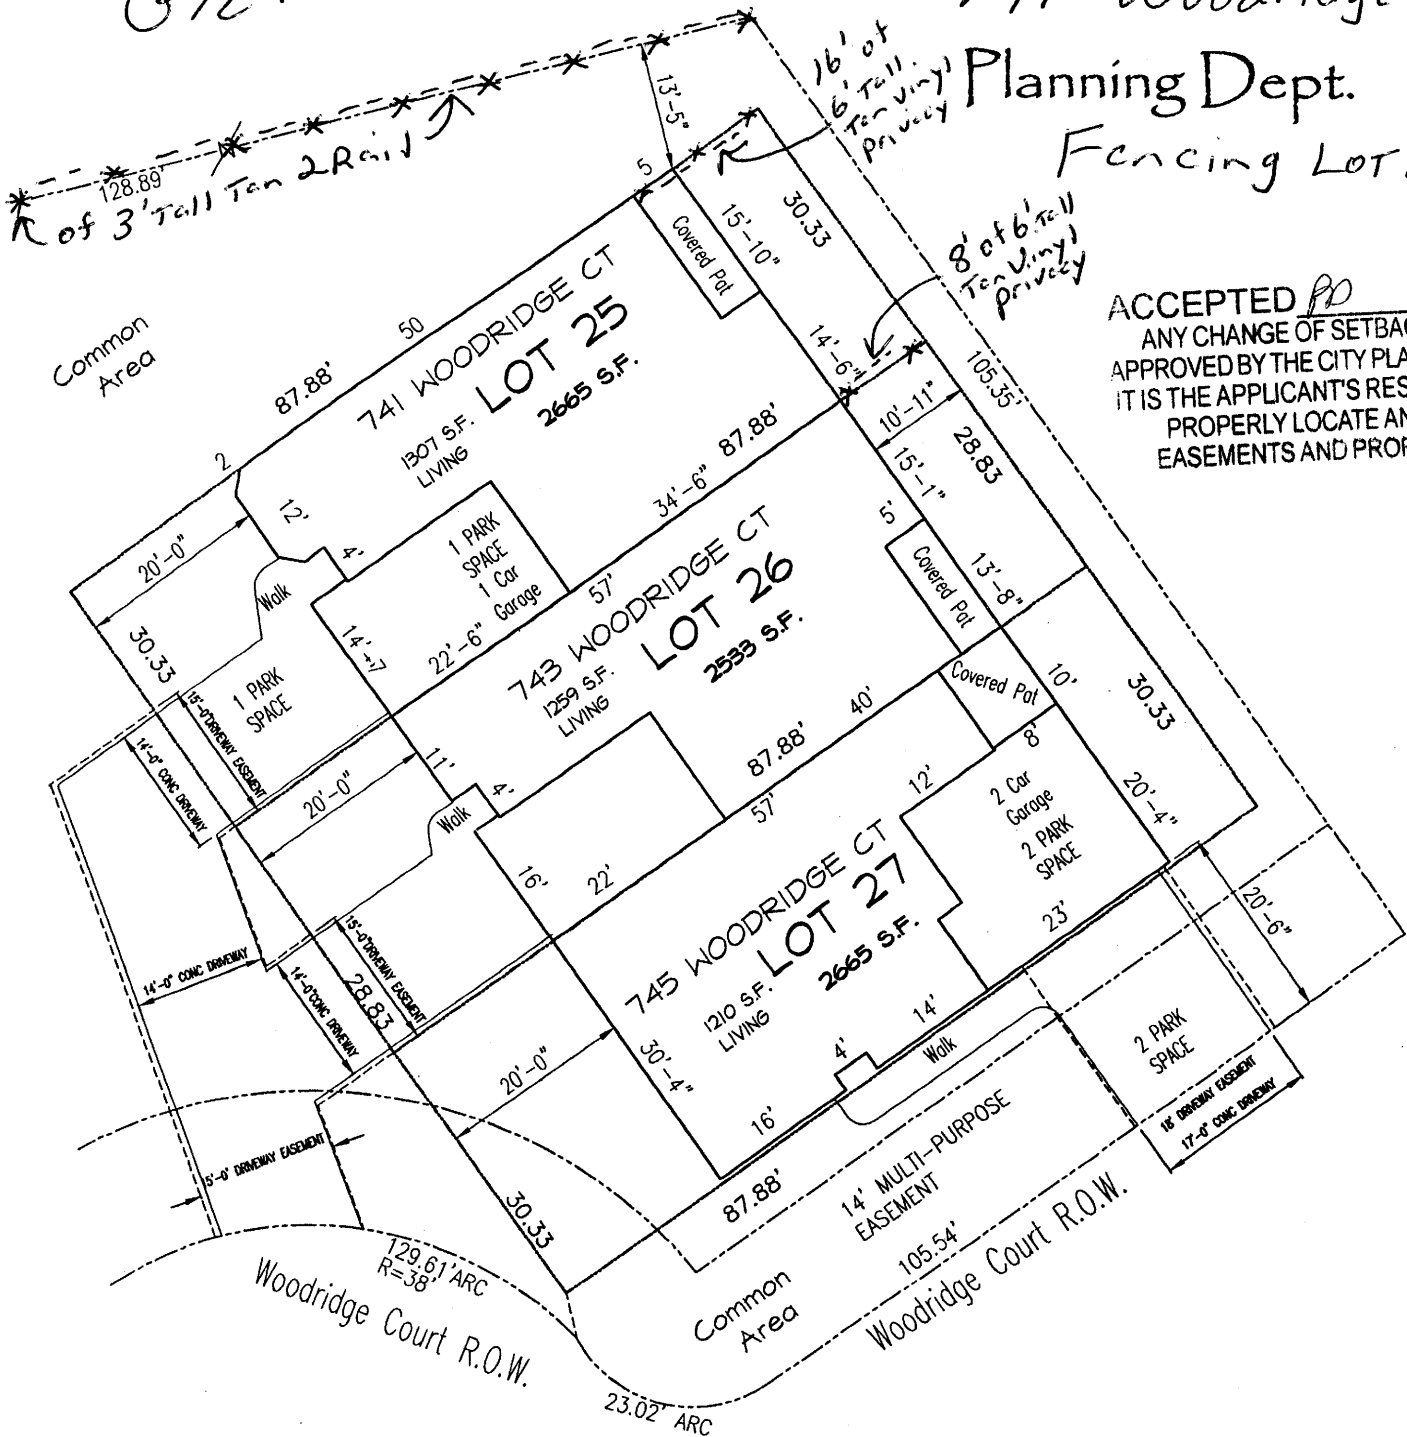

ACCEPTED PD  
 ANY CHANGE OF SETBACKS MUST BE APPROVED BY THE CITY PLANNING DIVISION. IT IS THE APPLICANT'S RESPONSIBILITY TO PROPERLY LOCATE AND IDENTIFY EASEMENTS AND PROPERTY LINES.



**SITE PLAN**

SCALE: 1" = 20"

NORTH



Daniel R. Gearhart  
 970/244-8975

DATE: 12/20/07

SPEC TRIPLEX  
 LOTS 25-26-27  
 741 - 743 - 745 WOODRIDGE COURT

	ACTUAL	SETBACKS	MIN
741-743	20'	FRONT:	20'
745	20'-6"	FRONT:	20'
	10'	REAR:	10'
741	13'-6"	SIDE:	5'
745	20'-0"	SIDE:	5'

FRONT SETBACKS ON BOTH SOUTH AND WEST SIDES