

# Fence Permit

PERMIT # **NO** 15573

Public Works & Planning Department  
250 North 5th Street  
Grand Junction, CO 81501  
Phone: (970) 244-1430 FAX: (970) 256-4031

Fee \$10.00

Property Address: 825 27 1/4 Rd  
 Property Tax No: 2701-253-00-293  
 Subdivision: \_\_\_\_\_  
 Property Owner: STEVE KESSBERGER  
 Owner's Telephone: 970-241-4921  
 Owner's Address: 825 27 1/4 Rd  
 Contractor's Name: INDUSTRIAL DEVELOPMENTS, INC  
 Contractor's Telephone: 970-242-3214  
 Contractor's Address: 320 GRAND AVE  
 Fence Material & Height: CHAIN LINK 6'

Plot plan must show property lines and property dimensions, all easements, all rights-of-way, all structures, all setbacks from property lines, and fence height(s). NOTE: Property line is likely one foot or more behind the sidewalk.

| THIS SECTION TO BE COMPLETED BY PLANNING STAFF |  |
|--|--|
| ZONE <u>R-1</u>                                | SETBACKS: Front <u>20</u> from property line (PL) or _____ from center of ROW, whichever is greater. |
| SPECIAL CONDITIONS <u>none</u>                 | Side <u>0</u> from PL Rear <u>0</u> from PL  |

Fences exceeding six feet in height require a separate permit from the City/County Building Department. A fence constructed on a corner lot that extends past the rear of the house along the side yard or abuts an alley requires approval from the City Engineer (Section 4.1.J of the Grand Junction Zoning and Development Code).

The owner/applicant must correctly identify all property lines, easements, and rights-of-way and ensure the fence is located within the property's boundaries. Covenants, conditions, restrictions, easements and/or rights-of-way may restrict or prohibit the placement of fence(s). The owner/applicant is responsible for compliance with covenants, conditions, and restrictions which may apply. Fences built in easements may be subject to removal at the property owner's sole and absolute expense. Any modification of design and/or material as approved in this fence permit must be approved, in writing, by the Public Works & Planning Department Director.

I hereby acknowledge that I have read this application and the information and plot plan are correct; I agree to comply with any and all codes, ordinances, laws, regulations, or restrictions which apply. I understand that failure to comply shall result in legal action, which may include but not necessarily be limited to removal of the fence(s) at the owner's cost.


Applicant's Signature [Signature] Date 9-12-08  
 Planning Approval [Signature] Date 9/12/08  
 City Engineer's Approval (if required) \_\_\_\_\_ Date \_\_\_\_\_

**VALID FOR SIX MONTHS FROM DATE OF ISSUANCE** (Section 2.2.E.1.d Grand Junction Zoning & Development Code)

(White: Planning)

(Yellow: Applicant)

(Pink: Neighborhood Services)

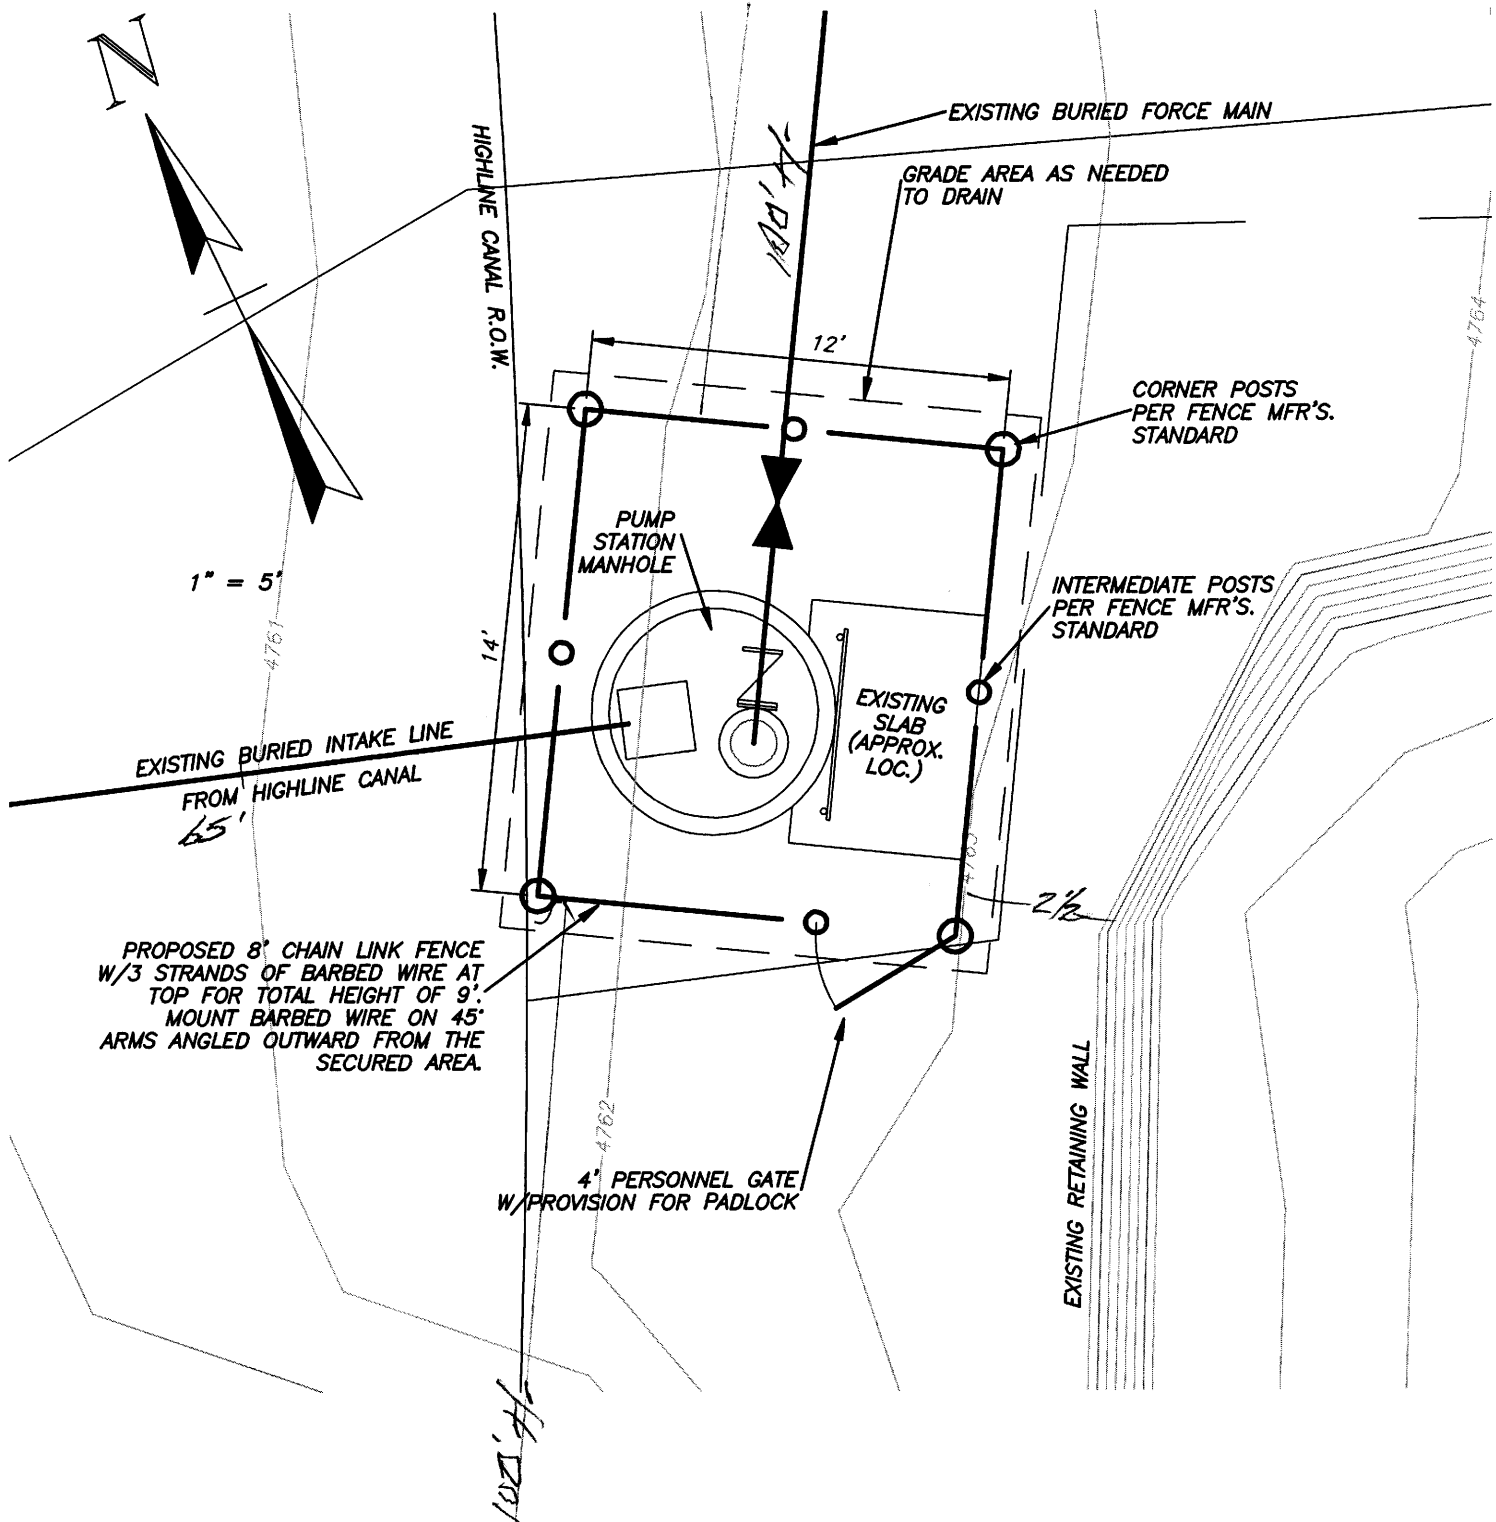

**PROPOSED SECURITY FENCE**  
**BOOKCLIFF TECH PARK**  
**IRRIGATION SUPPLY PUMP STATION**  
**SHARPER ENGINEERING SERVICES**

9/9/08 CFR

# 825 27 1/4 Rd



SCALE 1 : 793

