

Fence Permit

PERMIT # N^o 15156

Public Works & Planning Department
250 North 5th Street
Grand Junction, CO 81501
Phone: (970) 244-1430 FAX: (970) 256-4031

Fee \$10.00

Property Address: 2933 Annelie Ln
Property Tax No: 2943-053-90-003
Subdivision: Forrest Estates
Property Owner: Norbert Braubenger
Owner's Telephone: 800-617-7355
Owner's Address: Same
Contractor's Name: Valleywide Fence
Contractor's Telephone: (970) 523-8150
Contractor's Address: 2105 E. Main St.
Fence Material & Height: 6' Vinyl

Plot plan must show property lines and property dimensions, all easements, all rights-of-way, all structures, all setbacks from property lines, and fence height(s). NOTE: Property line is likely one foot or more behind the sidewalk.

THIS SECTION TO BE COMPLETED BY PLANNING STAFF

ZONE R-5 SETBACKS: Front 20 from property line (PL) or
SPECIAL CONDITIONS _____ from center of ROW, whichever is greater.
Side 0 from PL Rear 0 from PL

Fences exceeding six feet in height require a separate permit from the City/County Building Department. A fence constructed on a corner lot that extends past the rear of the house along the side yard or abuts an alley requires approval from the City Engineer (Section 4.1.J of the Grand Junction Zoning and Development Code).

The owner/applicant must correctly identify all property lines, easements, and rights-of-way and ensure the fence is located within the property's boundaries. Covenants, conditions, restrictions, easements and/or rights-of-way may restrict or prohibit the placement of fence(s). The owner/applicant is responsible for compliance with covenants, conditions, and restrictions which may apply. Fences built in easements may be subject to removal at the property owner's sole and absolute expense. Any modification of design and/or material as approved in this fence permit must be approved, in writing, by the Public Works & Planning Department Director.

I hereby acknowledge that I have read this application and the information and plot plan are correct; I agree to comply with any and all codes, ordinances, laws, regulations, or restrictions which apply. I understand that failure to comply shall result in legal action, which may include but not necessarily be limited to removal of the fence(s) at the owner's cost.

Applicant's Signature [Signature] Date 4/10/08

Planning Approval Judith A. [Signature] Date 4/11/08

City Engineer's Approval (if required) _____ Date _____


VALID FOR SIX MONTHS FROM DATE OF ISSUANCE (Section 2.2.E.1.d Grand Junction Zoning & Development Code)

(White: Planning)

(Yellow: Applicant)

(Pink: Neighborhood Services)

2933 ANNIE LANE LOT 3 - BLOCK 4 - FOREST ESTATES - FRUIT
SITE / PLOT PLAN - DOUGLAS MODEL - SCALE - 3/4" = 1'-0"

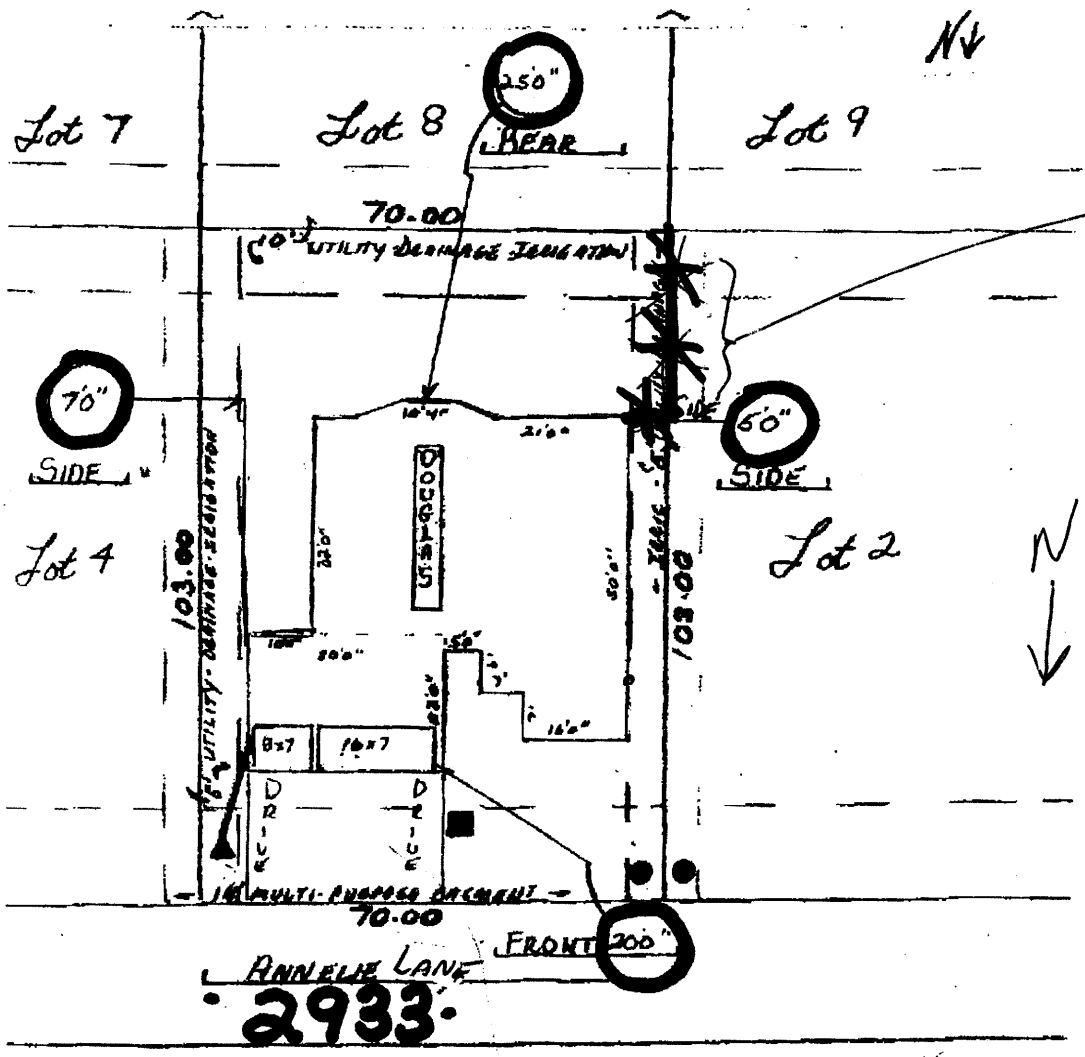

Proposed
fence
April 2008

drive oil
at 2/06

PREPARED BY **SKEDDON CONSTRUCTION INCORPORATED**

ACCEPTED *Raylen Henderson*
ANY CHANGES TO THIS PLAN MUST BE
IN WRITING AND APPROVED BY THE
LOCAL AUTHORITY.
AND PRINTED ON THESE DOCUMENTS