



# Fence Permit

PERMIT #

15021

Community Development Department  
250 North 5<sup>th</sup> Street  
Grand Junction, CO 81501  
Phone: (970) 244-1430 FAX (970) 236-4031

FEE \$10.00

Property Address: 3144 Open Meadows Ct

Property Tax No: 2943-132-95-006

Subdivision: Summit View Meadows

Property Owner: Star Lango

Owner's Telephone: (970) 778-5456

Owner's Address: Same

Contractor's Name: Valleywide Fence

Contractor's Telephone: (970) 523-8150

Contractor's Address: 2105 E Main St

Fence Material & Height: 6' Vinyl + 3' Vinyl

Plot plan must show property lines and property dimensions, all easements, all rights-of-way, all structures, all setbacks from property lines, and fence height(s). NOTE: Property line is likely one foot or more behind the sidewalk.

**THIS SECTION TO BE COMPLETED BY COMMUNITY DEVELOPMENT DEPARTMENT STAFF**

ZONE R-8 SETBACKS: Front \_\_\_\_\_ from property line (PL) or  
 SPECIAL CONDITIONS \_\_\_\_\_ from center of ROW, whichever is greater.  
 Side \_\_\_\_\_ from PL Rear \_\_\_\_\_ from PL

Fences exceeding six feet in height require a separate permit from the City/County Building Department. A fence constructed on a corner lot that extends past the rear of the house along the side yard or abuts an alley requires approval from the City Engineer (Section 4.1.J of the Grand Junction Zoning and Development Code).

The owner/applicant must correctly identify all property lines, easements, and rights-of-way and ensure the fence is located within the property's boundaries. Covenants, conditions, restrictions, easements and/or rights-of-way may restrict or prohibit the placement of fence(s). The owner/applicant is responsible for compliance with covenants, conditions, and restrictions which may apply. Fences built in easements may be subject to removal at the property owner's sole and absolute expense. Any modification of design and/or material as approved in this fence permit must be approved, in writing, by the Community Development Department Director.

I hereby acknowledge that I have read this application and the information and plot plan are correct; I agree to comply with any and all codes, ordinances, laws, regulations, or restrictions which apply. I understand that failure to comply shall result in legal action, which may include but not necessarily be limited to removal of the fence(s) at the owner's cost.

Applicant's Signature [Signature] Date 2/13/08

Community Development's Approval [Signature] Date 2/26/08

City Engineer's Approval (if required) \_\_\_\_\_ Date \_\_\_\_\_

VALID FOR SIX MONTHS FROM DATE OF ISSUANCE (Section 2.2.E.1.d Grand Junction Zoning & Development Code)

(White: Community Development)


(Yellow: Applicant)

(Pink: Code Enforcement)


PLANNING  
 MAPS  
 IDENTIFY EASEMENTS  
 AND PROPERTY LINES

*Handwritten signature and date: 3/12/07*

3144 Open Meadows Ct  
 Lot 6 Block 1  
 5545 sq. ft.

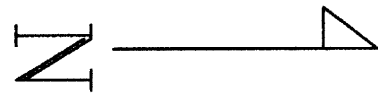

**OPEN MEADOWS COURT**

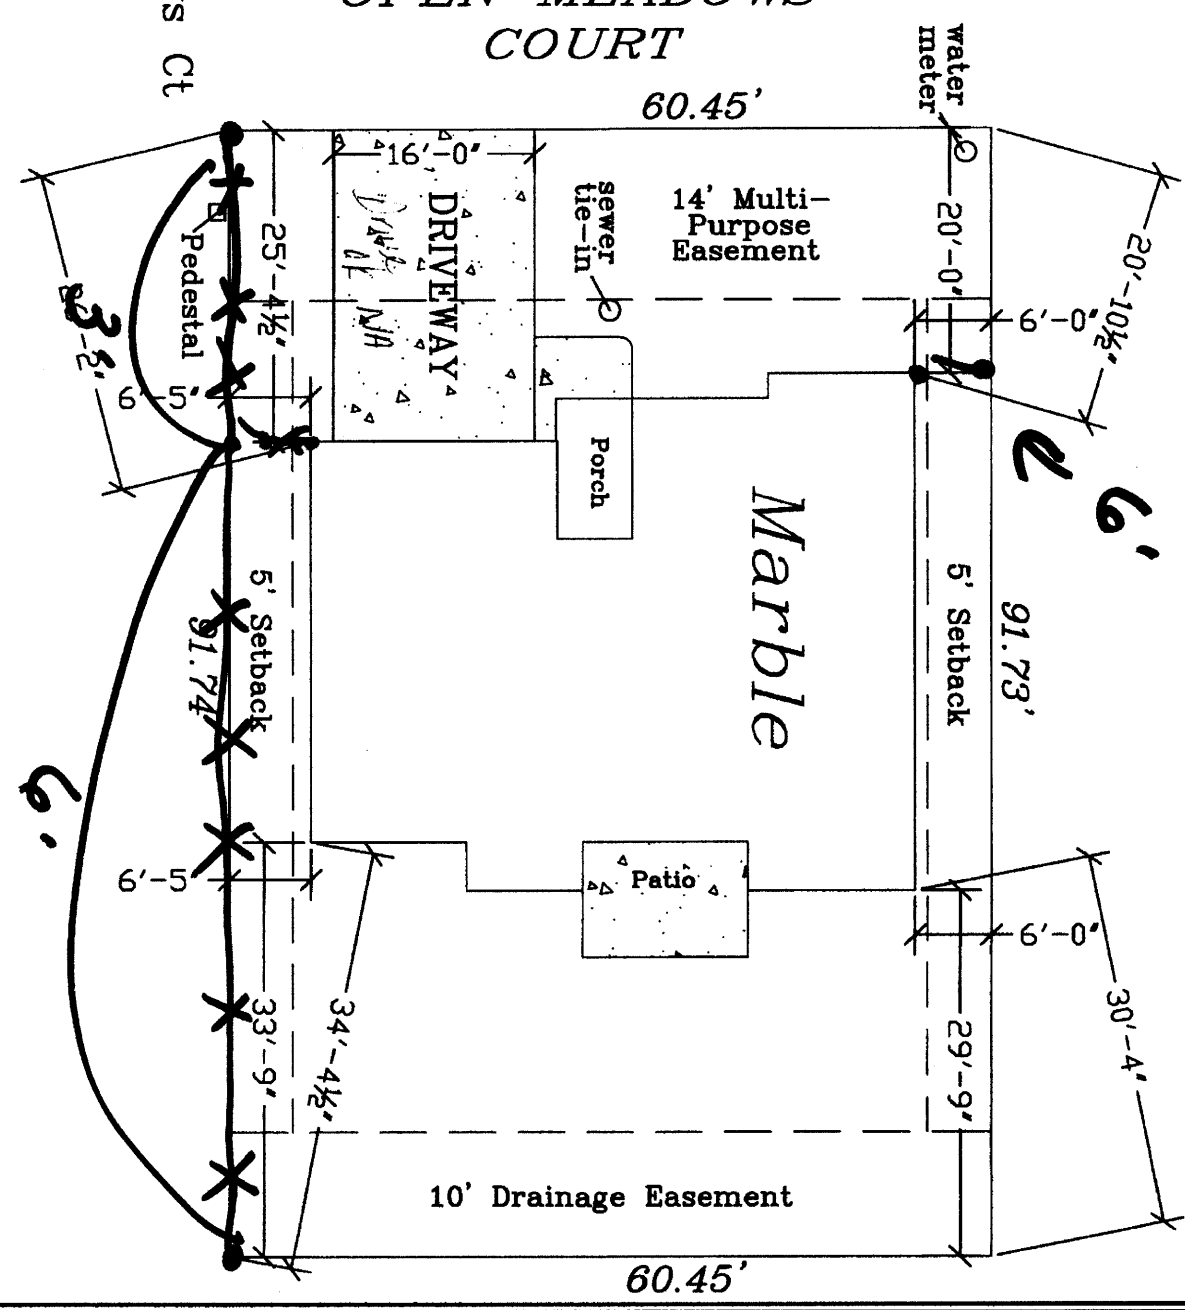

	Zeck Homes, Inc 1950 Hwy 6 & 50 Fruita, CO 81521 (970) 858-0178	3144 Open Meadows Court Summit View Meadows II Lot 6 Block 1	11/14/08 11/14/08 11/14/08
	11/14/08 11/14/08 11/14/08	11/14/08 11/14/08 11/14/08	11/14/08 11/14/08 11/14/08