

DATE SUBMITTED: 4-1-89


PERMIT # \_\_\_\_\_

FEE 5.00

# FENCE PERMIT

GRAND JUNCTION PLANNING DEPARTMENT

BLDG ADDRESS: 2759 UNTRWEEP  
 TAX SCHEDULE #: 2945-251-01-001  
 PROPERTY OWNER: RR Wilson  
 PHONE: 245 7037  
 CONTRACTOR: Self  
 PHONE: 245 7037  
 MATERIAL: PINE - 20 FT' Long  
 HEIGHT: 4'

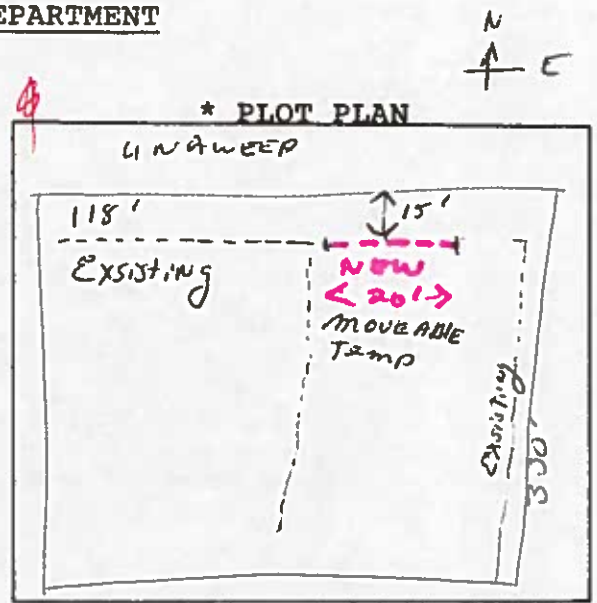

\*Showing Property Line Dimensions, Easements, Streets, all Structures, and Setbacks from Property Lines.

\*\*\*\*\*  
 FOR OFFICE USE ONLY

ZONE: RSF-8

SETBACKS: F 30 PI S 0 R 0

SPECIAL CONDITIONS: 4 foot solid fence shall meet front yard setback of 20 feet from property line

FINAL PERMIT

WILL REQUIRE SEPARATE PERMIT FROM THE CITY/COUNTY BUILDING DEPARTMENT.

\*\*\*\*\*

ANY MODIFICATION TO THIS APPROVED FENCE PERMIT MUST BE APPROVED, IN WRITING, BY THIS DEPARTMENT.

I HEREBY ACKNOWLEDGE THAT I HAVE READ THIS APPLICATION AND THE ABOVE IS CORRECT, AND I AGREE TO COMPLY WITH THE REQUIREMENTS ABOVE. FAILURE TO COMPLY SHALL RESULT IN LEGAL ACTION.

[Signature]  
 SIGNATURE

APPROVED BY: Linda Watzel

DATE APPROVED: 3/28/89