

Fence Permit

PERMIT # 15308


FEE \$10.00

Community Development Department 250 North 5th Street Grand Junction, CO 81501 Phone: (970) 244-1430 FAX (970) 236-4031

Property Address: 3020 May	al c/
Property Tax No: 2943 - 043 -	
Subdivision: Mongreh C	=1=1
Property Owner: William Sc	
Owner's Telephone: 970 - 216 - 10	70 cell Home 433-7798
Owner's Address:	
Contractor's Name: Same	
Contractor's Telephone:	
Contractor's Address:	
Fence Material & Height: Ctdav 6	/
	ensions, all easements, all rights-of-way, all structures, all setbacks erty line is likely one foot or more behind the sidewalk.
THIS SECTION TO BE COMPLETED E	Y COMMUNITY DEVELOPMENT DEPARTMENT STAFF
ZONE	SETBACKS: Front from property line (PL) or
SPECIAL CONDITIONS	from center of ROW, whichever is greater.
	Sidefrom PL Rearfrom PL
lot that extends past the rear of the house along the side y the Grand Junction Zoning and Development Code). The owner/applicant must correctly identify all property liproperty's boundaries. Covenants, conditions, restriction fence(s). The owner/applicant is responsible for compliance easements may be subject to removal at the property own approved in this fence permit must be approved, in writing	
codes, ordinances, laws, regulations, or restrictions which include but not necessarily be limited to remo val of the fe	· ·
Applicant's Signature	Date 6-21-07 Date 6-21-07
Community Development's Approval <u>Judi</u> y	h A. Rica Date 6-21-07
City Engineer's Approval (if required)	Date

VALID FOR SIX MONTHS FROM DATE OF ISSUANCE (Section 2.2.E.1.d Grand Junction Zoning & Development Code)

(White: Community Development) (Yellow: Applicant) (Pink: Code Enforcement)

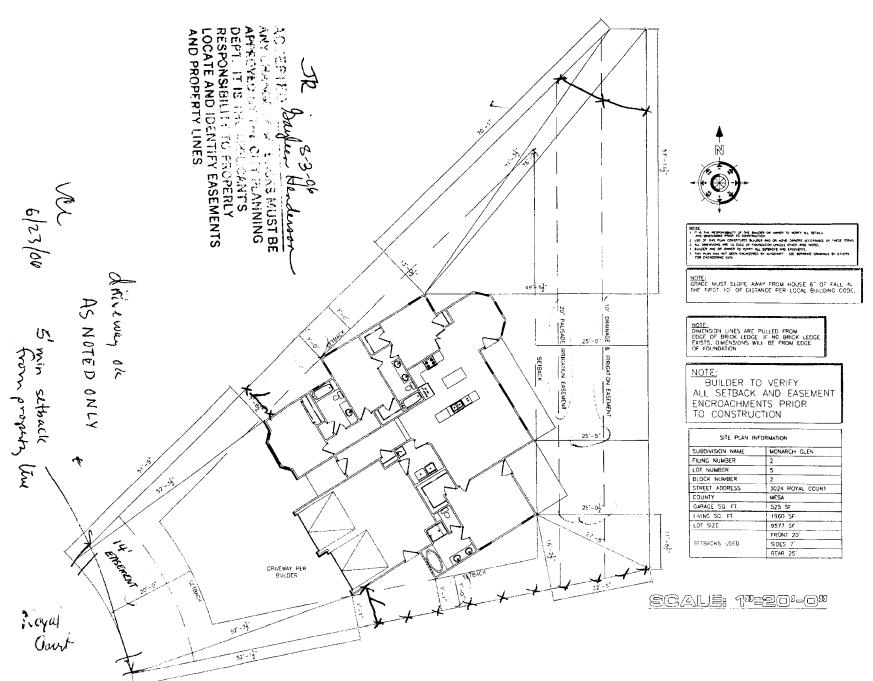

1