

FEE \$10.00

650, 660, 662, 664, 666, 670, 672, 674

003, 004, 005, 006, 007, 009, 010, 011

PERMIT # 10257

FENCE PERMIT

GRAND JUNCTION COMMUNITY DEVELOPMENT DEPARTMENT

THIS SECTION TO BE COMPLETED BY APPLICANT

PROPERTY ADDRESS 658-674 KAPOTA
EVEN'S EXCLUDING 668

TAX SCHEDULE NO 2945-031-43(003-01)

PROPERTY OWNER VALLEY MEADOWS EAST
HOME OWNERS ASSOC.

OWNER'S PHONE (970) 243-6763
SUNDANCE PROPERTIES

OWNER'S ADDRESS 1460 N. AVE. UNIT G.


CONTRACTOR MARANATHA FENCE

CONTRACTOR'S PHONE (970) 241-9303

FENCE MATERIAL CEDAR

FENCE HEIGHT 6'-0"

PLOT PLAN

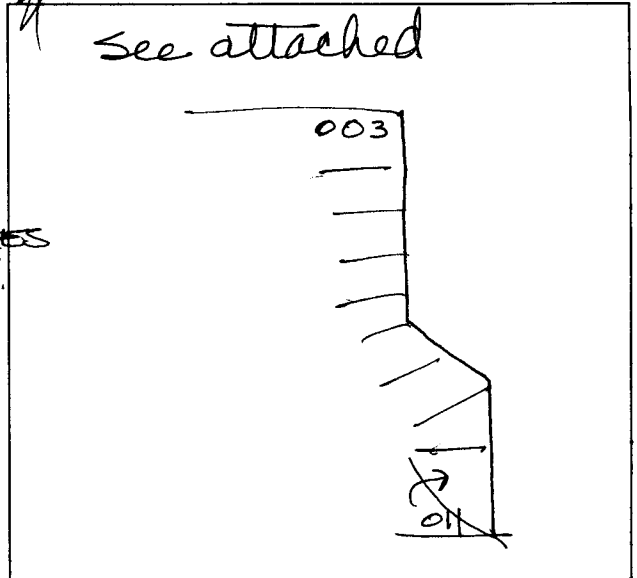

Plot plan must show property lines and property dimensions, all easements, all rights-of-way, all structures, all setbacks from property lines, & fence height(s).

THIS SECTION TO BE COMPLETED BY COMMUNITY DEVELOPMENT DEPARTMENT STAFF

ZONE PR 2.93 SETBACKS: Front 20' from property line (PL) or
 SPECIAL CONDITIONS _____ from center of ROW, whichever is greater.
FP-1997-007 Side _____ from PL Rear _____ from PL

Fences exceeding six feet in height require a separate permit from the City/County Building Department. A fence constructed on a corner lot that extends past the rear of the house along the side yard or abuts an alley requires approval from the City Engineer (Section 5-5-5B of the Grand Junction Zoning and Development Code).

The owner/applicant must correctly identify all property lines, easements, and rights-of-way and ensure the fence is located within the property's boundaries. Covenants, conditions, restrictions, easements and/or rights-of-way may restrict or prohibit the placement of fence(s). The owner/applicant is responsible for compliance with covenants, conditions, and restrictions which may apply. Fences built in easements may be subject to removal at the property owner's sole and absolute expense. Any modification of design and/or material as approved in this fence permit must be approved, in writing, by the Community Development Department Director.

I hereby acknowledge that I have read this application and the information and plot plan are correct; I agree to comply with any and all codes, ordinances, laws, regulations, or restrictions which apply.

I understand that failure to comply shall result in legal action, which may include but not necessarily be limited to removal of the fence(s) at the owner's cost.

Applicant's Signature Jana L. Bringham Date 4/3/98



Community Development's Approval Jana L. Castello Date 4/3/98

City Engineer's Approval (if required) _____ Date _____

VALID FOR SIX MONTHS FROM DATE OF ISSUANCE (Section 9-3-2D Grand Junction Zoning & Development Code)

(White: Community Development) (Yellow: Code Enforcement) (Pink: Customer)

VALLEY MEADOWS EAST

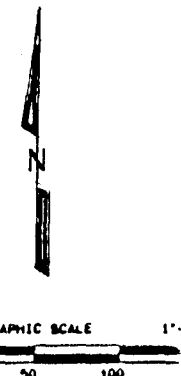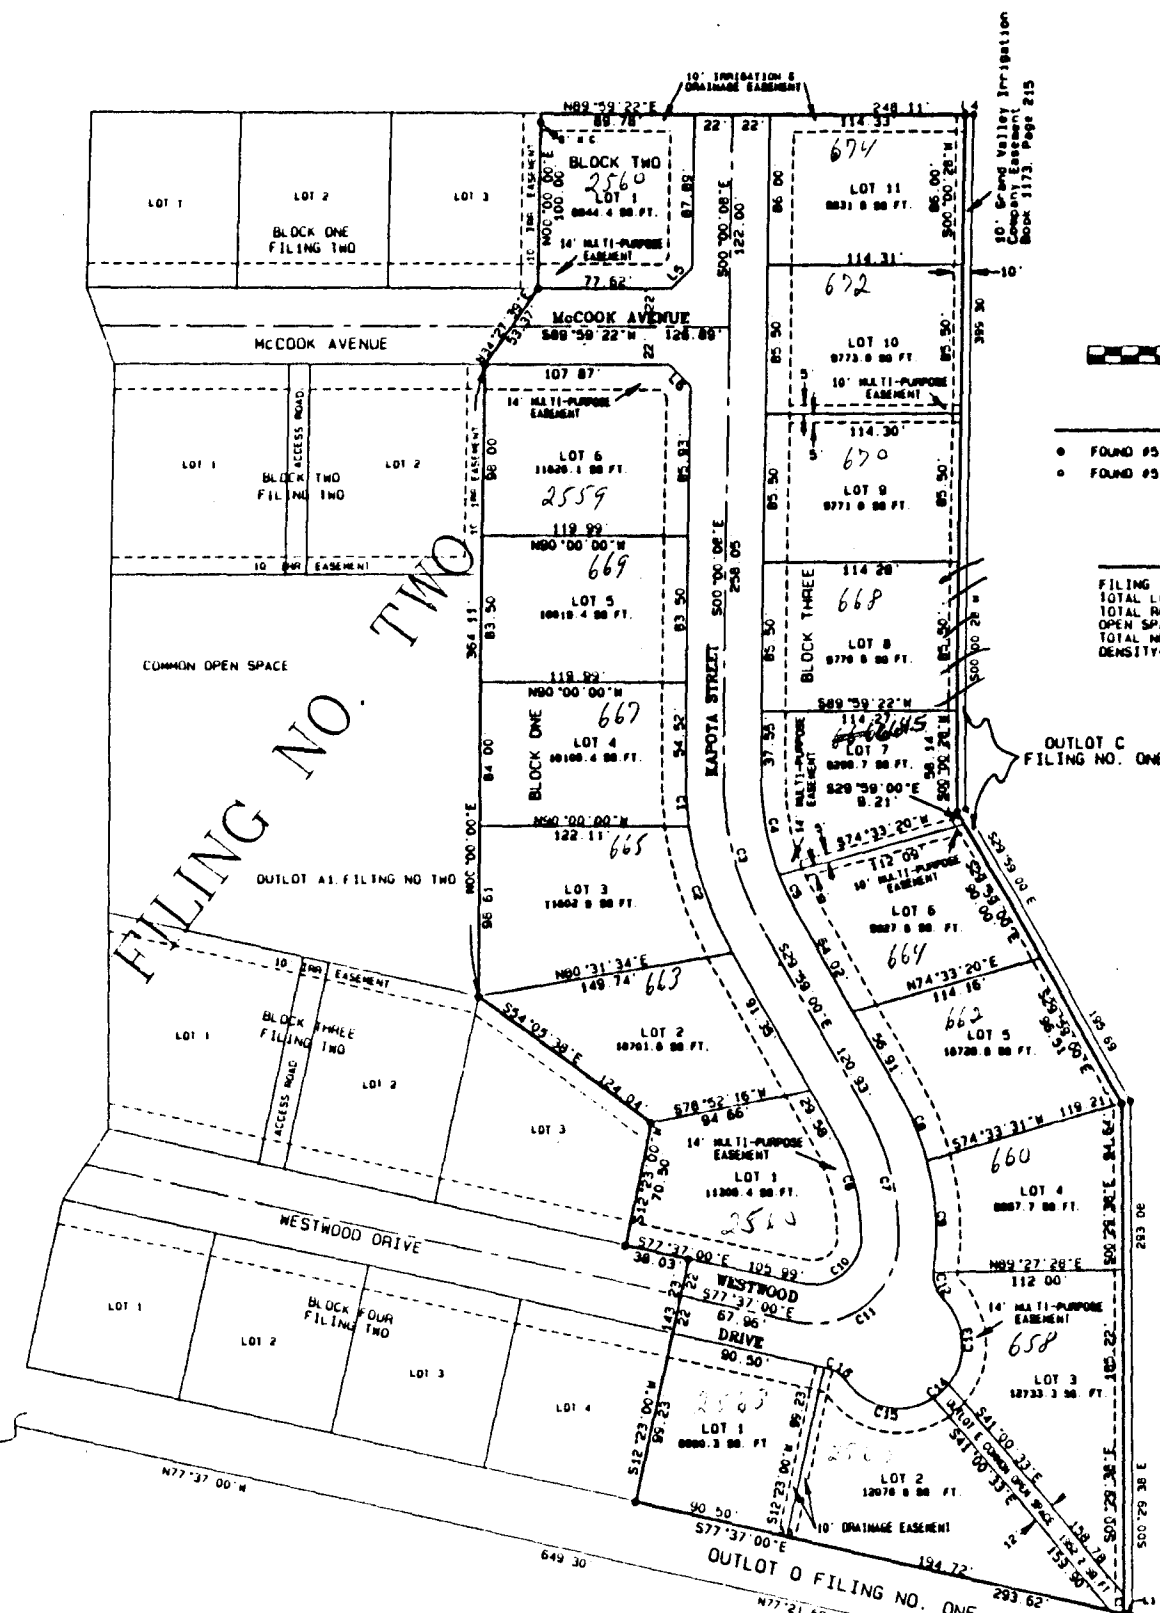

- LEGEND**
- FOUND #5 REBAR & CAP IN CONCRETE 'L.S.
 - FOUND #5 REBAR & CAP 'M.P.P. L.S.' 266.

LAND USE SUMMARY

FILING THREE TOTAL AREA:	5.33 ACRES
TOTAL LOT AREA:	4.27 ACRES
TOTAL ROAD R.O.W. AREA:	1.02 ACRES
OPEN SPACE AREA:	0.04 ACRES
TOTAL NO OF LOTS IN FILING THREE:	18
DENSITY:	3.38 LOTS PER ACRE

BUILDING SETBACK

FRONT : 20'
 REAR : 20'
 SIDE : 10'
 32' MAXIMUM HEIGHT
 ACCESSORY BUILDINGS
 REAR AND SIDE : 3'

CLERK AND RECORDS
 COUNTY OF COLORADO
 STATE OF MESA

I hereby certify
 this is a true and correct
 copy of the original
 Plat Book

Clerk and Recorder
 Fees

CURVE	ARC
C1	29.58'
C2	78.74'
C3	96.80'
C4	39.72'
C5	25.93'
C6	56.05'
C7	78.85'
C8	38.74'
C9	64.54'
C10	53.45'
C11	61.43'
C12	16.12'
C13	54.71'
C14	12.06'
C15	56.93'
C16	16.25'

LINE TABLE

LINE	BEARING	DISTANCE
L1	S77°37'00"E	5.13
L2	S77°37'00"E	8.39
L3	N00°29'38"W	10.77
L4	N89°59'22"E	5.00
L5	N45°07'05"E	17.17
L6	S45°04'10"E	17.12

NOTICE: According to Colorado law you must commence any legal action based upon any defect in this survey within three years after the first discovery of such defect. In no event may any action based upon any defect in this survey be commenced more than ten years from the date of the certification shown hereon.

THE FOLLOWING IS
 A FENCING ALONG
 FILING NO. TWO
 OF A SPLIT IN
 HOMEOWNER'S