

DATE SUBMITTED: 3/29/90

PERMIT # _____

FEE 75.00

Contractor # 2900244
Quantity # 38

SIGN PERMIT

GRAND JUNCTION PLANNING DEPARTMENT

BUSINESS NAME: Little Caesar's Pizza

BUSINESS ADDRESS: 2889 North Ave

STREET FRONTAGE: FRONT 125 FT. SIDE 220 FT. *Melody Ln*

BUILDING FRONTAGE: FRONT 75 FT. SIDE 190 FT.

TRAFFIC LANE: FRONT 4 FT. SIDE 2 lanes x .75 FT.

HEIGHT OF SIGN: _____ FT. CLEARANCE TO GRADE: _____ FT.

AREA OF SIGN: 26.76 SQ. FT. AREA OF EXISTING SIGNS: 108.5 SQ. FT. *(on Melody Ln)*


TOTAL ALLOWED AREA: FRONT 50 SQ. FT. SIDE 380 SQ. FT.

** does not include free standing on North Ave.*

TYPE OF SIGN

*SKETCH

- ON PREMISE
- OFF PREMISE
- FREE STANDING
- PROJECTING
- ROOF
- FLUSH WALL
- ILLUMINATED
- OTHER

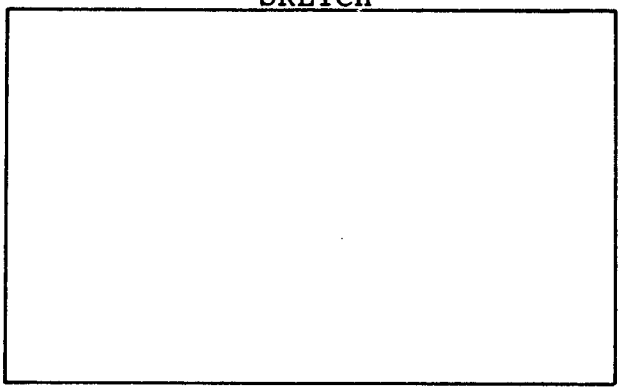

*Include: Streets, Property Lines, Proposed Sign Location.

COMMENTS _____

TAX SCH # 2943-181-05-022
007

PROPERTY OWNER: George Metz

ADDRESS: #2 Cognac Ct

CONTRACTOR: Grand Jet Sign

ADDRESS: 2915 Hill Ave

PHONE: 245-2950

Barbara Peltus
Signature


APPROVED BY: Kathy Peltus

DATE APPROVED: 3/29/90

- FINAL PERMIT
- WILL REQUIRE SEPARATE PERMIT

WORTH

② 4x5

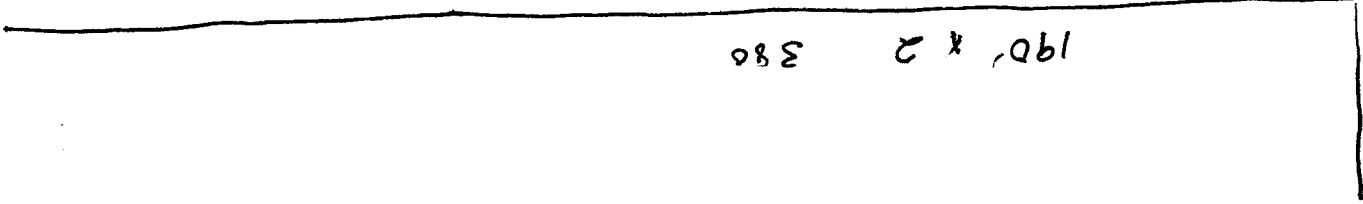

2) HAVE
Melody 210


Subway
3x8
① 24φ

New
To
You
3x8
④ 24φ

AM
AIR
LINE
3.5x7
⑦ 24.5φ


Hols from
3x12
⑧ 36φ

TOTAL 109.50φ

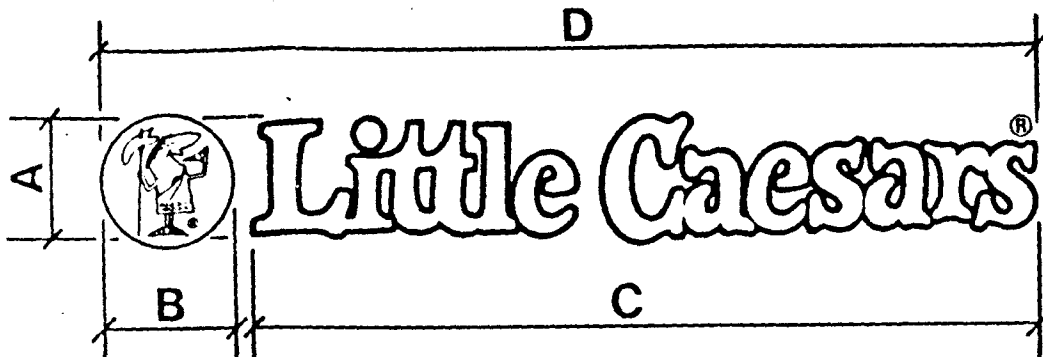

STANDARD SIZES			
A	B	C	D
16"	19"	9'-6"	11'-0 1/4"
21"	25"	13'-2 1/4"	15'-6"
24"	29"	15'	17'-8"
30"	36"	18'-10"	21'-2"
36"	43 1/4"	22'-4 1/4"	26'-4"

~~18" 20" 10'9" 12'4"~~

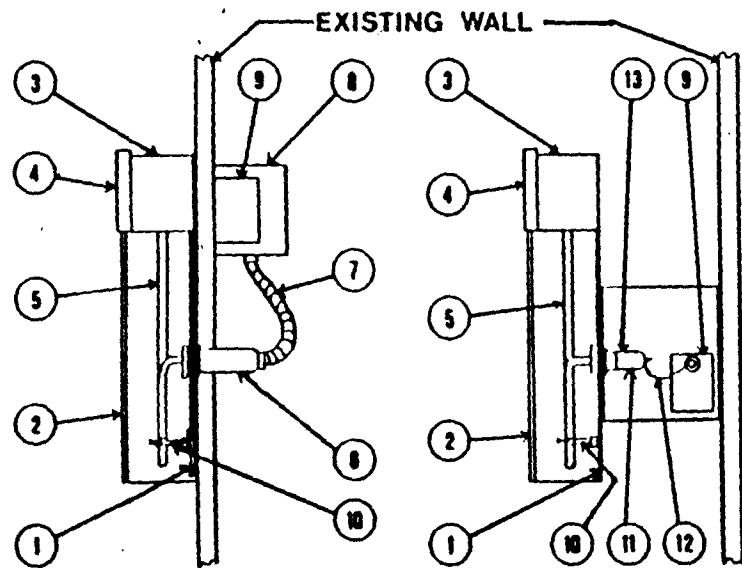

WALL MOUNTED

RACEWAY

TYPICAL INSTALLATIONS

LEGEND

U.L. APPROVED
 FABRICATED CONSTRUCTION - WELD/RIVET
 SEALED W/WHITE SILICONE FOR WEATHERPROOFING

- BACK: .080 ALUMINUM - 3003 (ALLOY) H14 SHEET
- FACE: 3/16" ACRYLIC SHEET (ROHM & HAAS #7328 WHITE, #2119 ORANGE) (SECURED W/1/8 SHEET METAL SCREWS PAINTED BLACK.)
- SIDES: .040 ANODIZED, MATTE BLACK/WHITE ALUM. SHEET
- TRIM - CAP: 3/4" & 1" BLACK
- NEON TUBELITE: 13MM #6500 WHITE, CLEAR RED
- ELECTRODE RECEPTACLE (PK 7500/TC 2000)
- CONDUIT & CONNECTORS (TYPICAL)
- LUMINOUS TUBE TRANSFORMER (NON-WEATHERROOF 30 M.A.)
- TRANSFORMER BOX
- 1 3/4" TUBE SUPPORTS W/WIRE & METAL BASE
- GLASS ELECTORDE RECEPTACLE
- GTO (TYPICAL) WIRE
- RACEWAY


COLOR LEGEND

LITTLE CAESARS LETTERS - WHITE, W/BLACK OUTLINE
 (TRIM CAP)
 PIZZA! PIZZA! LETTERS - P.M.S. #165-C, W/BLACK OUTLINE
 (TRIM CAP)
 LOGO - BACKGROUND: WHITE
 LINEWORK: BLACK
 PIZZA, PIZZA SLICE & TOGA: ORANGE #165C
 (SEE SPEC. MANUAL SHEET G-1)

DEC-29-89 FRI 9:40

→  Little Caesars

21"
INDIVIDUAL NEON LETTERS WITH
ORANGE FACE, MOUNT ON RAIL-
WAY PAINTED TO MATCH FACIA,
SEE SPEC. BOOK SHEET 155

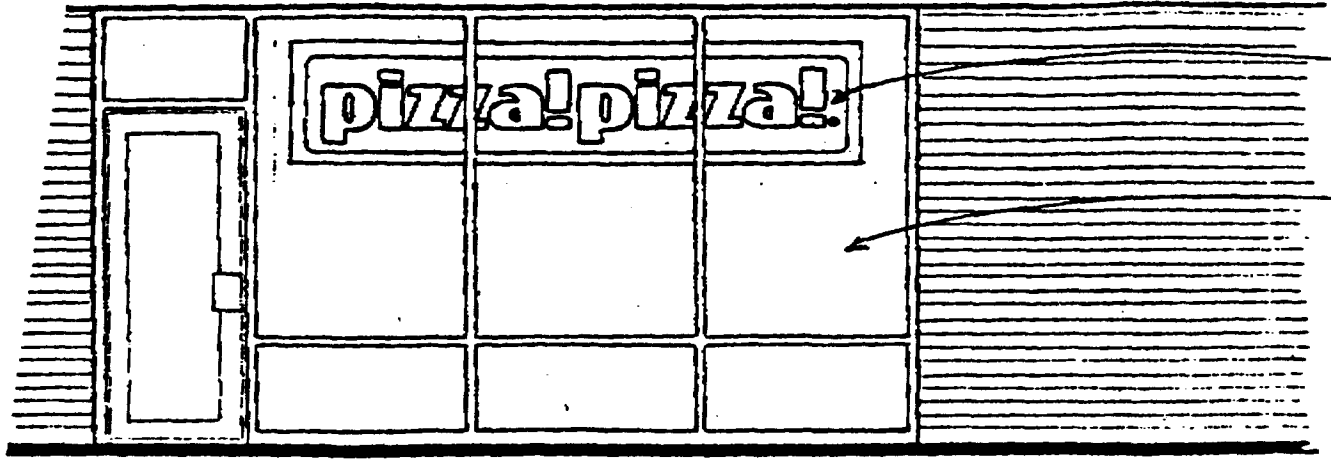

2'-6" x 12'-0" INTERIOR NEON SIGN
BY OTHERS

EXISTING STOREFRONT DOOR
& GLASS, SASH SYSTEM

FRONT ELEVATION
SCALE: 1/4" = 1'-0"

Grand Junction Sign

Business Name: *Little Caesar's*

Sign Location: *2889 N. Ave*

Type of Sign: *Wall Mount*

*Sign Permit Needed
*Date Obtained

Dimensions:

Illuminated: Type of Illumination: Interior Exterior

Sign Material: *None* Material needed:
Shipped in Sign

Art Needed: *No* Received (x if in stock)

Comments: SKETCH

Description: *Chapel letters
on Racway sketch provided
Shopping Center*

Street Frontage: Front *25'* ft.
Side ft.

Building Frontage: Front *25'* ft. *MASD*
Side ft.

Traffic Lane: Front *7* ft.
Side ft.

Total Allowed Area:
Front sq. ft.
Side sq. ft.

Clearance to Grade: ft.

Area of Existing Sign *0* sq. ft.

Estimated Completion Date

Accepted By:

TAXSCH II -
2943 - 181 - 05 - 022

George METZ
#2 COGNAC CT
81503

LOGO - 21" x 25"
Letters 21" x 13' 2.5"

$1.75 \times 2.08 = 3.64'$
 $1.75 \times 13.21 = 23.12$
26.76