

DATE SUBMITTED: Feb. 22, 1991

PERMIT # _____

TAX SCHEDULE #: 2701-364-00-110

FEE \$ 1500

SIGN PERMIT

GRAND JUNCTION PLANNING DEPARTMENT

BUSINESS NAME: STOP-N-SAVE

BUSINESS ADDRESS: 723 HORIZON DRIVE

STREET FRONTAGE: FRONT 200 FT. SIDE _____ FT.

BUILDING FRONTAGE: FRONT 56' FT. SIDE _____ FT.

TRAFFIC LANE: FRONT 4 FT. SIDE _____ FT.

HEIGHT OF SIGN: 31' FT. CLEARANCE TO GRADE: 10'8" FT.

AREA OF SIGN: 165 SQ. FT. AREA OF EXISTING SIGNS: 36 SQ. FT.

TOTAL ALLOWED AREA: FRONT 300 SQ. FT. SIDE _____ SQ. FT.


TOTAL Allowed for Freestanding = 300 #

TYPE OF SIGN

- | | |
|---|---|
| <input checked="" type="checkbox"/> ON PREMISE | <input type="checkbox"/> ROOF |
| <input type="checkbox"/> OFF PREMISE | <input checked="" type="checkbox"/> FLUSH WALL |
| <input checked="" type="checkbox"/> FREE STANDING | <input checked="" type="checkbox"/> ILLUMINATED |
| <input type="checkbox"/> PROJECTING | <input type="checkbox"/> OTHER |

COMMENTS 2 FLUSH WALL 16 # EA
1 FREE STANDING 165 #

*SKETCH

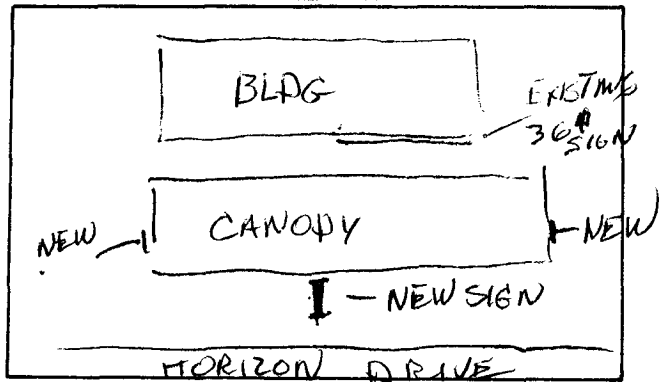

*Include: Streets, Property Lines, Proposed Sign Location.

PROPERTY OWNER: FEATHER PETROLEUM

Mark W. Smith
Signature

ADDRESS: 2492 INDUSTRIAL BLVD, G.J.

CONTRACTOR: WESTERN NEON CO.



ADDRESS: 2495 INDUSTRIAL BLVD.

PHONE: 242-7843

APPROVED BY: [Signature]

DATE APPROVED: 2-22-91

- FINAL PERMIT
- WILL REQUIRE SEPARATE PERMIT

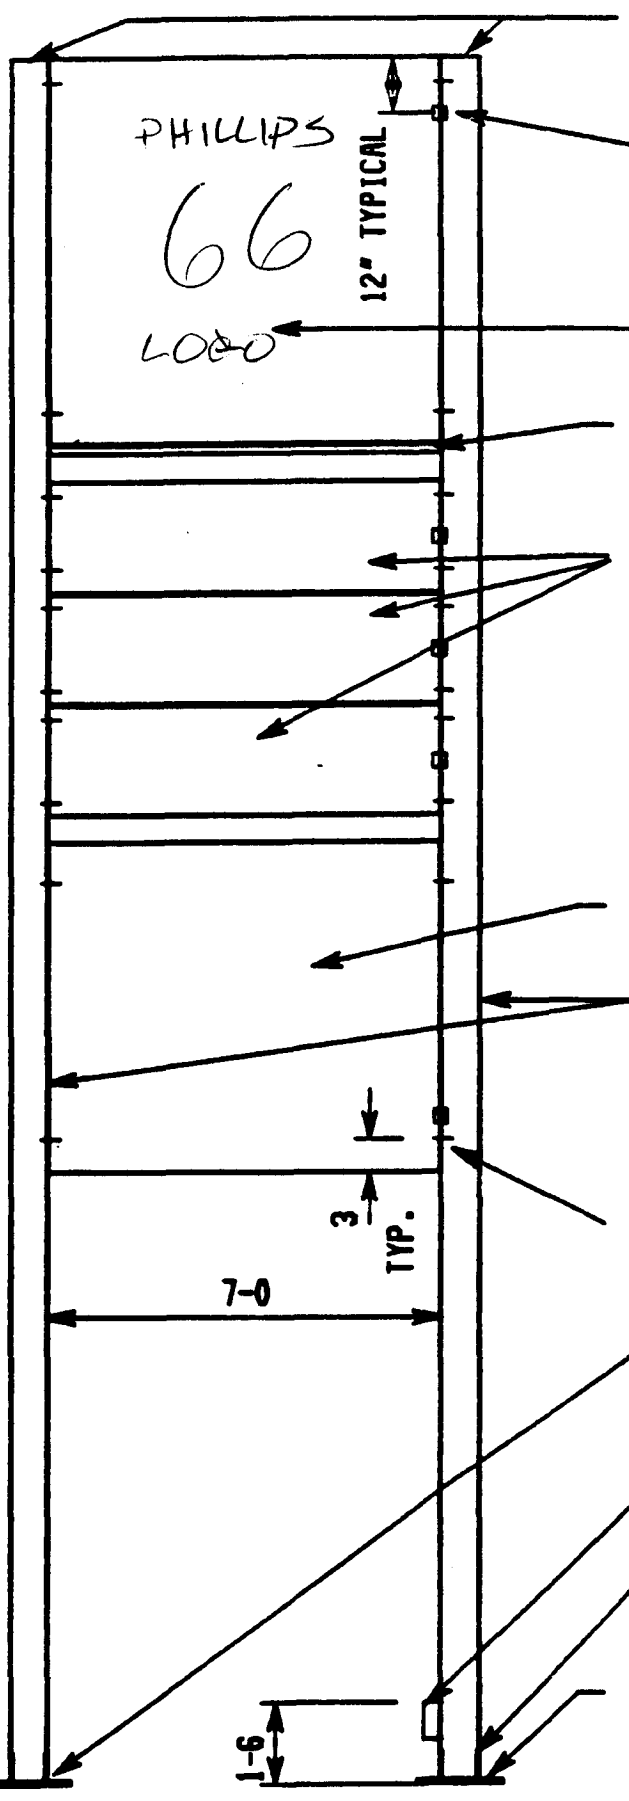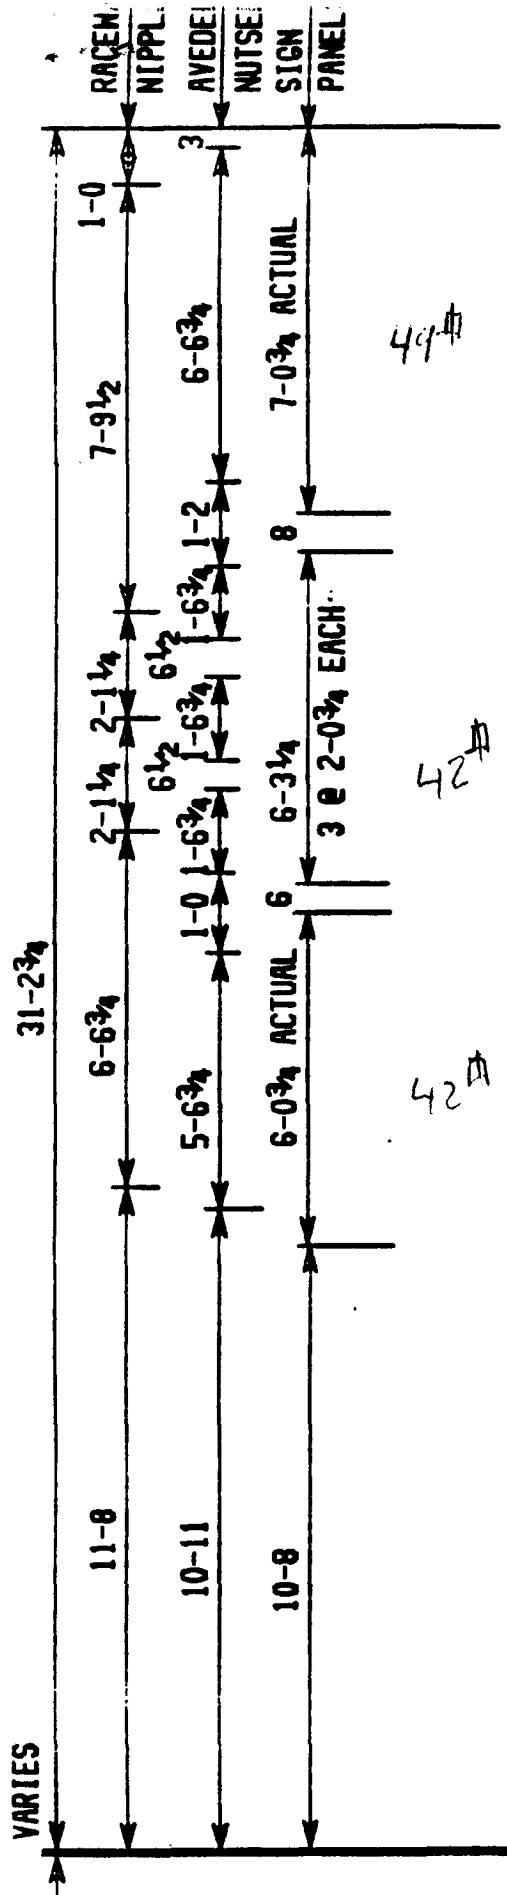

- CAP & CLEVIS (CLEVIS NOT SHOWN) SEE DWG. 2PS7X7-5
- DRILL FOR 1/2" SHORT TYPICAL ONE PER SIGN & OF POLE FACE SEE 2PS7X7-6
- 7'X7' EMBOSSED SHIELD (BY OTHERS)
- 2"X8"X1/2" T.S., SEE 2PS7X7-5
- 3 - 2'X7' MESSAGE BOARD (BY OTHERS)
- 6'X7' CHANGABLE PRICE SIGN (BY OTHERS)
- FULL LENGTH, ONE PIECE COLUMN SECTION. SEE DWG. 2PS7X7-3
- 1 PAIR 3/8" MOUNTING BRACKET- TYPICAL EACH SIGN, SEE DWG. 2PS7X7-6
- COLUMN SHALL HAVE PERMANENT WELD (ALL AROUND) TO SIGN FACE. USE BACKUP PLATE. RECD.
- JUNCTION BOX W/ REINFORCED HOLE (BY POLE FABRICATOR)
- GUSSETS PERPENDICULAR TO SIGN FACE SEE DWG. 2PS7X7-5
- BASE PLATE- SEE DWG. 2PS7X7-4

STRUCTURAL ELEVATION

NO SCALE

49
42
42
133 #
B0038

~~247~~ 165

2PS
2-1-