

DATE SUBMITTED: 4-30-91

PERMIT # _____

TAX SCHEDULE #: 2945-123-03-028 (024)

FEE 225

SIGN PERMIT

GRAND JUNCTION PLANNING DEPARTMENT

WALL SIGN - \$15
GROUND SIGN - \$10
\$25 total

BUSINESS NAME: Payless Drug

BUSINESS ADDRESS: 12th & Orchard 1834 N. 12th

STREET FRONTAGE: FRONT _____ FT. SIDE _____ FT.

BUILDING FRONTAGE: FRONT 180 FT. SIDE _____ FT.

TRAFFIC LANE: FRONT _____ FT. SIDE _____ FT.

HEIGHT OF SIGN: existing ground 40'7" FT. CLEARANCE TO GRADE: 27'6" FT.


AREA OF SIGN: 154 SQ. FT. AREA OF EXISTING SIGNS: 90 SQ. FT.
copy change Joint I.D.

TOTAL ALLOWED AREA: FRONT 360 SQ. FT. SIDE _____ SQ. FT.

TYPE OF SIGN

*SKETCH

- ON PREMISE
- OFF PREMISE
- FREE STANDING
- PROJECTING
- ROOF
- FLUSH WALL
- ILLUMINATED
- OTHER

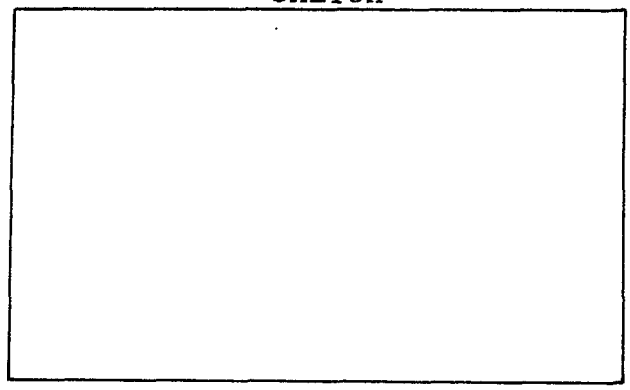

COMMENTS see Attached print

*Include: Streets, Property Lines, Proposed Sign Location.

PROPERTY OWNER: Payless Drug

ADDRESS: _____

Debra Raming
Signature

CONTRACTOR: Gordon Sign Co.


ADDRESS: 2930 W 9th Ave
Denver, CO 80204

PHONE: 629-6121


APPROVED BY: [Signature]
DATE APPROVED: 6/1/91

- DARREL BOND
BOND SIGN CO.
1804 245 RD
NEW CASTLE CO. 81647

- FINAL PERMIT
- WILL REQUIRE SEPARATE PERMIT

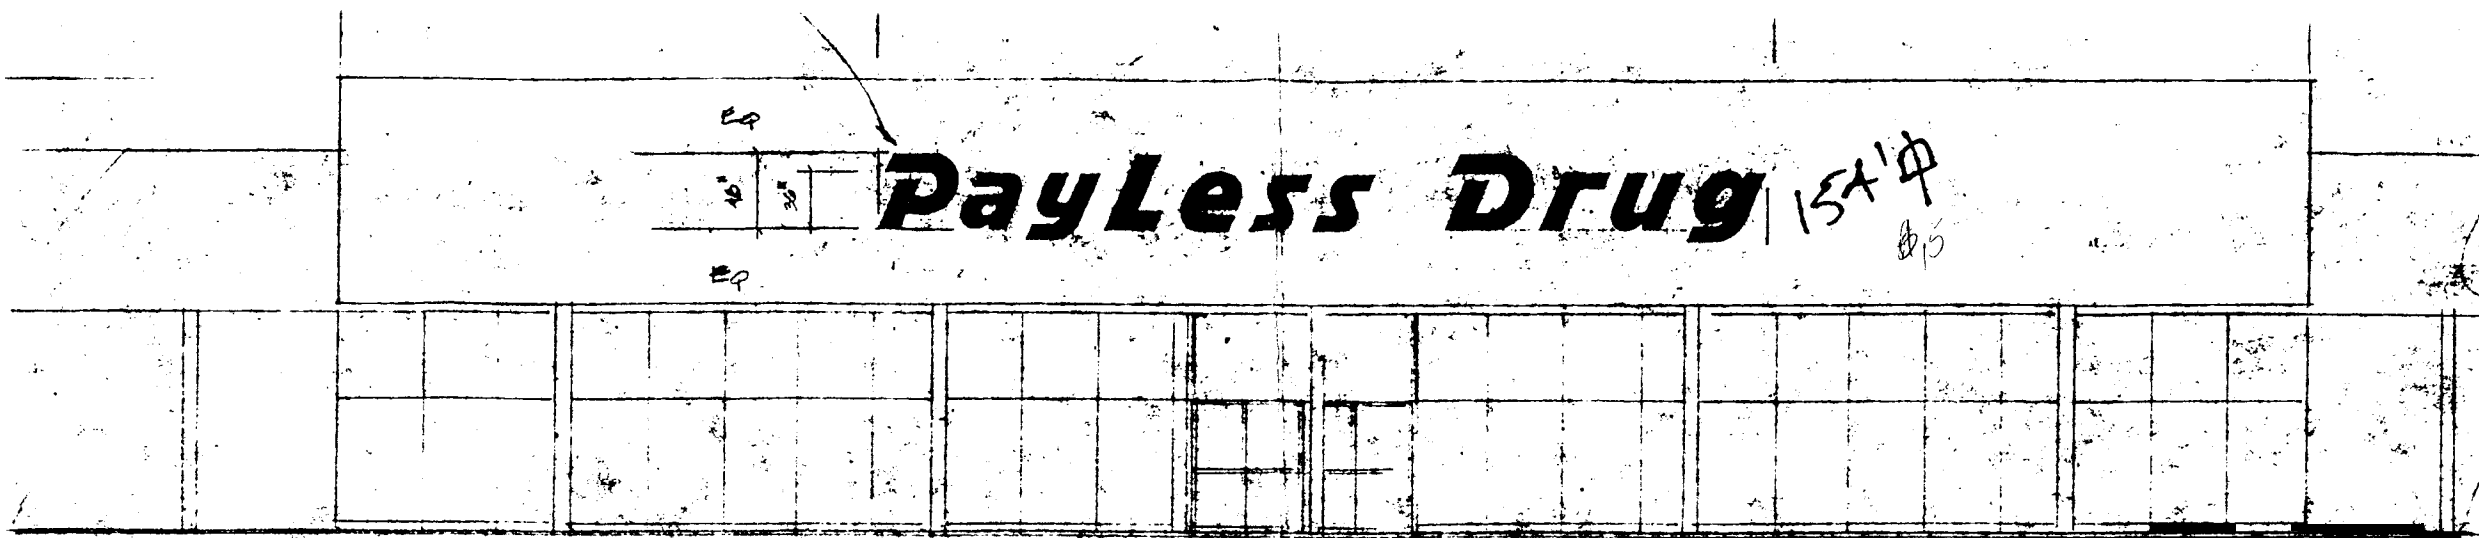

M.P.L.C. INSTALL (1) SET 36" TO 48" IN DIA. ILLUMINATED CHANNEL-LINE LIGHTS WITH BULB CONTAINED TRANSFORMERS 10" x 10"

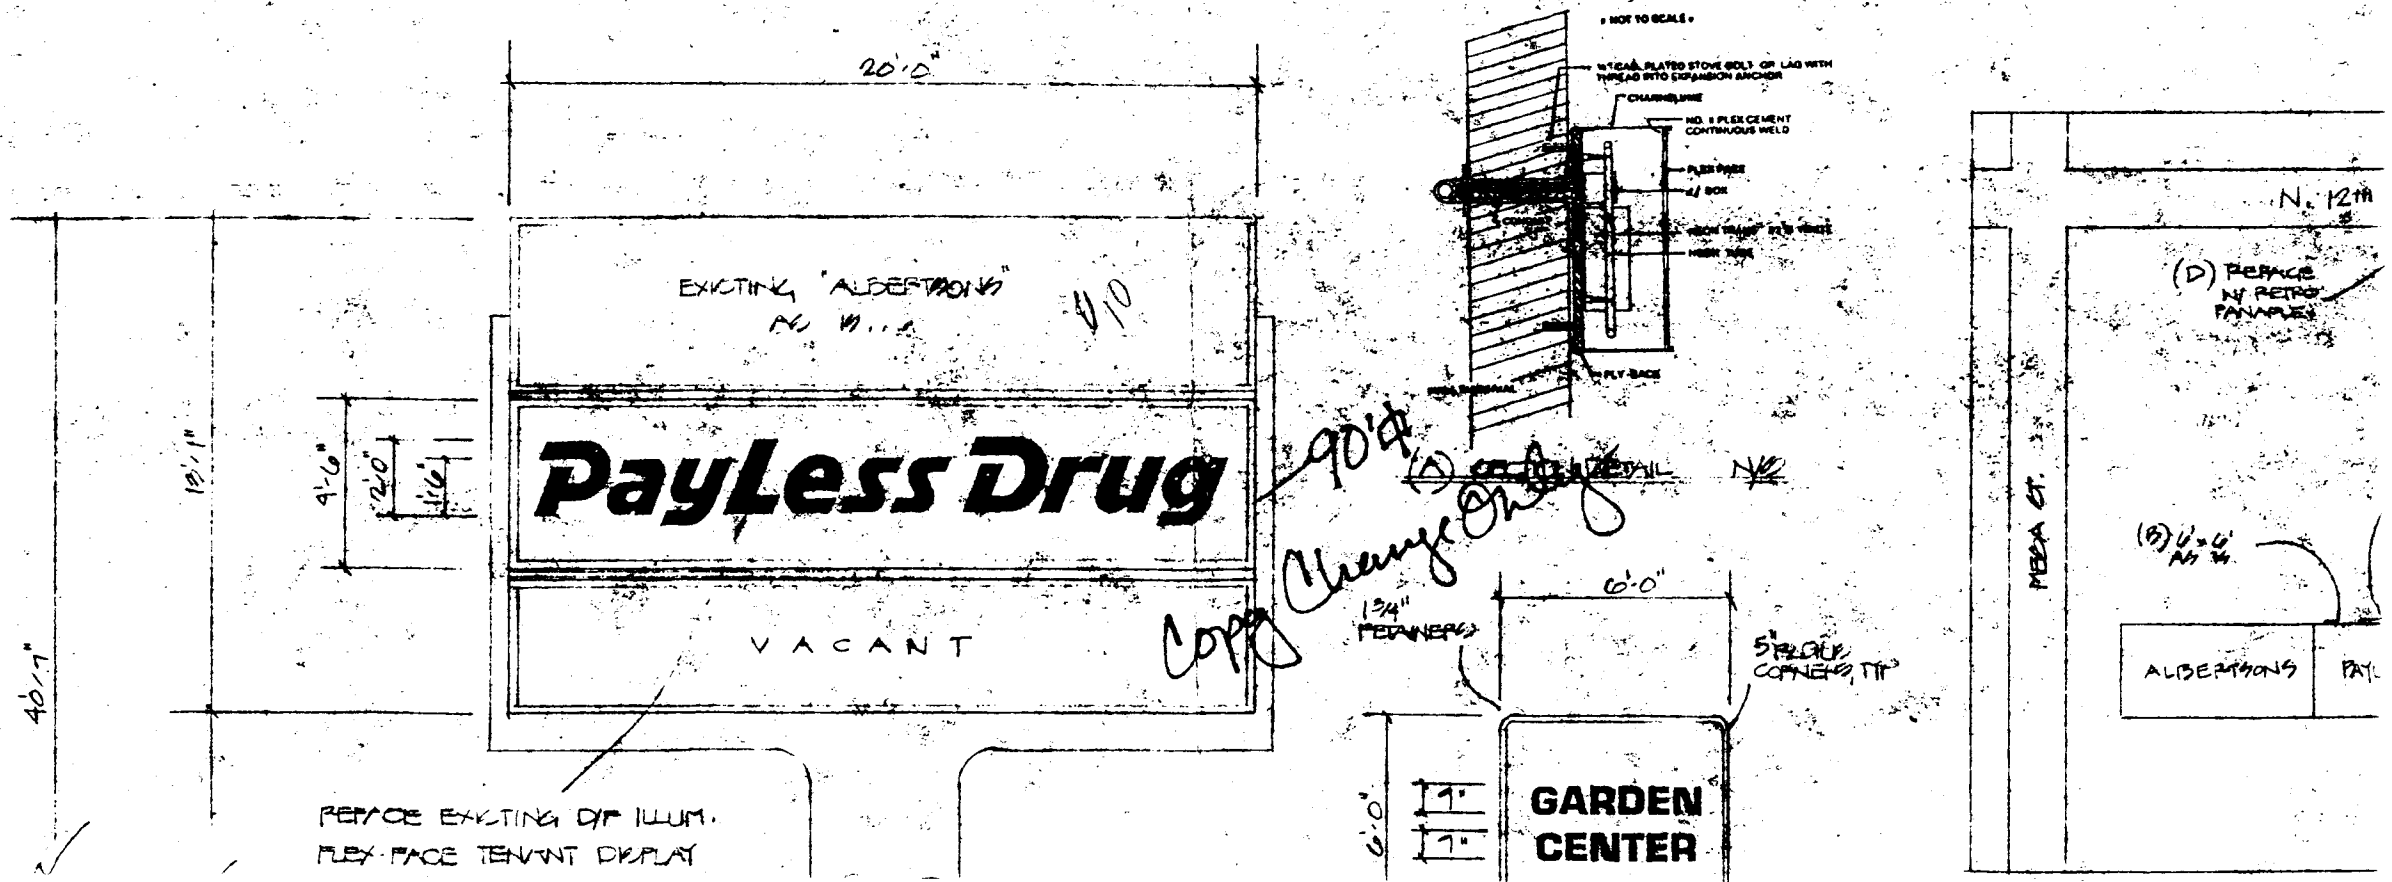

REPLACE EXISTING OP. ILLUM. FLEX-FACE TENANT DISPLAY

GARDEN CENTER

ALBERTSONS PAYL