

Date Submitted: 7/20/91

Permit #

Zone: C-1

Fee \$ 15.00

Tax Schedule: 2943 073 00 155

Requires Building Department Permit

# SIGN PERMIT

## GRAND JUNCTION COMMUNITY DEVELOPMENT

BUSINESS NAME: AUTO ZONE CONTRACTOR: FENTON SIGNS  
 BUS. ADDRESS: 2848 NORTH AVE ADDRESS: 2880 I-70 BUS LOOP  
 PROPERTY OWNER: SAME TELEPHONE NO: 243-8629  
 OWNER ADDRESS: \_\_\_\_\_ LICENSE NO: 2910347

- 1. FLUSH WALL (2 square feet per linear foot of building facade)
- 2. ROOF (2 square feet per linear foot of building facade)
- 3. FREE-STANDING (2 traffic lanes .75 square feet. x street frontage)  
(4 or more traffic lanes 1.5 square feet x street frontage)
- 4. PROJECTING (.5 square feet per each linear foot of building facade)
- 5. OFF PREMISE (See #3 Spacing Requirements; 300 square feet < 15 square feet)

EXTERNALLY ILLUMINATED  INTERNALLY ILLUMINATED  NON-ILLUMINATED

(1-5) Area of Proposed Sign \_\_\_\_\_ Square Feet 1 - Pole Sign - 180 Sq FT  
1 - FLUSH WALL - 100 Sq FT  
 (1,2,4) Building Facade \_\_\_\_\_ Square Feet  
 (1-4) Street Frontage 150 Feet  
 (2,4) Height to top of Sign 28' Feet Clearance to Grade 18 Feet  
 (1-5) Maximum Allowed Area \_\_\_\_\_ Square Feet.  
 (5) Distance From All Existing Off-Premise Signs within 600 Feet \_\_\_\_\_ Feet


### EXISTING SIGNAGE / TYPE:

\_\_\_\_\_ Square Feet  
 \_\_\_\_\_ Square Feet  
 \_\_\_\_\_ Square Feet  
 \_\_\_\_\_ Square Feet **TOTAL EXISTING** -0- Square Feet


COMMENTS: \_\_\_\_\_

**NOTE:** No sign may exceed 300 square feet. A separate sign permit is required for each sign. Attach a sketch of proposed and existing signage including types, dimensions, lettering, abutting streets, property lines, and locations. Free standing signs over 25 feet high, all roof signs, and illuminated signs require a separate permit from the Building Department.

Fenton Signs 7/20/91 Christen L. Abbeduto 7/19/91  
 APPLICANT'S SIGNATURE DATE APPROVED BY DATE

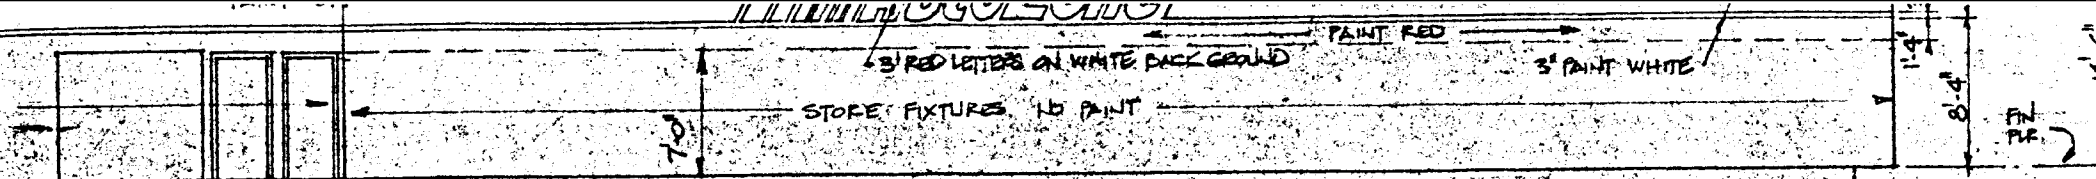

ST WALL 1/8" = 1'-0"

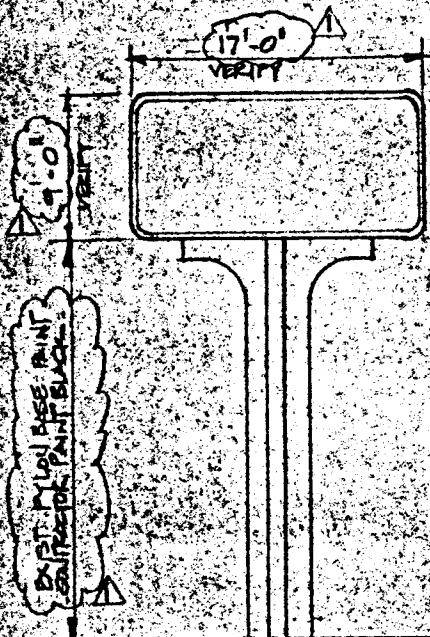

Red Letters - Orange Stripes - White Background,  
 On One Piece, Pan Formed Lexon with Letters  
 And Stripes Embossed - Color Not Embossed, Pan Formed.



White, Model Style Letters, Non-  
 Embossed For Discount Auto  
 Parts, Black Background,  
 Black Metal Frame

NOTE: Manufacture faces from Camera  
 Ready Art Work Only.

ALTERNATE SIGN FACES: FLEX FACE,  
 MANUFACTURERS,  
 COBLEY,  
 SIENTER,  
 PALPTEX

**NOTE:**

ALL PAINT BY SPRAYLAY CORPORATION, AVAILABLE  
 FROM REESE SUPPLY CO. 3308 ROYALTY  
 ROW, IRVING, TEXAS, 75002.  
 PHONE: 214-638-3131, 1-800-977-7553  
 JOHN STUART, JOHN WILLIAMS OR DAN BLAIR

**PAINT SPECIFICATIONS - SIGN FACES:**

AUTOZONE RED - LACRYL 19-5347  
 AUTOZONE ORANGE - LACRYL 19-5340  
 MATTE BLACK - LACRYL 481-BK  
 WHITE - LACRYL 403-W

**PAINT SPECIFICATIONS - METAL CABINET:**

RED - SERIES 30-1702  
 ORANGE - SERIES 30-1700  
 WHITE - SERIES 30-01  
 BLACK - SHERWIN WILLIAMS INDUSTRIAL ENAMEL  
 B-94 B11 GLOSS BLACK

**GENERAL NOTES**


1. REFRESH ELECTRICAL IF REQ'D & RELAMP SIGN.
2. MODIFY EXISTING CABINET & TRIM TO ACCOMMODATE NEW SIGN FACES.
3. FURNISH & INSTALL NEW SIGN FACES AS SHOWN.
4. PAINT SUPPORT BLACK ALL SURFACES.
5. SEE SH. A-5 FOR ADDITIONAL SIGN NOTES.

EXISTING PYLON SIGN

**NOTE:**  
 REMOVE EXISTING SIGN CABINETS ON SLOPED  
 PLUMB. FASCIA PRIOR TO INSTALLING CHANNEL LETTERS

CHANNEL LETTERS 2" RETURN W/ INTERNAL FBKM TRANSFORMERS  
 & 15MM CLEAR NEON TUBING PUMPED RED. FACES TUBE ACRYLIC  
 RED FLEXIGLAS # 2285 W/ BLACK URETHANE TRIM.  
 PRIMARY TO CONNECT BEHIND THE LETTERS & NOT VARY FROM END TO END.  
 ALL STRUCTURE BEHIND TO SUPPORT LETTERS SHALL BE DESIGNED & INSTALLED  
 BY SIGN CONTRACTOR & PAINTED TO MATCH WALL. (SEE SHEET A-5)

FOR ADDITIONAL NOTES & INFORMATION

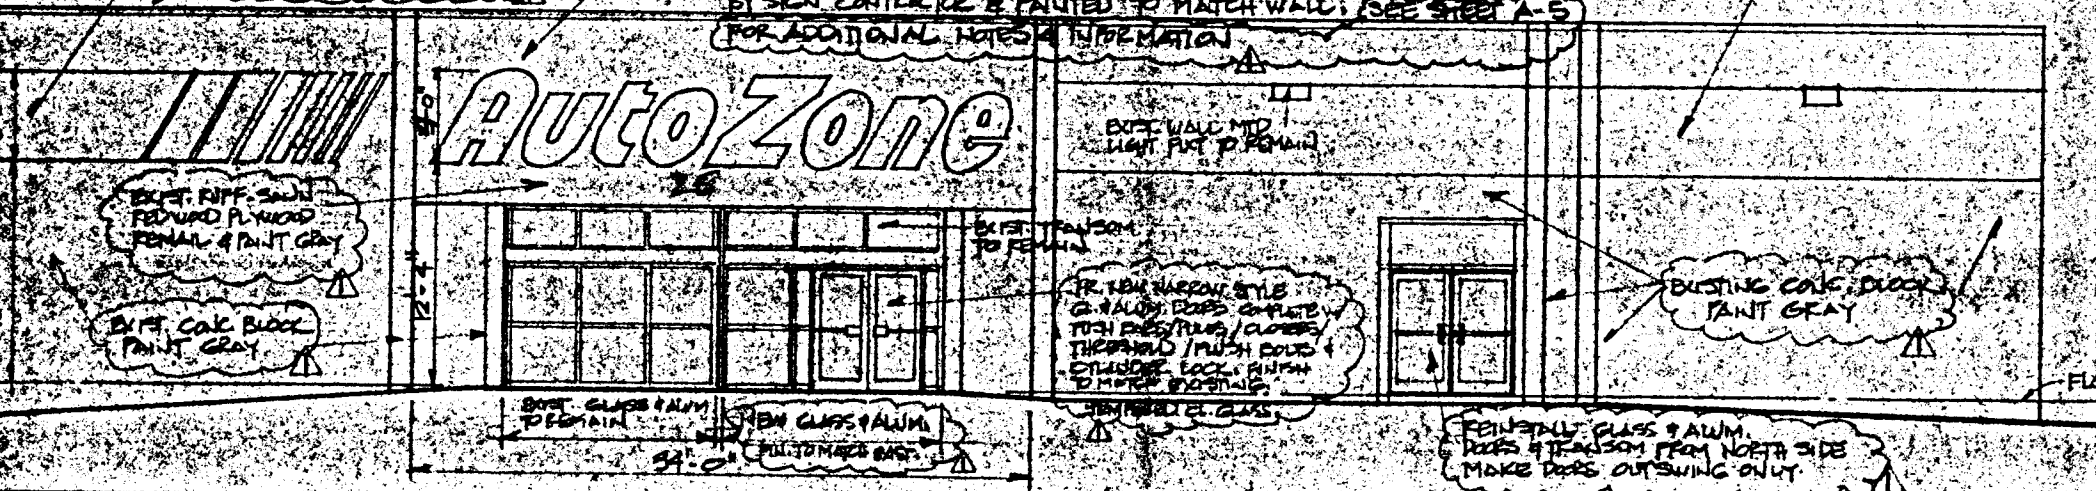

ORANGE PAINTED STRIPE  
 EXIST. MET. FLASHING PAINT BLACK

ORANGE PAINTED STRIPE

EXIST. RUFF. SAWD  
 REDWOOD PL. WOOD  
 PENAIL & PAINT GRAY

EXIST. CONC. BLOCK  
 PAINT GRAY

EXIST. GLASS & ALUM.  
 DETRAIN

EXIST. GLASS & ALUM.  
 DETRAIN

EXIST. TRANSOM  
 TO REMAIN

FR. NEW WAREHOUSE STYLE  
 G. ALUM. DOORS COMPLETE  
 WITH INSULATION / CLOSERS  
 THRESHOLD / MUSH DOGS &  
 OUTSIDE LOCK. FINISH  
 TO MATCH EXISTING.

EXISTING CONC. BLOCK  
 PAINT GRAY

FINISH ALL GLASS & ALUM.  
 DOORS & TRANSOM FROM NORTH SIDE  
 MAKE DOORS OUTSWING OUT.

SOUTH ELEVATION SCALE 1/8" = 1'-0"

EXIST. METAL FLASHING PAINT BLACK

EXIST. WALL HTD.  
 LIGHT FIXT. TO  
 REMAIN

EXIST. RUFF. SAWD  
 REDWOOD PL. WOOD  
 PENAIL &  
 PAINT GRAY

EXIST. BRACKET  
 LIGHT FIX.

EXISTING CONCRETE BLOCK  
 PAINT GRAY

17'-0"  
 20'-8"