


## SIGN PERMIT

Community Development Department 250 North 5th Street
Grand Junction, CO 81501

PERMIT NO	
Date Submitted 10-26-9	35\/
FEE \$ <u>25.00</u>	V
Tax Schedule 2945-151	1-00-107
Zone	

STREET REPRESE	) 	S 1055 UTE	US
[ ] 1. FLUSH WALL [ ] 2. ROOF 3. FREE-STANDING [ ] 4. PROJECTING [ ] 5. OFF-PREMISE [ ] Externally Illuminated	2 Square Feet per Linear F 2 Square Feet per Linear F 2 Traffic Lanes - 0.75 Square Traffic Lanes - 1 0.5 Square Feet per each L	oot of Building Facade oot of Building Facade are Feet x Street Frontage 1.5 Square Feet x Street Frontage inear Foot of Building Facade arts; Not > 300 Square Feet or	e
(1 - 5) Area of Proposed Sign (1,2,4) Building Facade (2,2)  (1 - 4) Street Frontage (2,4,5) Height to Top of Sign (5) Distance from all Existin	Linear Feet Sou Linear Feet  21 Feet Cleara	nce to Grade $\frac{15^{-6}}{6}$	Feet Feet
Existing Signage/Type  FLUSH WAU (Sourn)  Total Existing:	36.75 Sq Ft Sq Ft Sq Ft Sq Ft Sq Ft Sq Ft	FOR OFFICE USE  Signage Allowed of Building	on Parcel Sq Ft Sq Ft
NOTE: No sign may exceed 300 a sketch of proposed and existing seasements, property lines, and 1 Department.	square feet. A separate signage including types, o	sign permit is required for limensions, lettering, abut quire a separate permit f	ting streets, alleys,

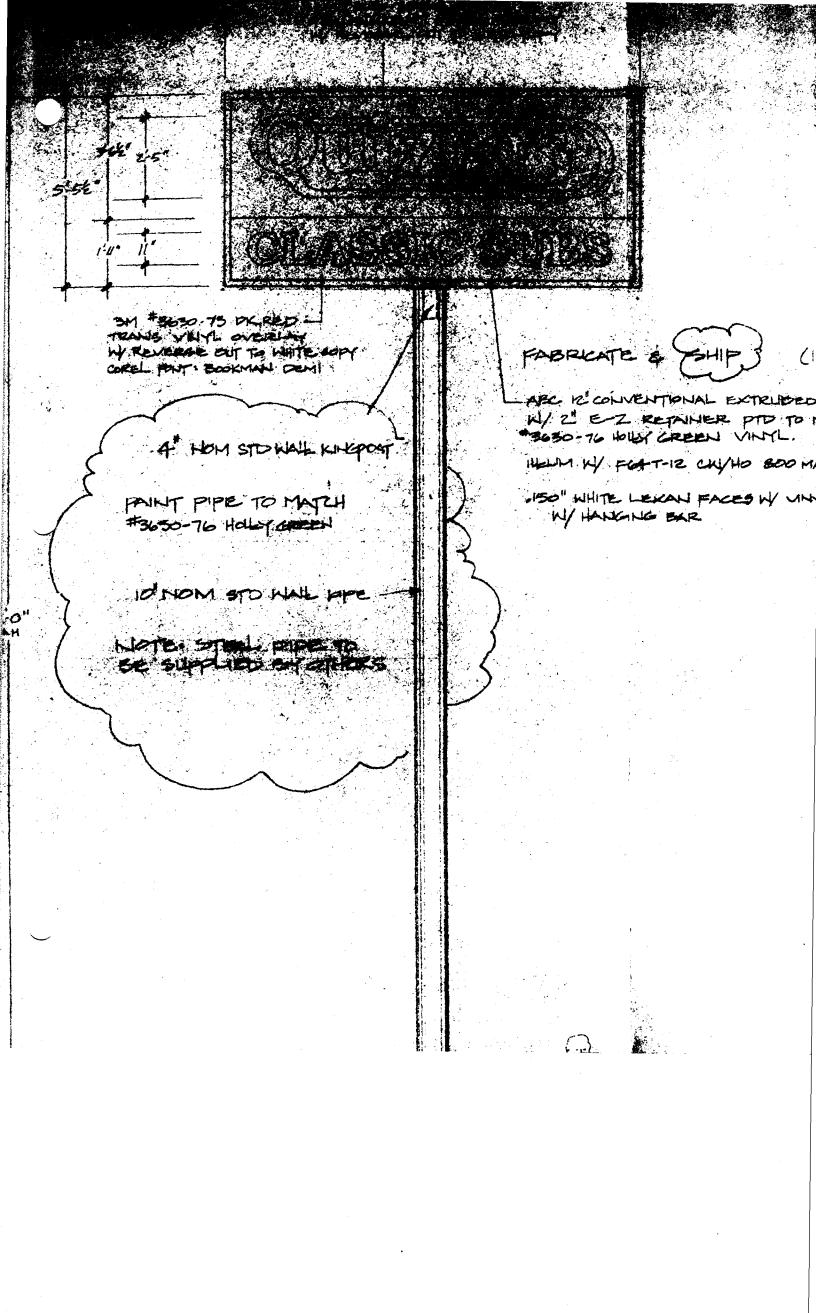

517 N. 15T.

## CLASSIC SUBS

3' RETURNE PAINTED #318 BRONZETONE GEMI-GLOGG
INTERIOR PAINTED TO MATCH #3690-76 HOLLY GREEN VINYL (PMC 257)

15 MM VEED GREEN PROSED WHAT I WAM (1-2 TIBE) COMA

CLASSIC SUPE OHT/MIT - OPEN-FICE PANICIANIUM LETTING

3" RETURNS PAINTED # 313 ENONCETONE SEMI-GLASS

INTERIOR PAINTED TO MATCH #2620-73 DIC REED VINITLE SEMI-MATCH

IOMM CLEAR REP EXPOSED NEON HELLM (1. TUBE) BOMA